
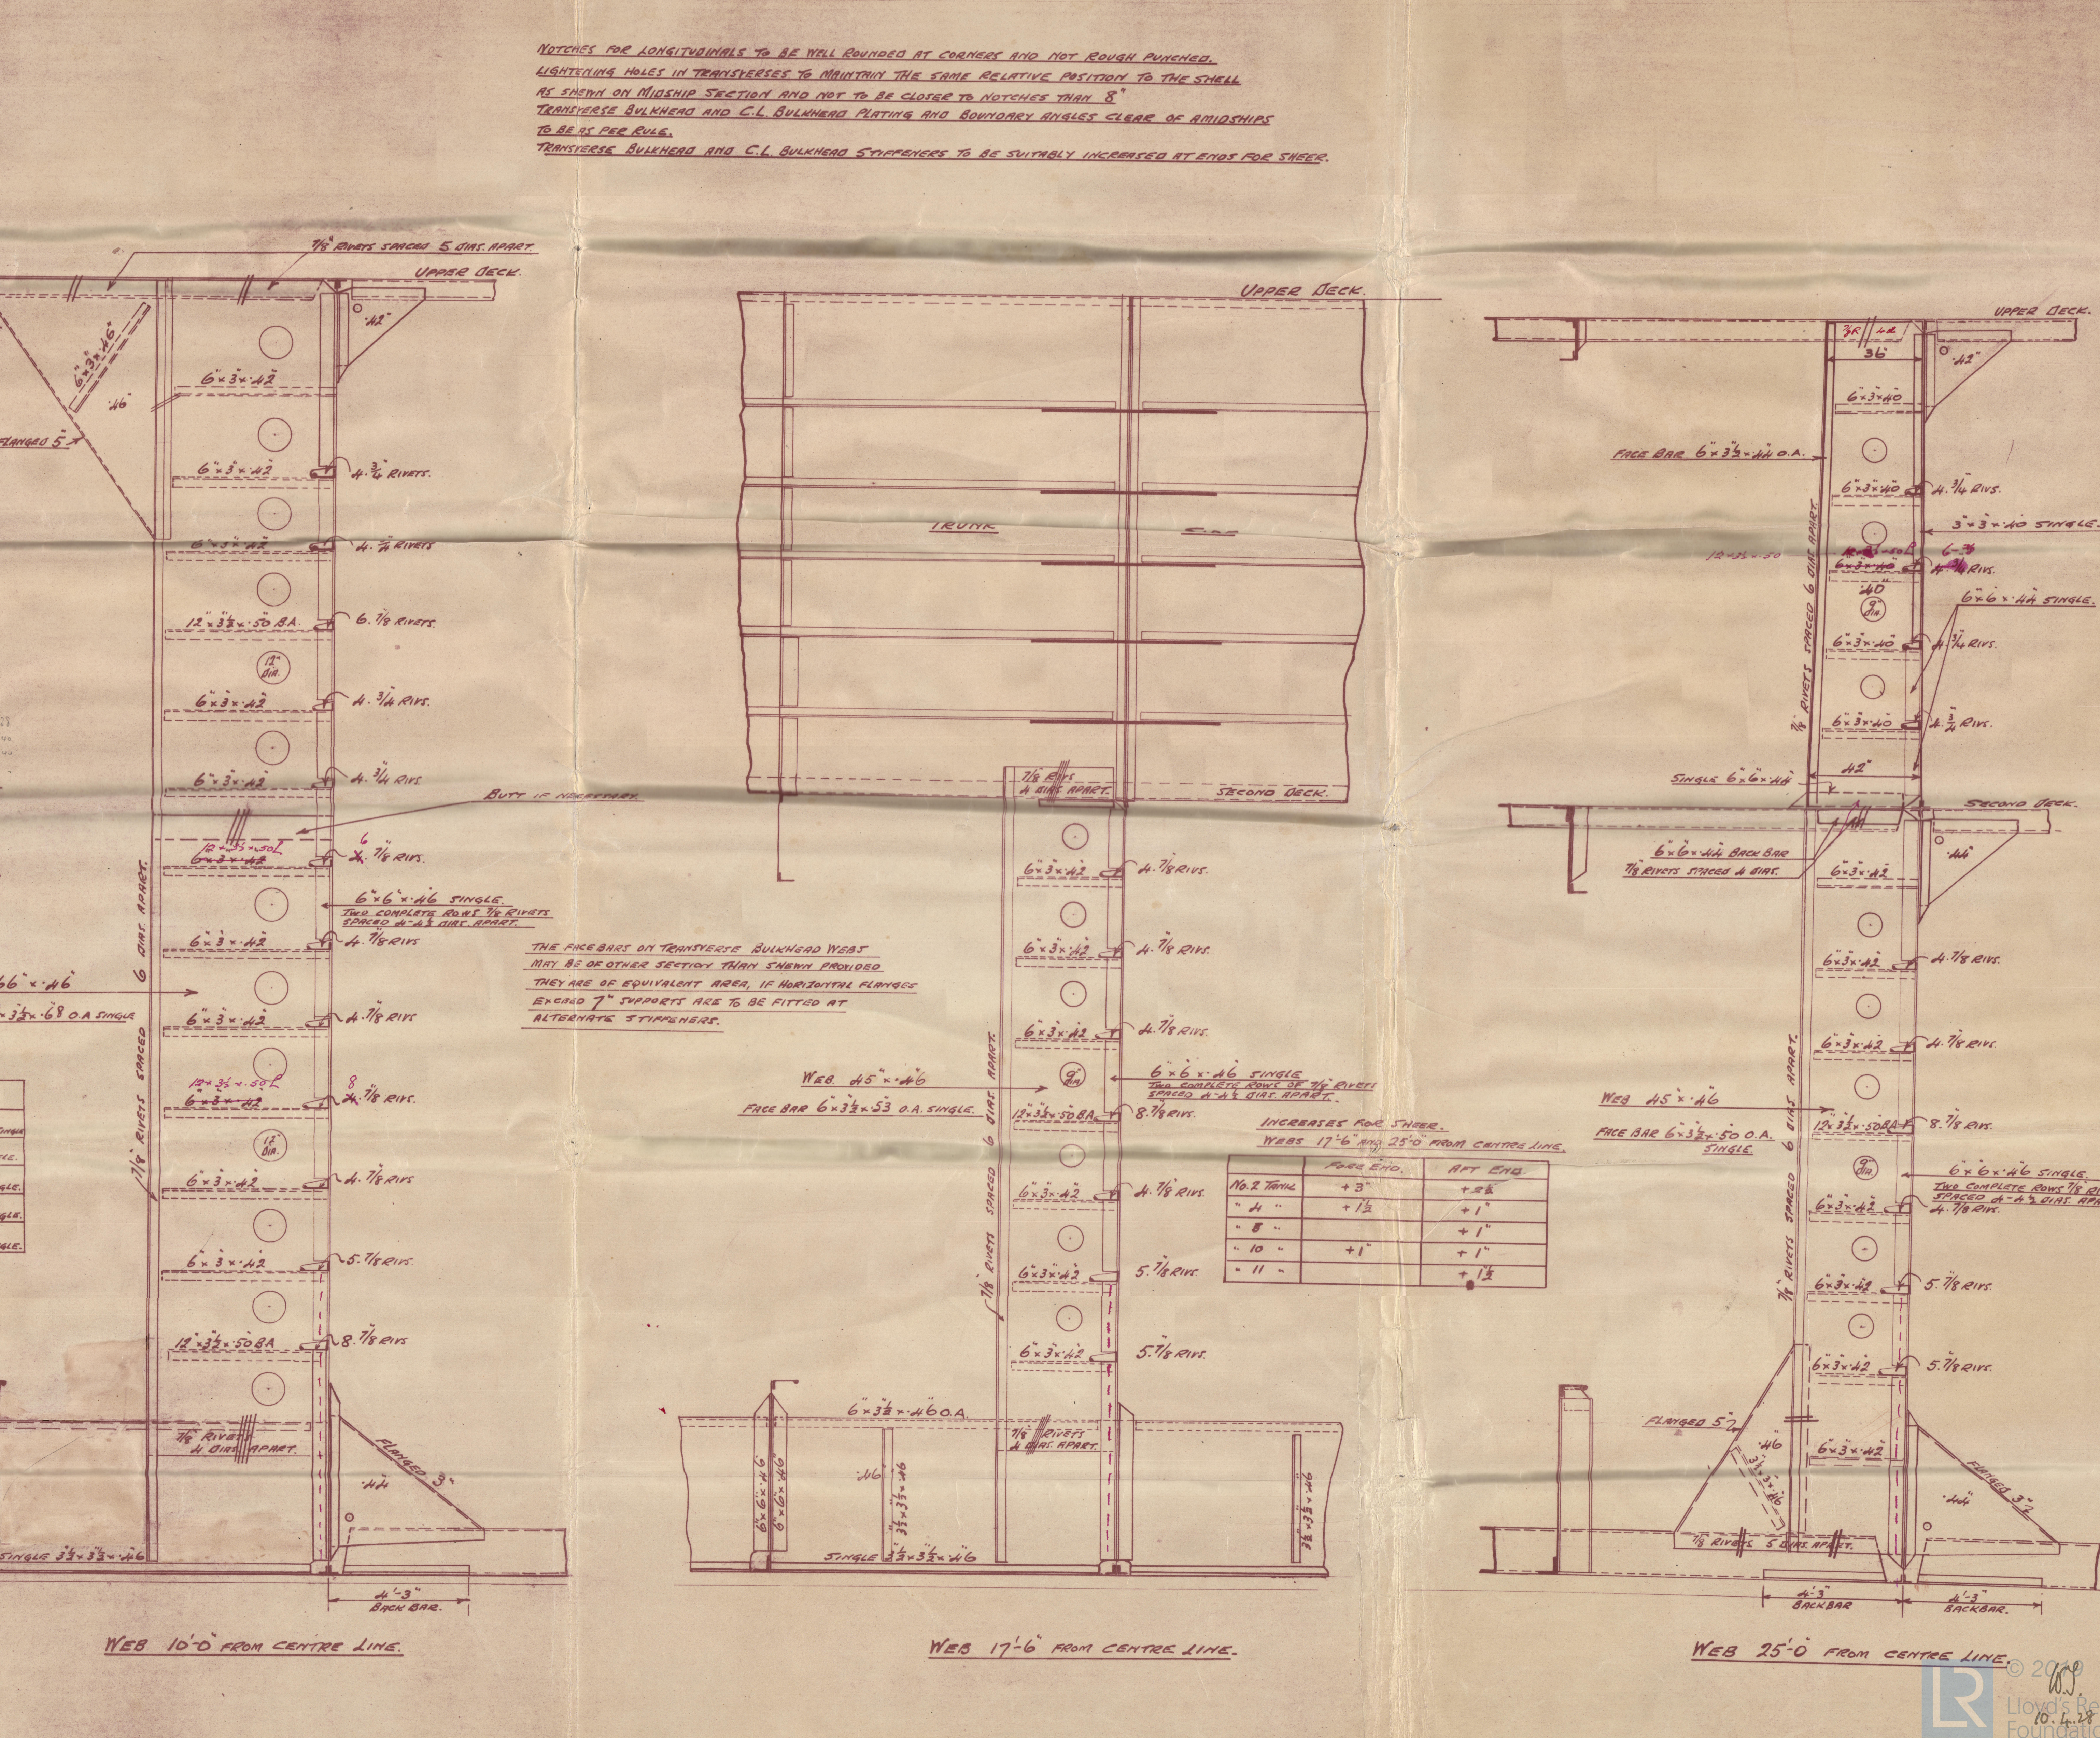


SHIP No. 137.
DIMENSIONS: 525'-0" L.B.P. x 68'-6" B.M. x 39'-0" D.M.
MIDSHIP SECTION & O.T. TRANSVERSE BULKHEAD.
SCALE 1/2" = ONE FOOT.
SPECIAL NOTATION 'LONGITUDINAL FRAMING'.
TO CLASS LLOYDS 100 A.I. CARRYING PETROLEUM IN BULK.
EQUIPMENT TO RULE.

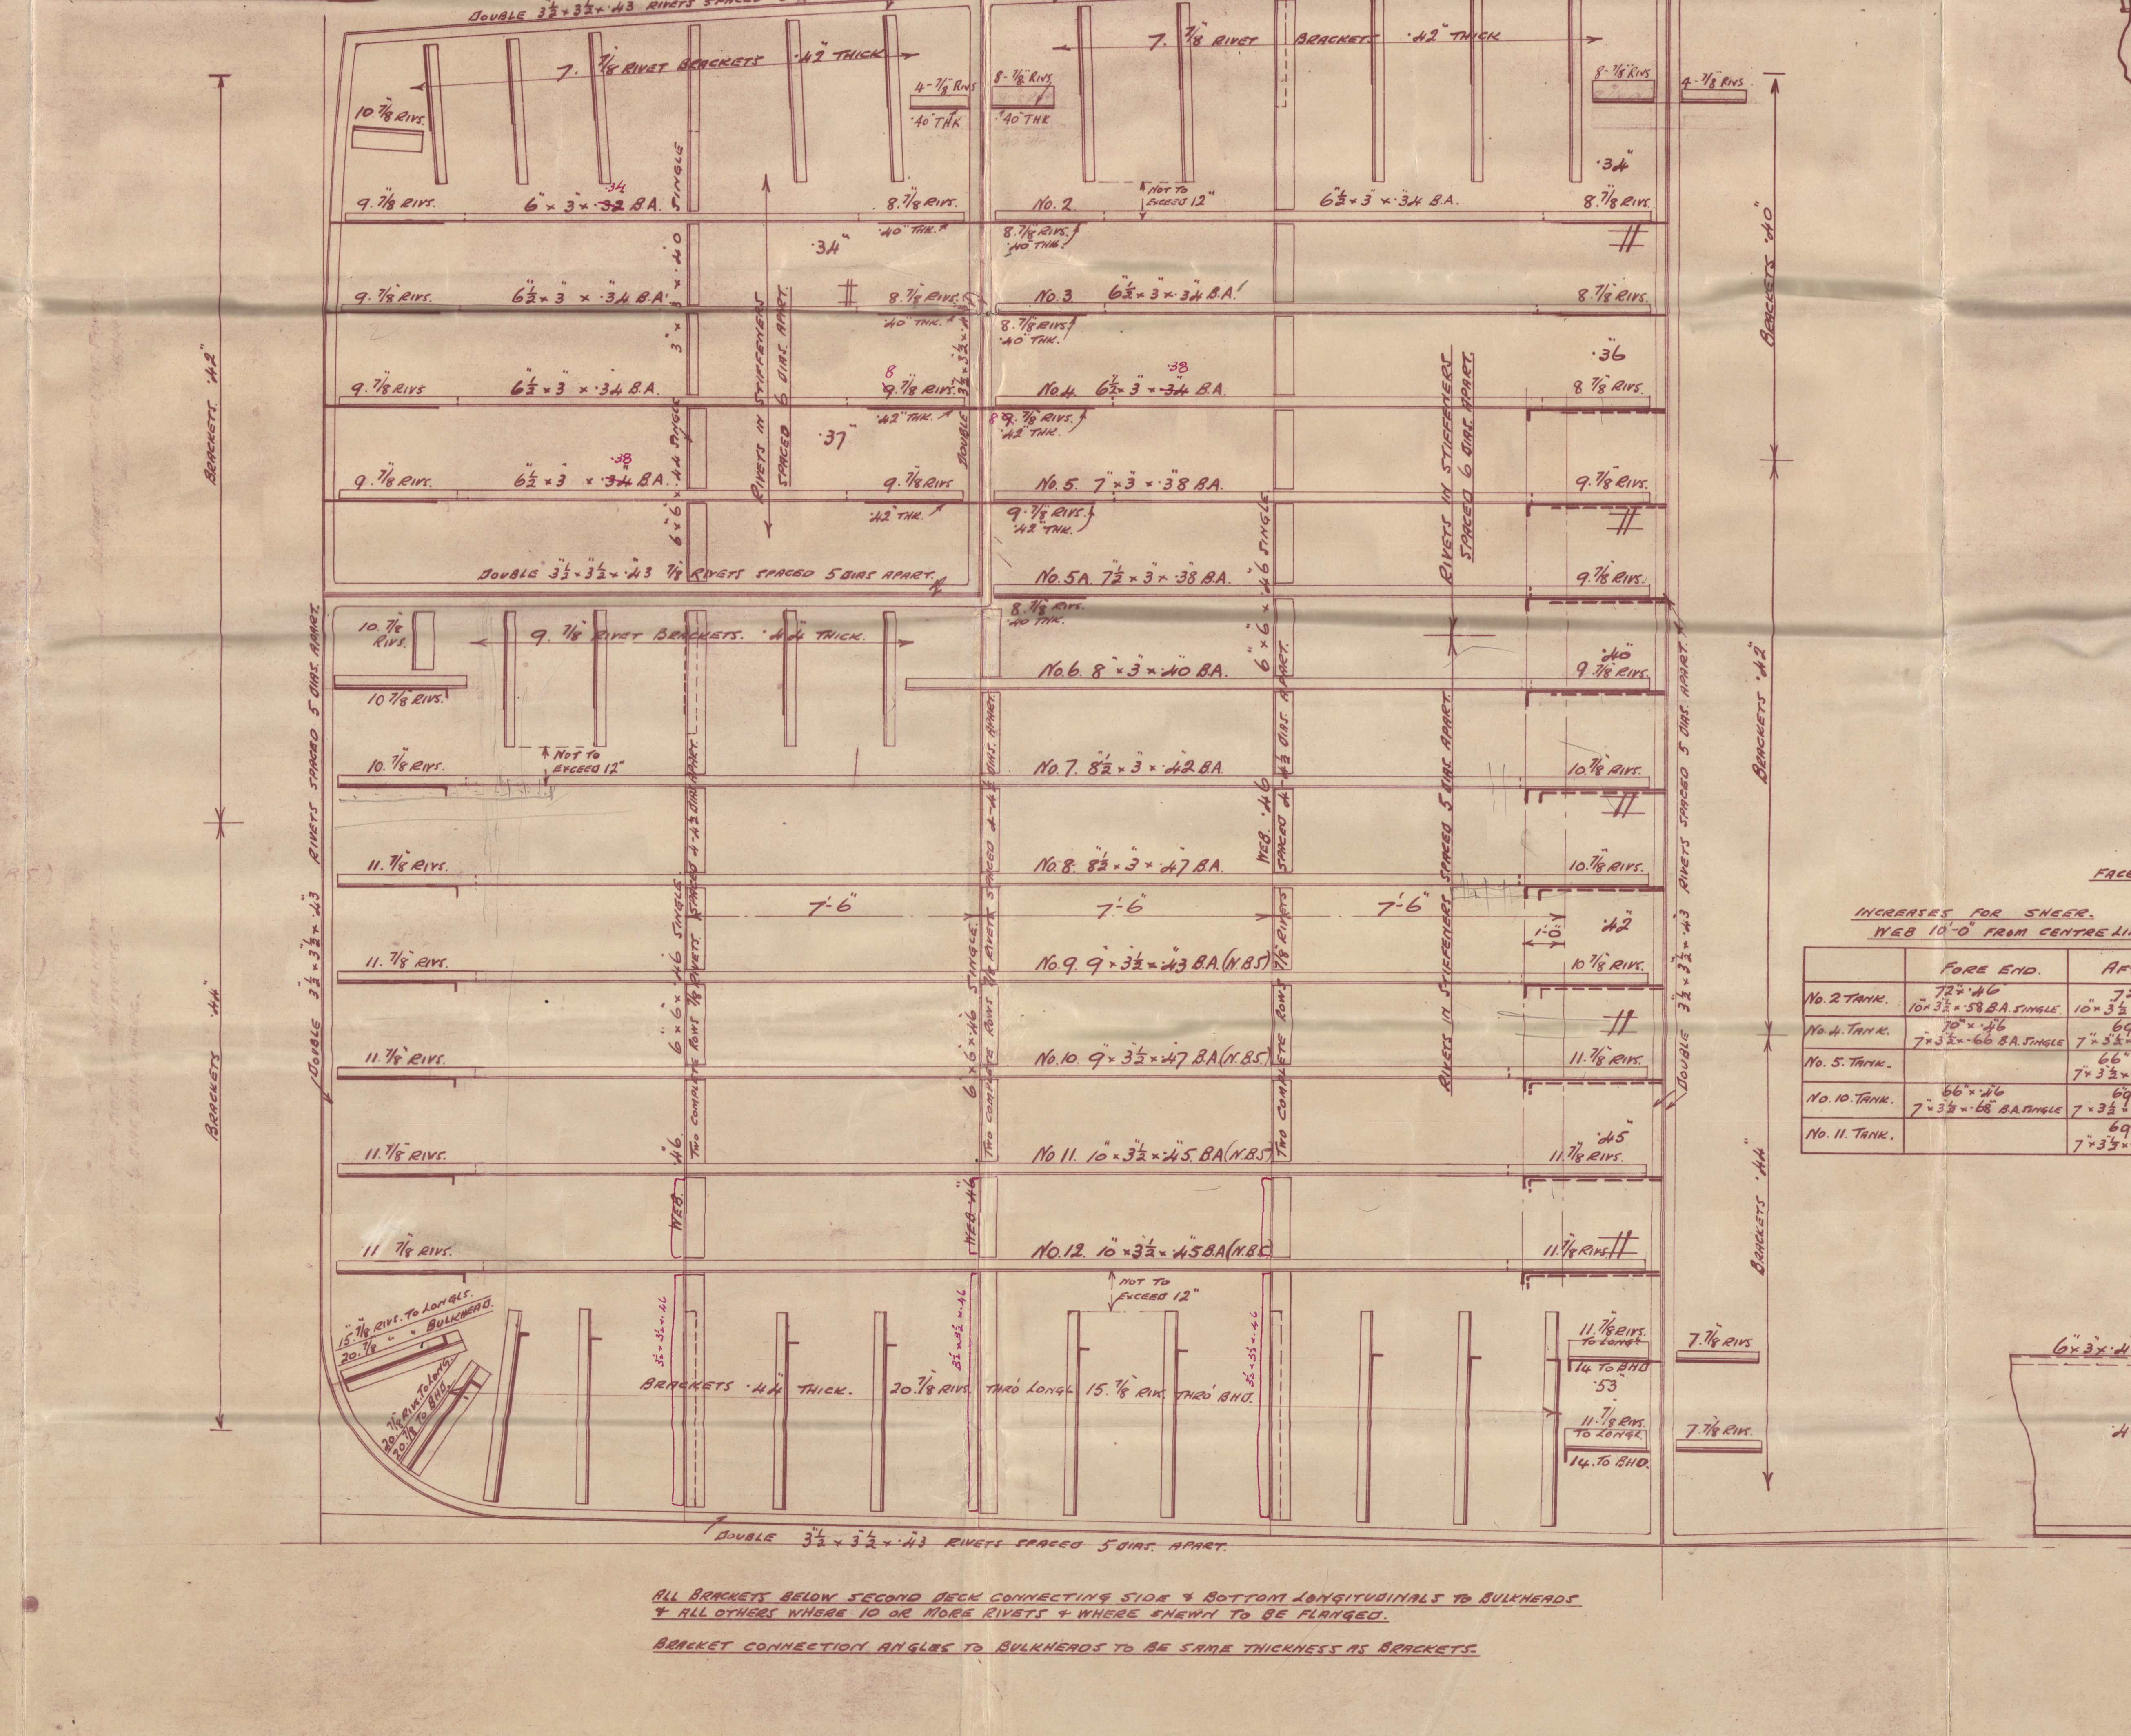

Furness. S. B. & Co. Ltd.

(2)

No 137

MIDSHIP SECTION


+

O.T. TRANSVERSE BH⁰

525.0 x 68.6 x 39.0

Carrying Petroleum in Bulk

Longitudinal Framing

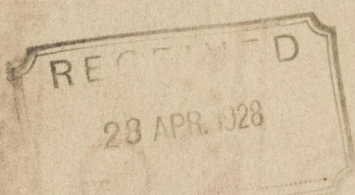

See. Elev. plans.

S.S. Athalcrown
MDB. RPT. No. 13781



© 2019

Lloyd's Register
Foundation

W6-0048