

Nº 704.

CUTTER SUCTION DREDGER.


PROFILE & DECK PLAN.

Dimensions:- 164'-0" x 41'-0" x 10'-0".

To Class Lloyds A.1. Steel "Dredger" (River Service.)

Scale $\frac{1}{8}" = \text{One Foot.}$ See letter

W. SIMONS & CO. LTD
LONDON WORKS,
RENFREW.

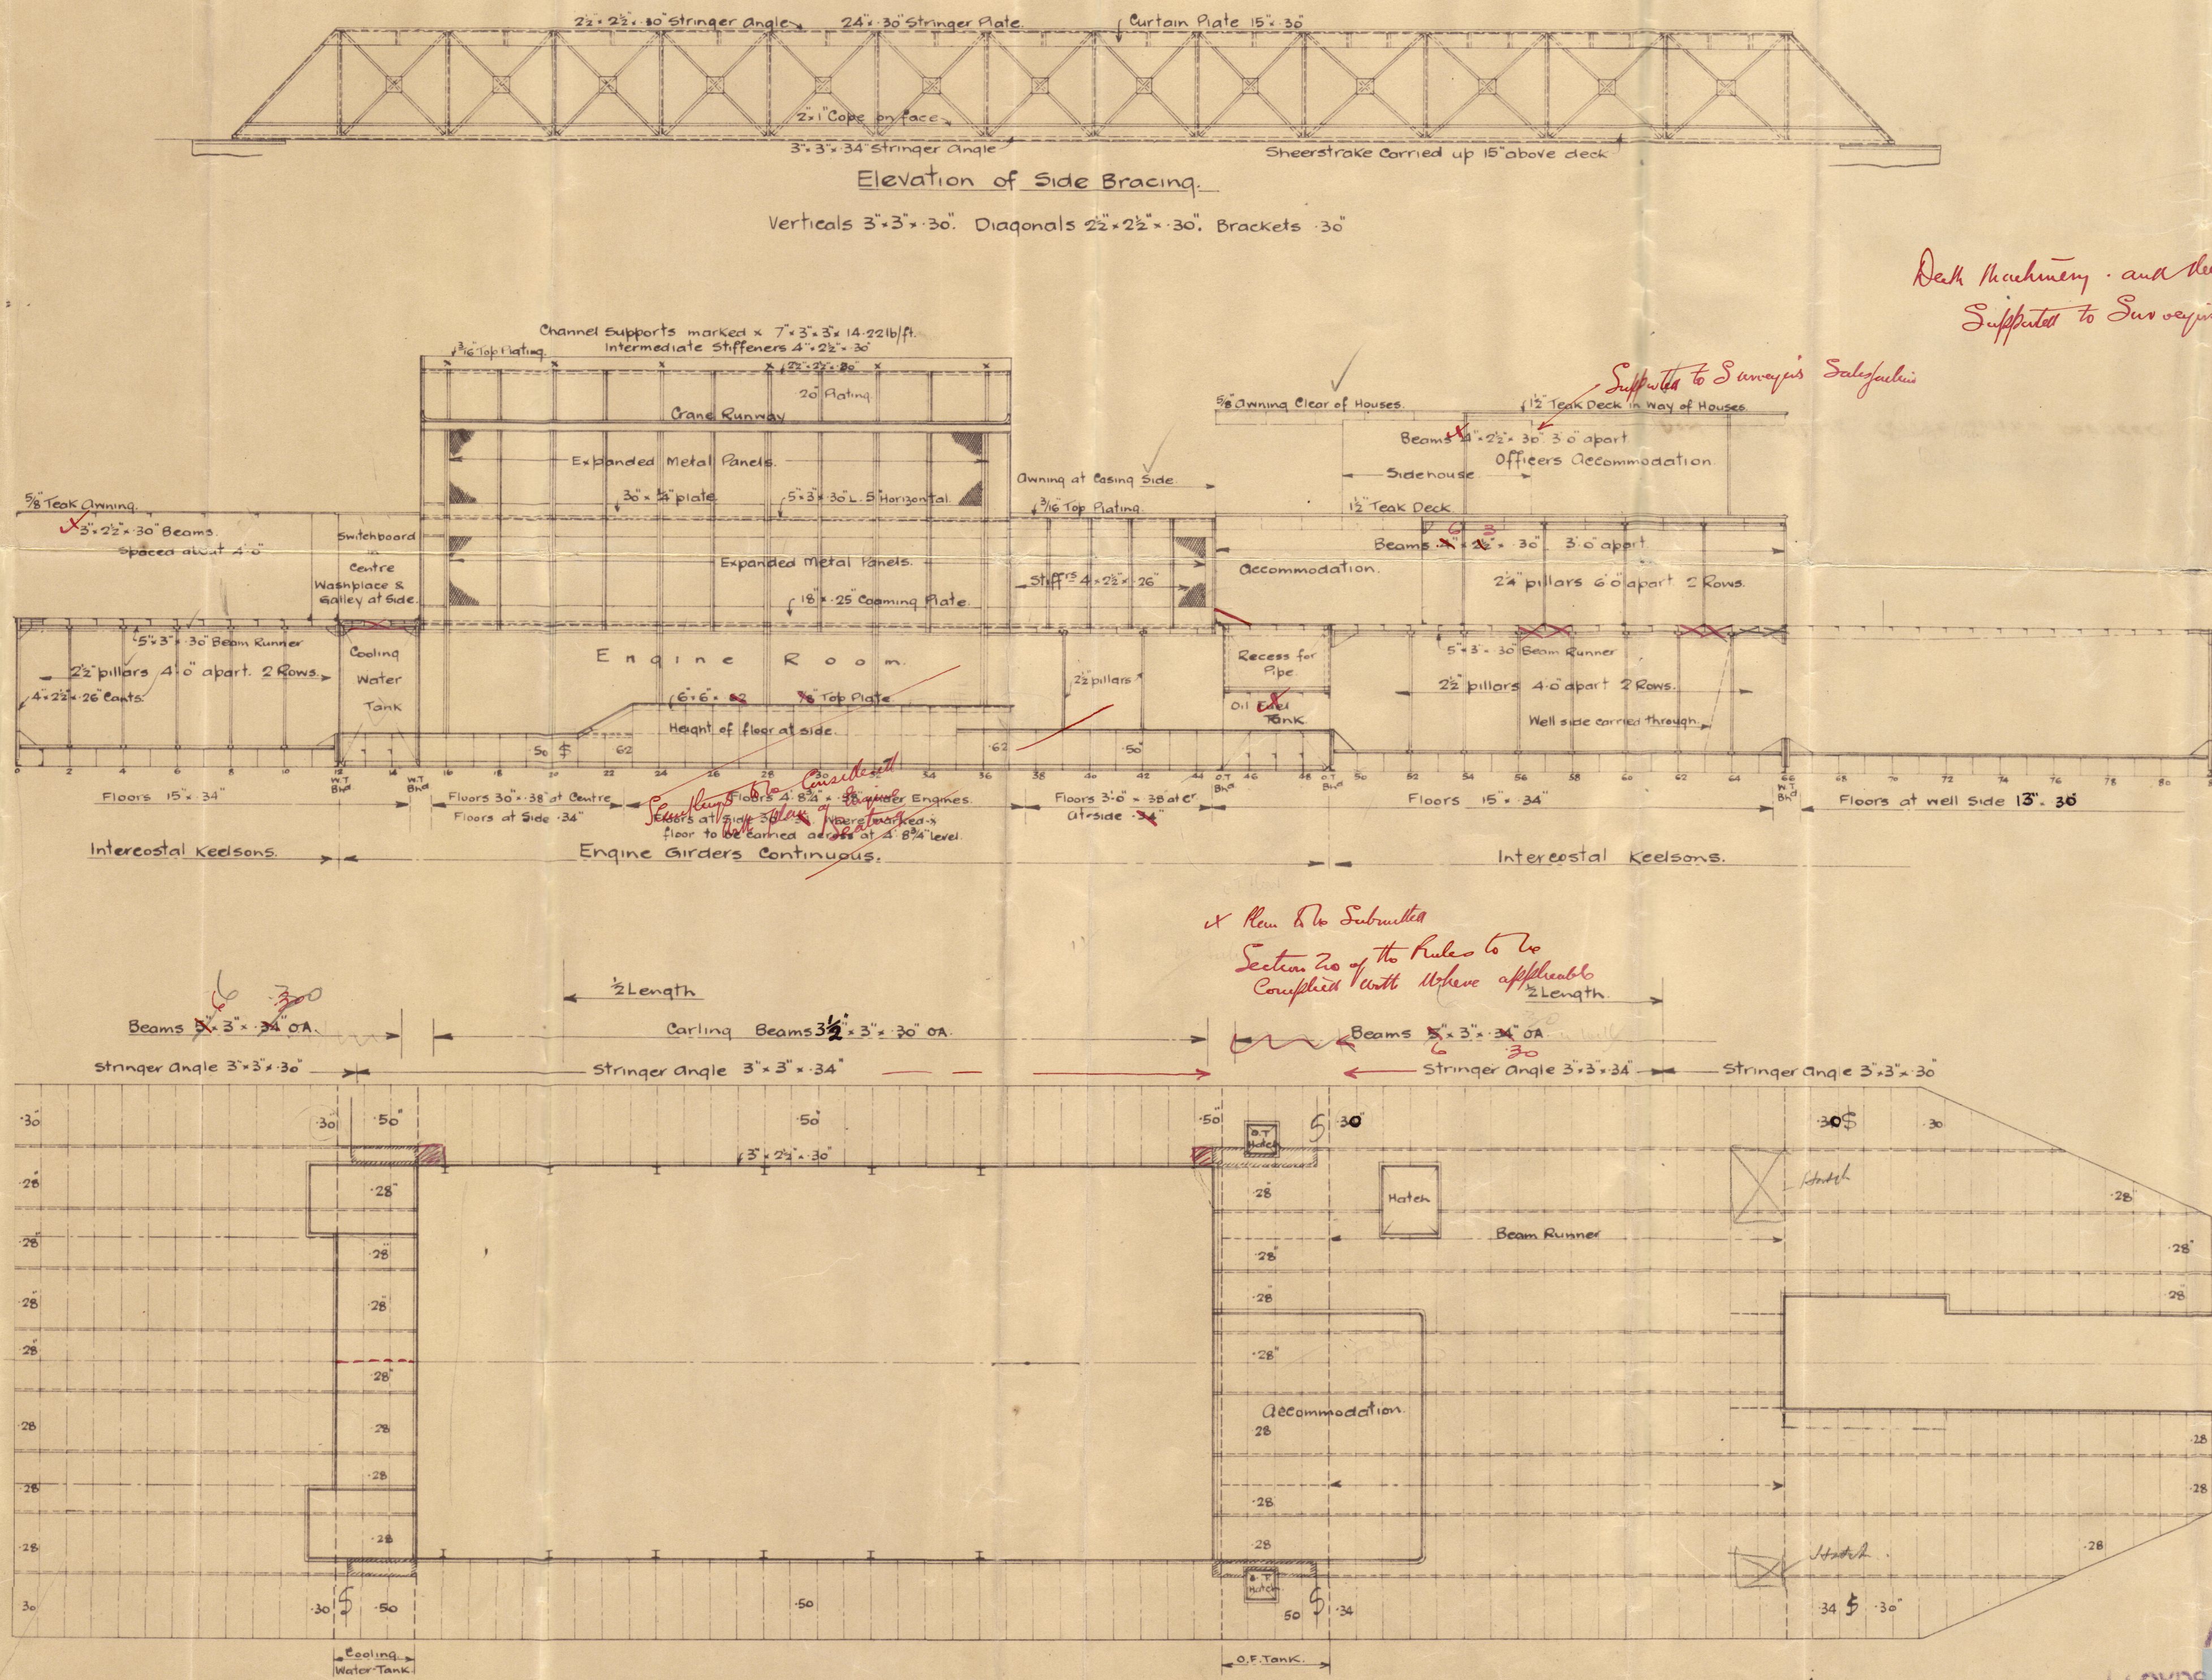

Dark Machinery. and Dark Houses

Supported to Surveyor's Satisfaction

✓ Rem. to be Submitted
Section 20 of the Rules to be
Complied with where applicable
Length

APPROVED
© 2018
LLOYDS REGISTER OF SHIPPING
Heckersm
2018
DATE

W6-0150

67
Messrs. Wm Simons & Co Ltd
NON PROPELLING CUTTER SUCTION DREDGER.

Yard No. 404.

Profile and Deck

6.

2
GLASGOW REPORT No. 54092

Boebus

Glasgow Report No. 54092.

W6-0150



© 2019

Lloyd's Register
Foundation