


STEEL BOILER 11'-0" DIA 10'-0" LONG 100 LBS W.P. LLOYDS



4466

14/5/12


RILEY BROS. (BOILERMAKERS) LTD.
STOCKTON ON TEES.

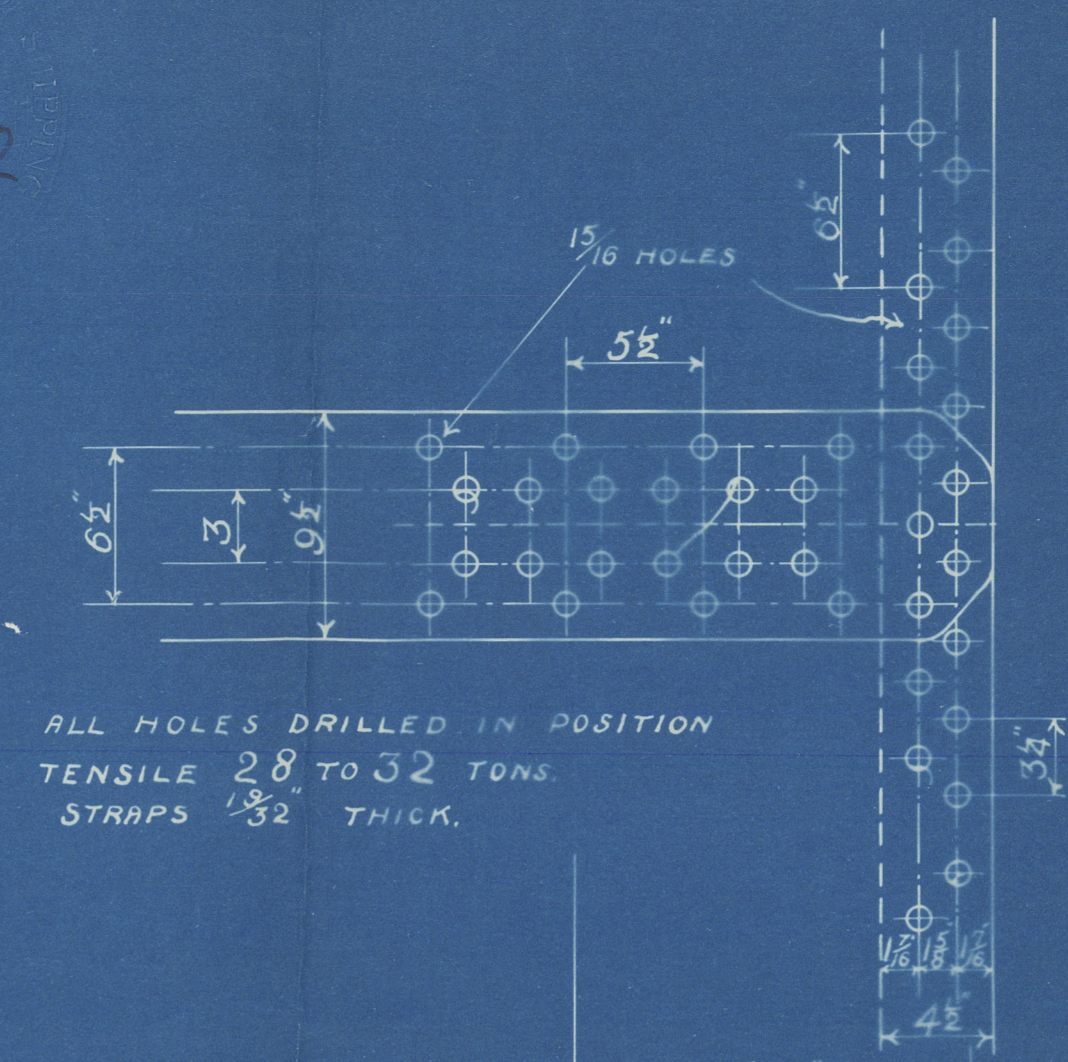

ALL HOLES DRILLED IN POSITION
TENSILE 28 TO 32 TONS.
STRAPS 1/32 THICK.

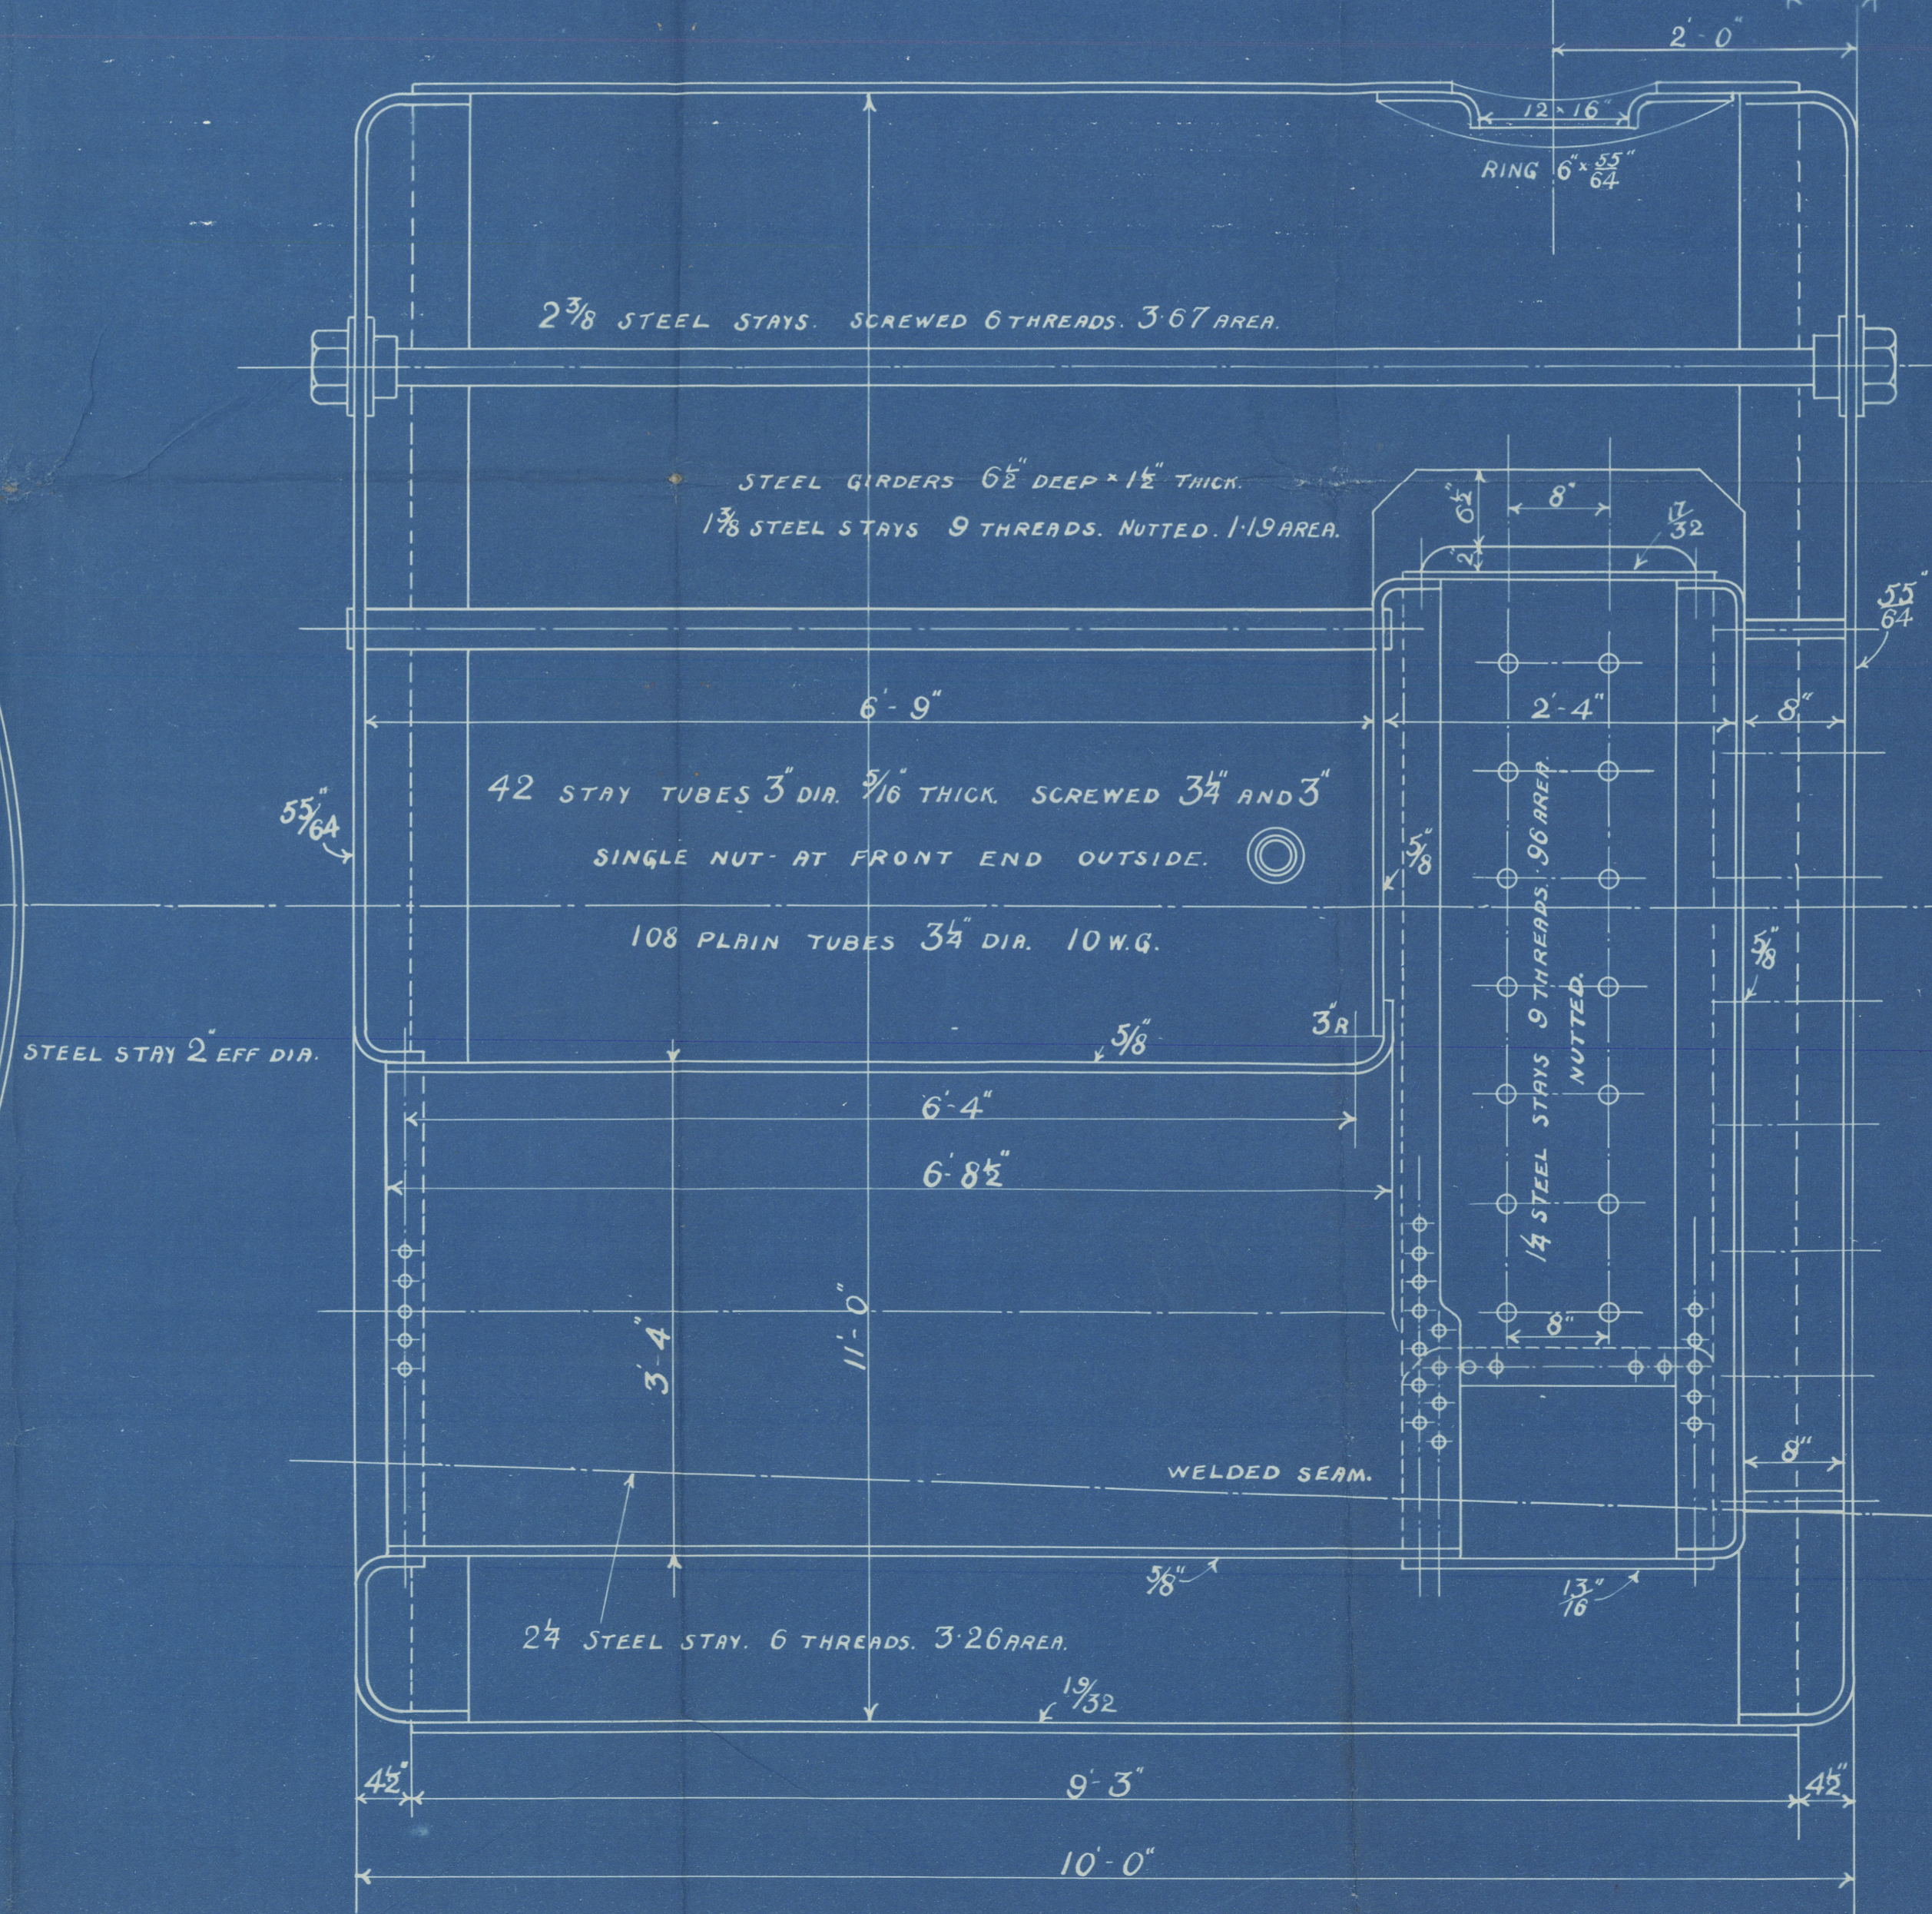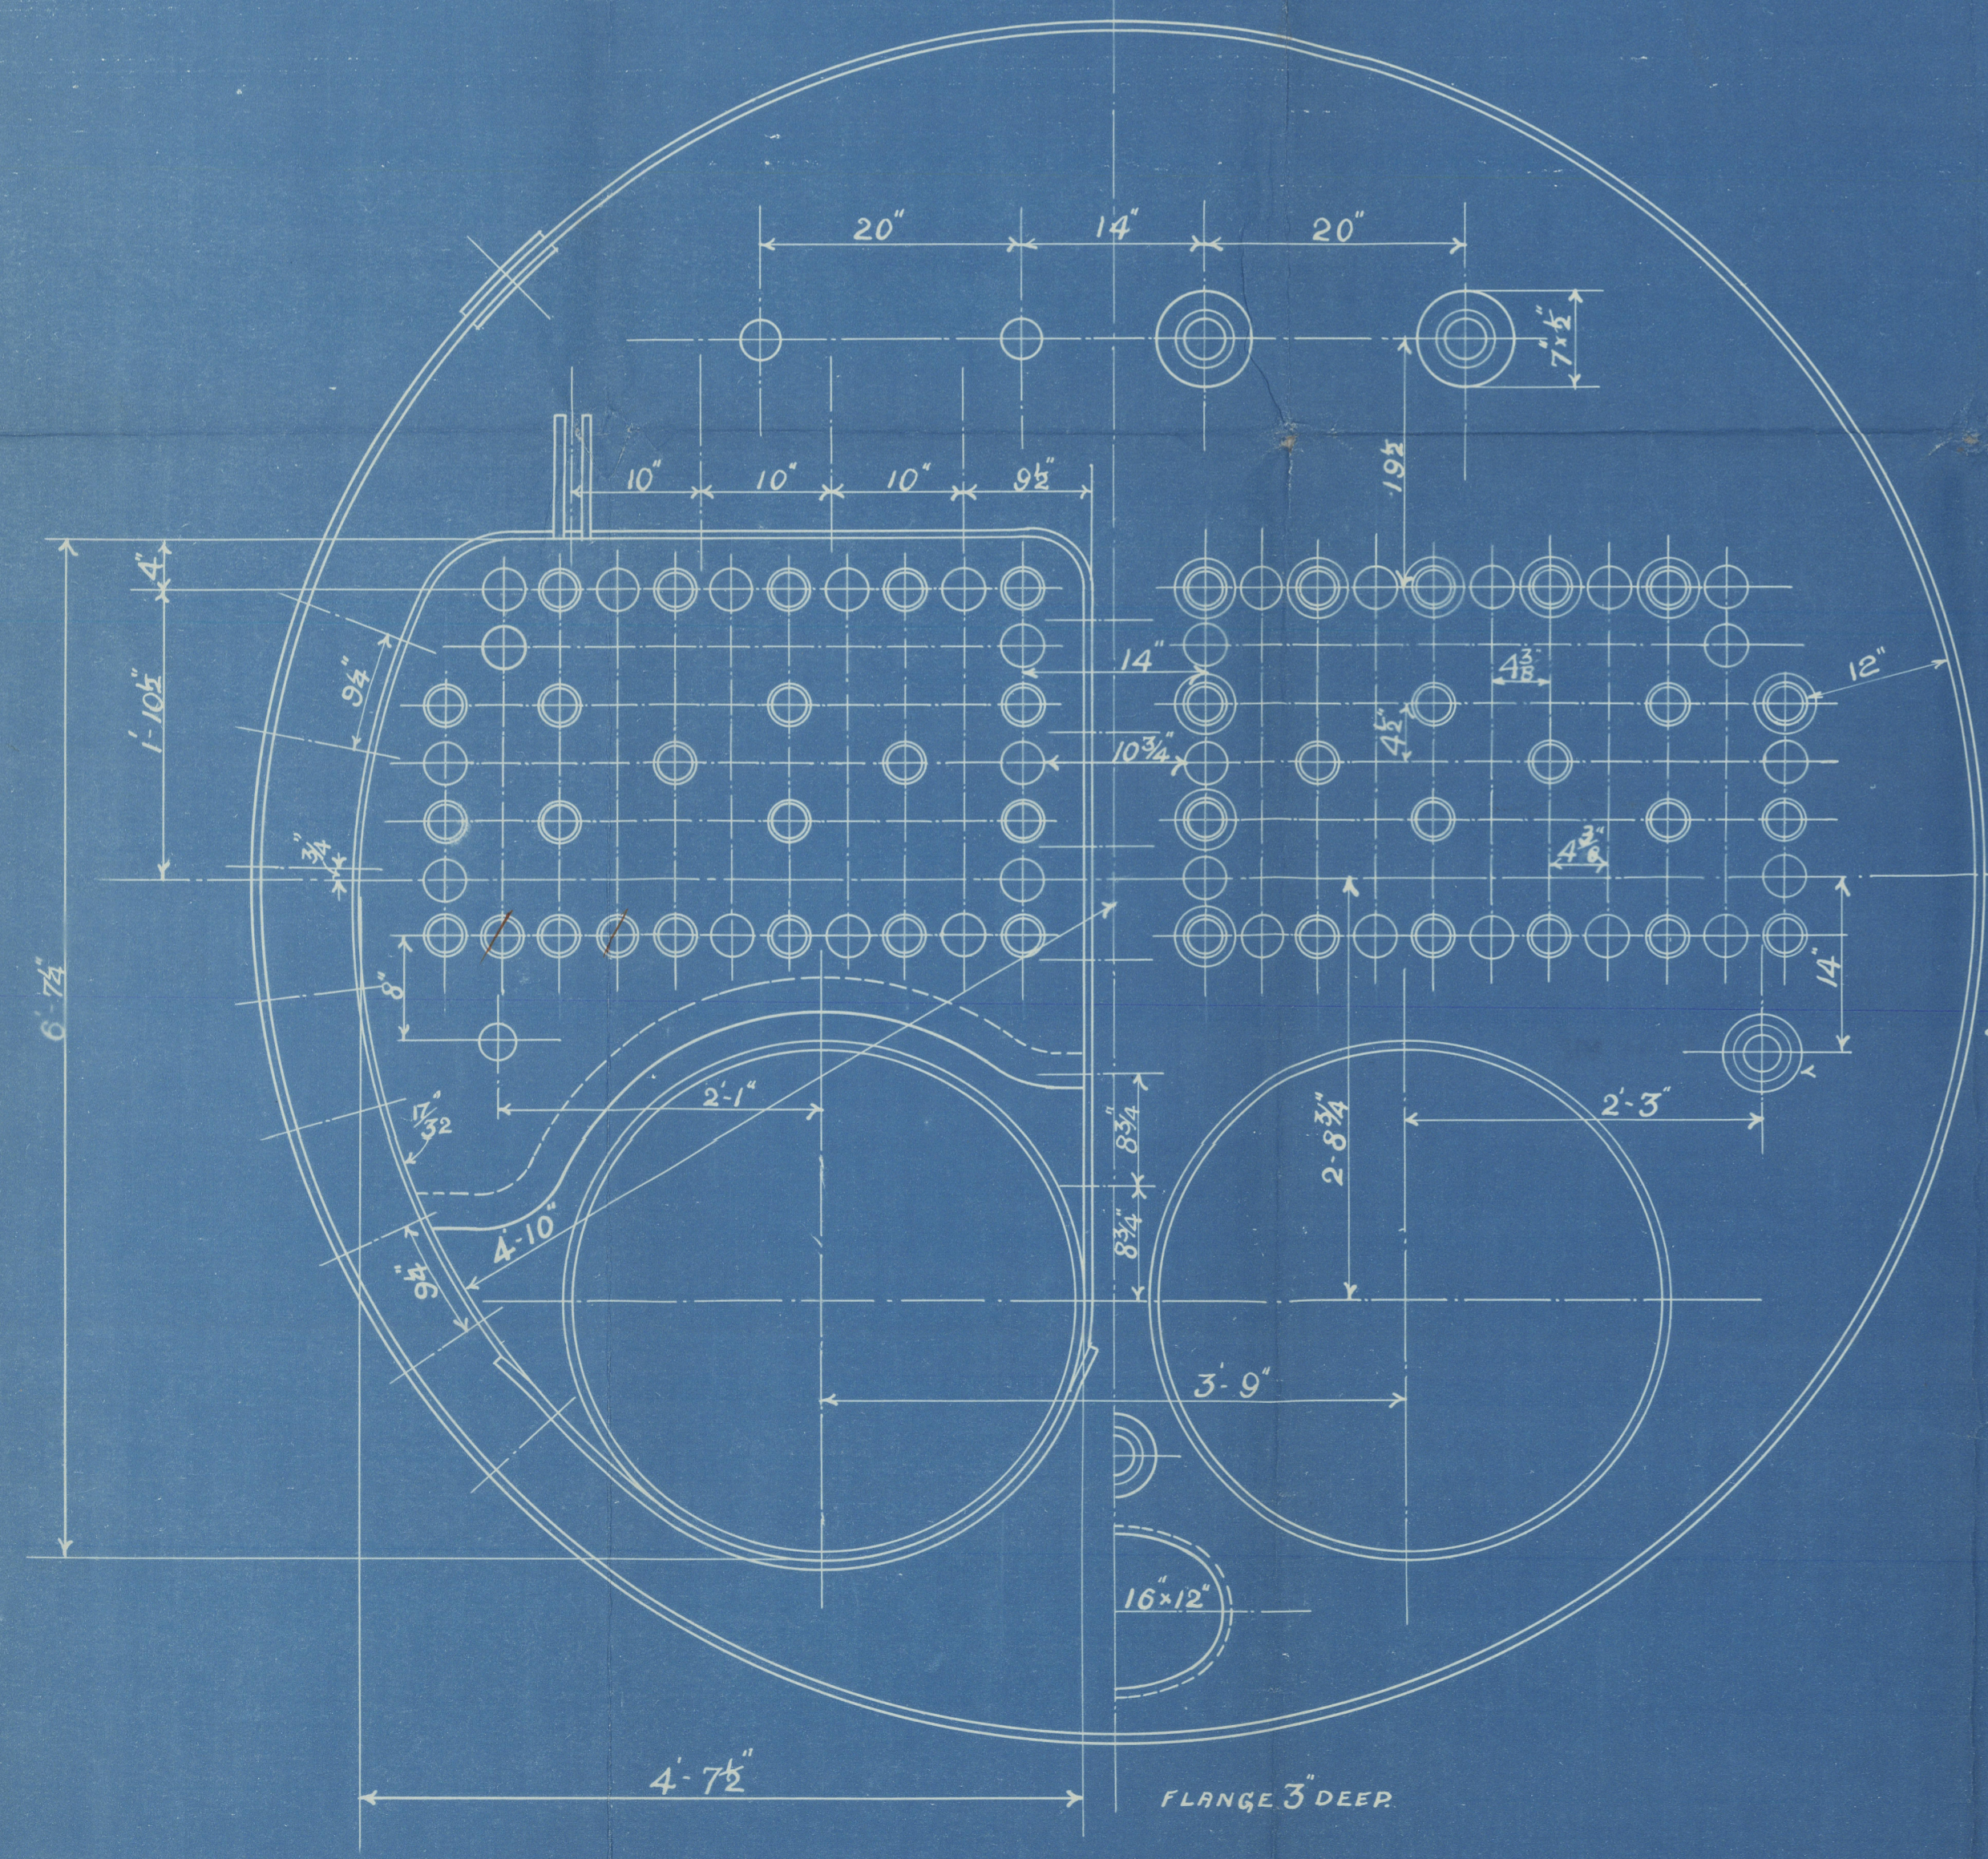

1 5/8 STEEL STAYS 9 THREADS 1.73 AREA NUTTED
O 1/2 " 9 " 145 "

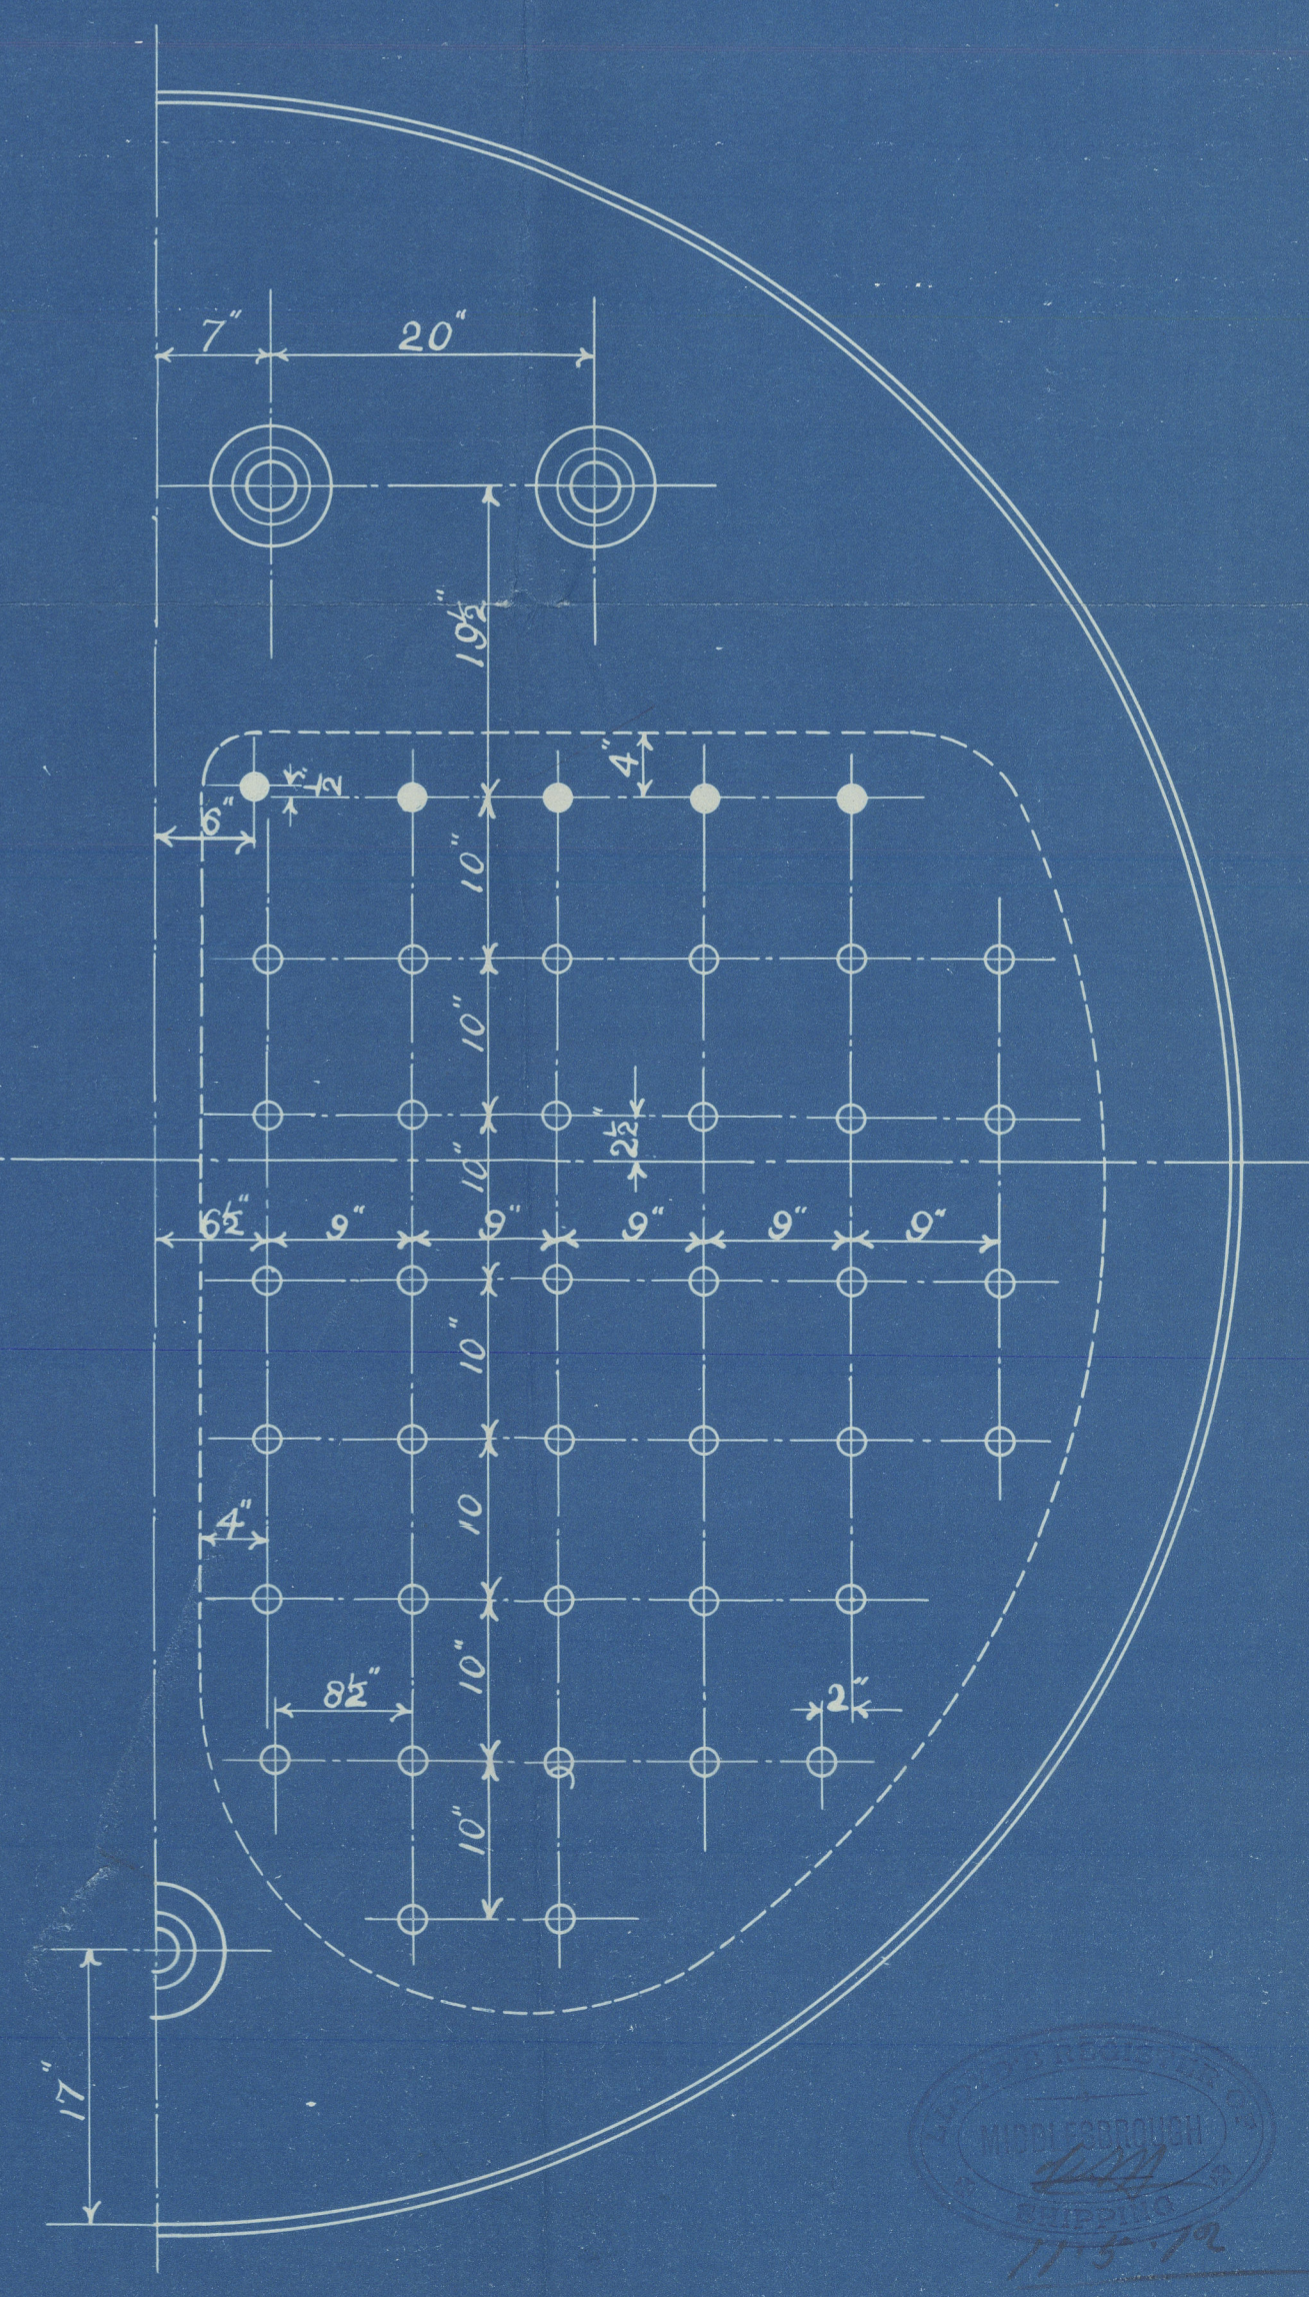

HEATING SURFACE 1140 f
GRATE AREA (5' 6" BAR) 35 f

14/5/12
RILEY BROS. (BOILERMAKERS) LTD.
STOCKTON ON TEES.



Huson Niley Bros Flat


Boiler No 4466

for

Huson Robt Thompson & Sons Flat

S.S. No 278

Working Press 100 lbs

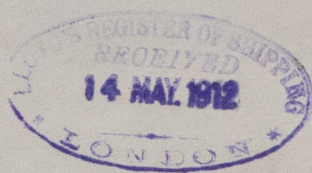

270.	5023
LLOYD'S TEST	
200	lbs.
12.2.13 - WM	

Lab. Report 7799

Laccifoglu

Sld. Rpt. 25632

W60-0120

Duplicate of Boiler No 4420
except w/w front.

Plan of boiler enclosed for information

© 2020

Lloyd's Register
Foundation