


FIVE BOILERS FOR EACH N°.

T. 5. 5<sup>s</sup> N<sup>os</sup> 468-9  
MAIN BOILERS.

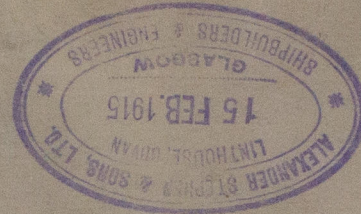



Also Stephens Sons 468/9.  
5 screws for each hammer.  
W.P. 215 lbs 16/2/15

Natia  
36 plans



Star<sup>rd</sup> aft } Bolls  
--- Centre }

T.S.S. Natia  
= 468

N<sup>o</sup> 14657  
LLOYDS TEST  
430 LBS

14-3-19. J.E.S.

N<sup>o</sup> 14680  
LLOYDS TEST  
430 LBS

4/4/19 H.C

N<sup>o</sup> 14727  
LLOYDS TEST  
430 LBS

14/5/19. W.H.F.

1 Bolls  
N<sup>o</sup> 15133  
LLOYDS TEST  
430 LBS  
W.P. 215 LBS  
11-12-19  
B.

2 Bolls  
N<sup>o</sup> 15146  
LLOYDS TEST  
430 LBS  
W.P. 215 LBS  
29-12-19  
J.E.S.

469 =

T.S.S.  
"NATIA"

2 Bolls  
N<sup>o</sup> 15070  
LLOYDS TEST  
430 LBS  
W.P. 215 LBS  
30-1-20  
J.E.S.

GLASGOW REPORT No. 40673  
S's Natia



© 2020

Lloyd's Register  
Foundation