


LONDON COPY.

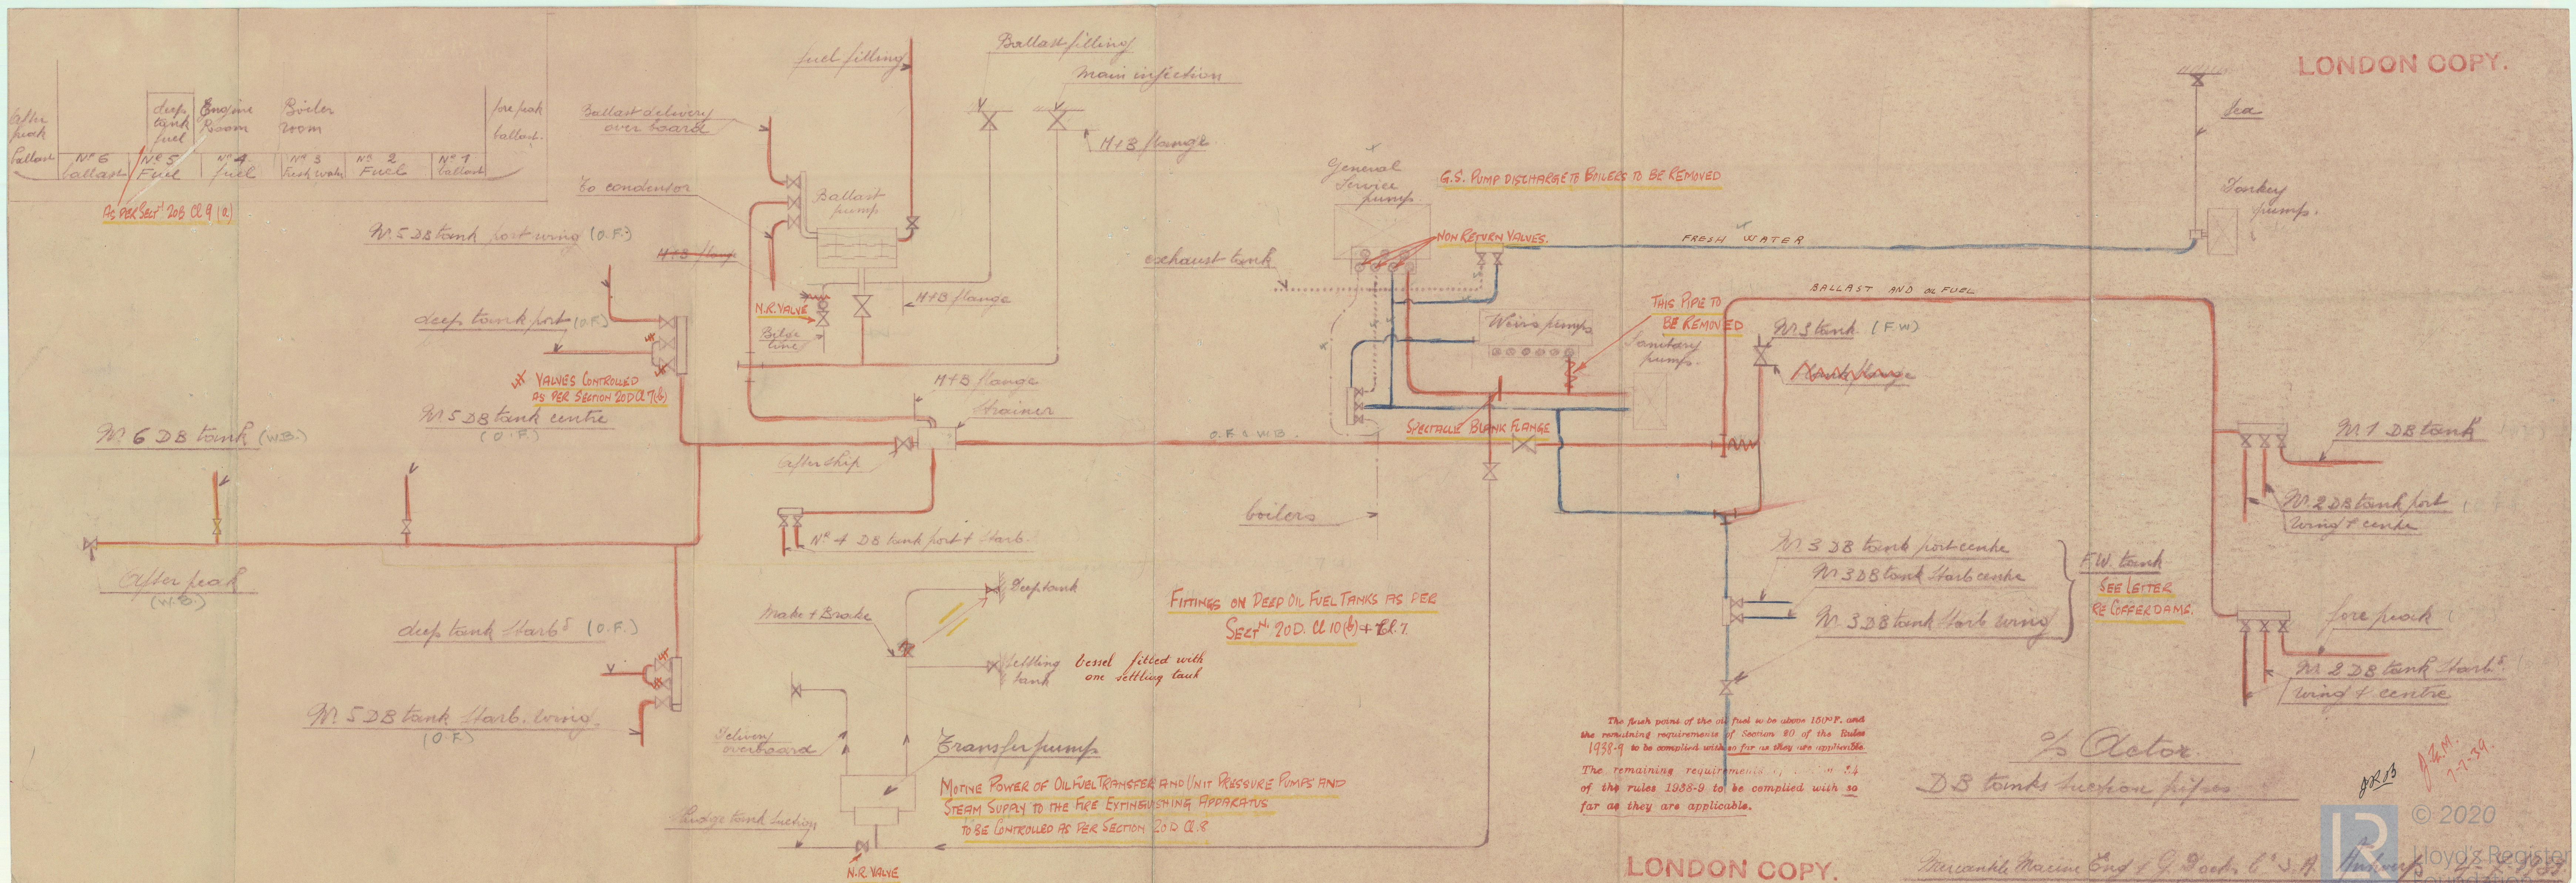

The flush point of the oil fuel to be above 150°F. and the remaining requirements of Section 20 of the Rules 1938-9 to be complied with so far as they are applicable. The remaining requirements of Section 24 of the Rules 1938-9 to be complied with so far as they are applicable.

LONDON COPY.

% Detector.
DB tanks suction pipes

Marine Eng'g & Dock Co. S.A.

agreed
1, 2 & 3, 5, 9, 10
4 [unclear] 10/10

- 6) O.F. + V.E. No day - age
7) Sam. sat himself that follow
emptying No 3 F. H. Tank as
not done through an only mark
with Sam
8) sheet back to Sam's flange in back
room to back tank

a) En. Sam

W60-0173

Page 1 of 1



© 2020

Lloyd's Register
Foundation