
 
 
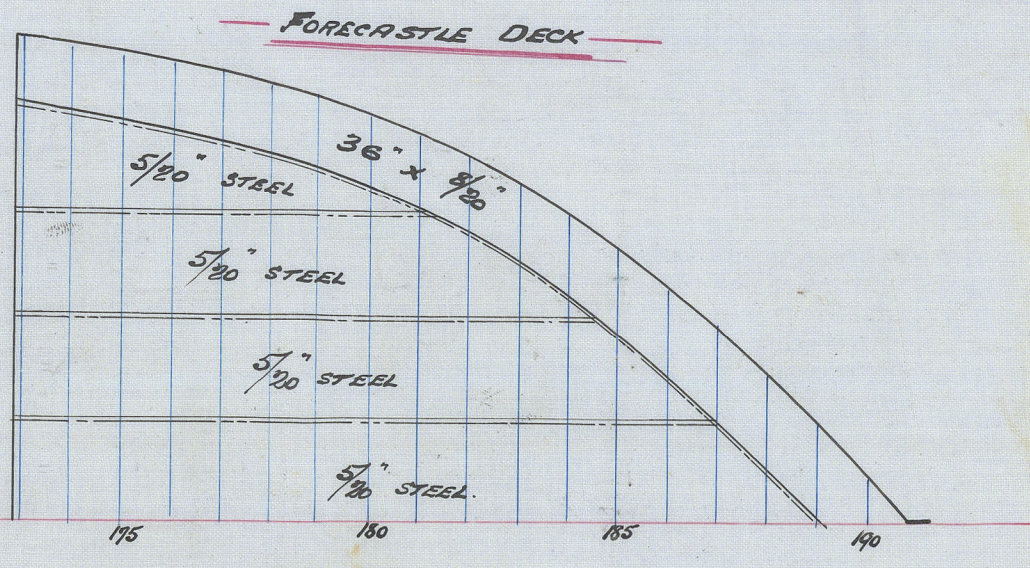
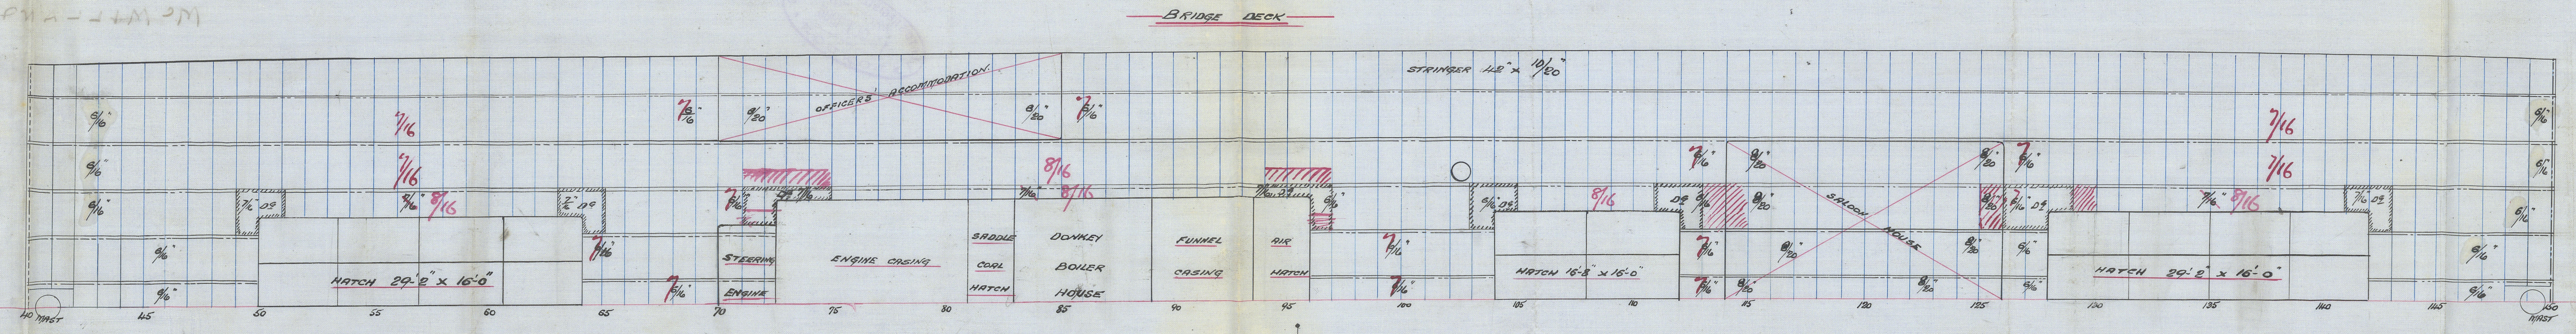


19.10.05  
29.11.05  
26.6.06

DECK PLANS  
No. 407  
S.S. No. 407

DECK PLANS.  
S.S. No. 407.  
SCALE 1/8" = 1 FOOT.

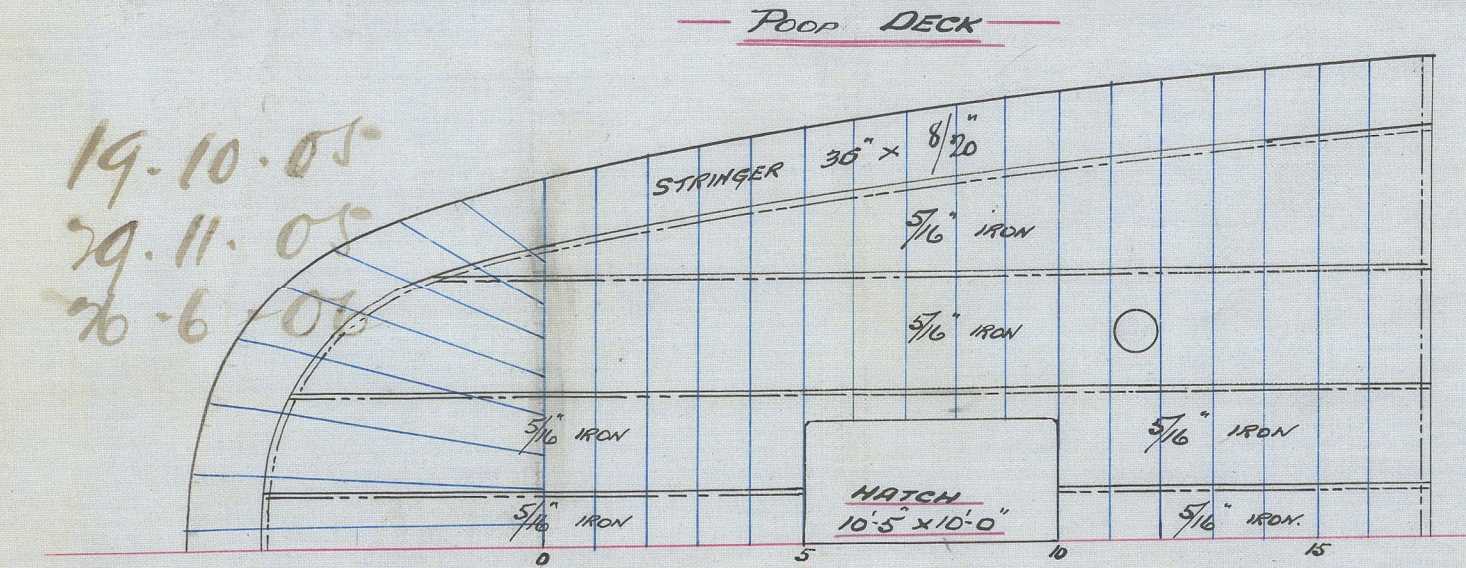

C.R.  
19.10.05



DECK PLANS  
No. 407  
McMILLANTSON

DECK PLANS  
S.S. No. 407

SCALE 1" = 10'

PLAN

W600-0224

W600-0224

James  
Geo. H. No. 25009

