

James & Blount
2nd 10.2.1906

MIDSHIP SECTION

To apply to
S.S. No 410

SCALE: 1/2 INCH = ONE FT.



DIMENSIONS, 400'-0" B.P. x 49'-0" MLD x 29'-10" MLD
TO CLASS 100 A.I. SPAR DECK.

PARTICULARS FOR FREEBOARD

LENGTH ON L.W. LINE	399'-6"
OF POOP	38'-5"
OF BRIDGE	229'-2"
OF CASTLE	40'-3"
SHEER AFT AT STERNPOST	5'-0"
8" FROM	2'-9"
8" FROM	5'-2 1/2"
AT	10'-0"
DEPTH MOULDED	29'-10"
TONNAGE COEFF.	.82

SUMMER FREEBOARD FROM TOP OF

STATUTORY DECK LINE = 5'-1 1/2"

3DK. No

26. 51.66	43.66
25. 24.84	24.84
30. 83	22.84
104.36	91.40
15. No 100.36	398
308	82.60
802.88	244.20
93.24	3634.20
30.108	2.20
2 nd No 39943.28	

BREADTHS TO LENGTH = 8.00

DEPTH TO = 12.9150X

11 = 1440.1705



EQUIPMENT No

104.36	398
858.88	966.24
32208	42429.28
POOP DECK FEEL 3645.36	38.411229
HOUSES AFT END 58.306.44	39.58 x 4.45 x 1
SALOON HOUSE 184.50	25.00 x 4.50 x 1
CHART HOUSE 160.00	20.00 x 4.50 x 1
144048.88	= EQ. No

EQUIPMENT

- 2 BOWER ANCHORS STOCKLESS 632 CMTS
- 1 D° - D° - D° - 5 1/2 D°
- 1 STREAM - D° - EX STOCK 1 1/2 D°
- 1 KEDGE - D° - D° - 4 1/2 D°
- 240 FMS 2 1/2" STUD CHAIN CABLE
- 90 D° - 1 1/2" STEEL WIRE, IN LIEU OF STREAM CHAIN
- 120 D° - 5" - D° - TONLINE
- 2 @ 90 D° - 2 1/4" - D° - HANSER
- 2 @ 90 D° - 2 1/2" - D° - WARD

BRIDGE DECK 42" x 10" BUTTS QUADRUPLE RIV
POOP " " 36" x 8" 1/2
FO'LE " " 36" x 4 1/2
BRIDGE " " ANGLE 4" x 4" x 10"
FO'LE POOP " " 3" x 3" x 8 1/2

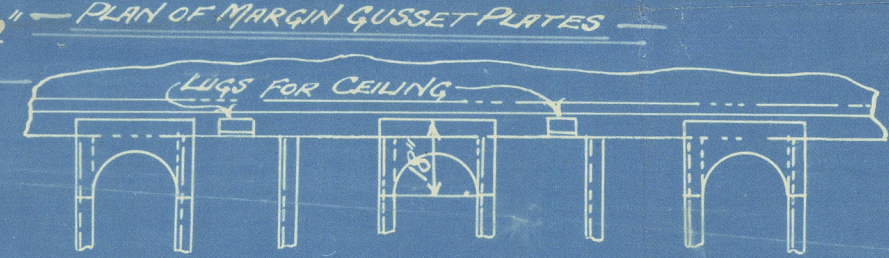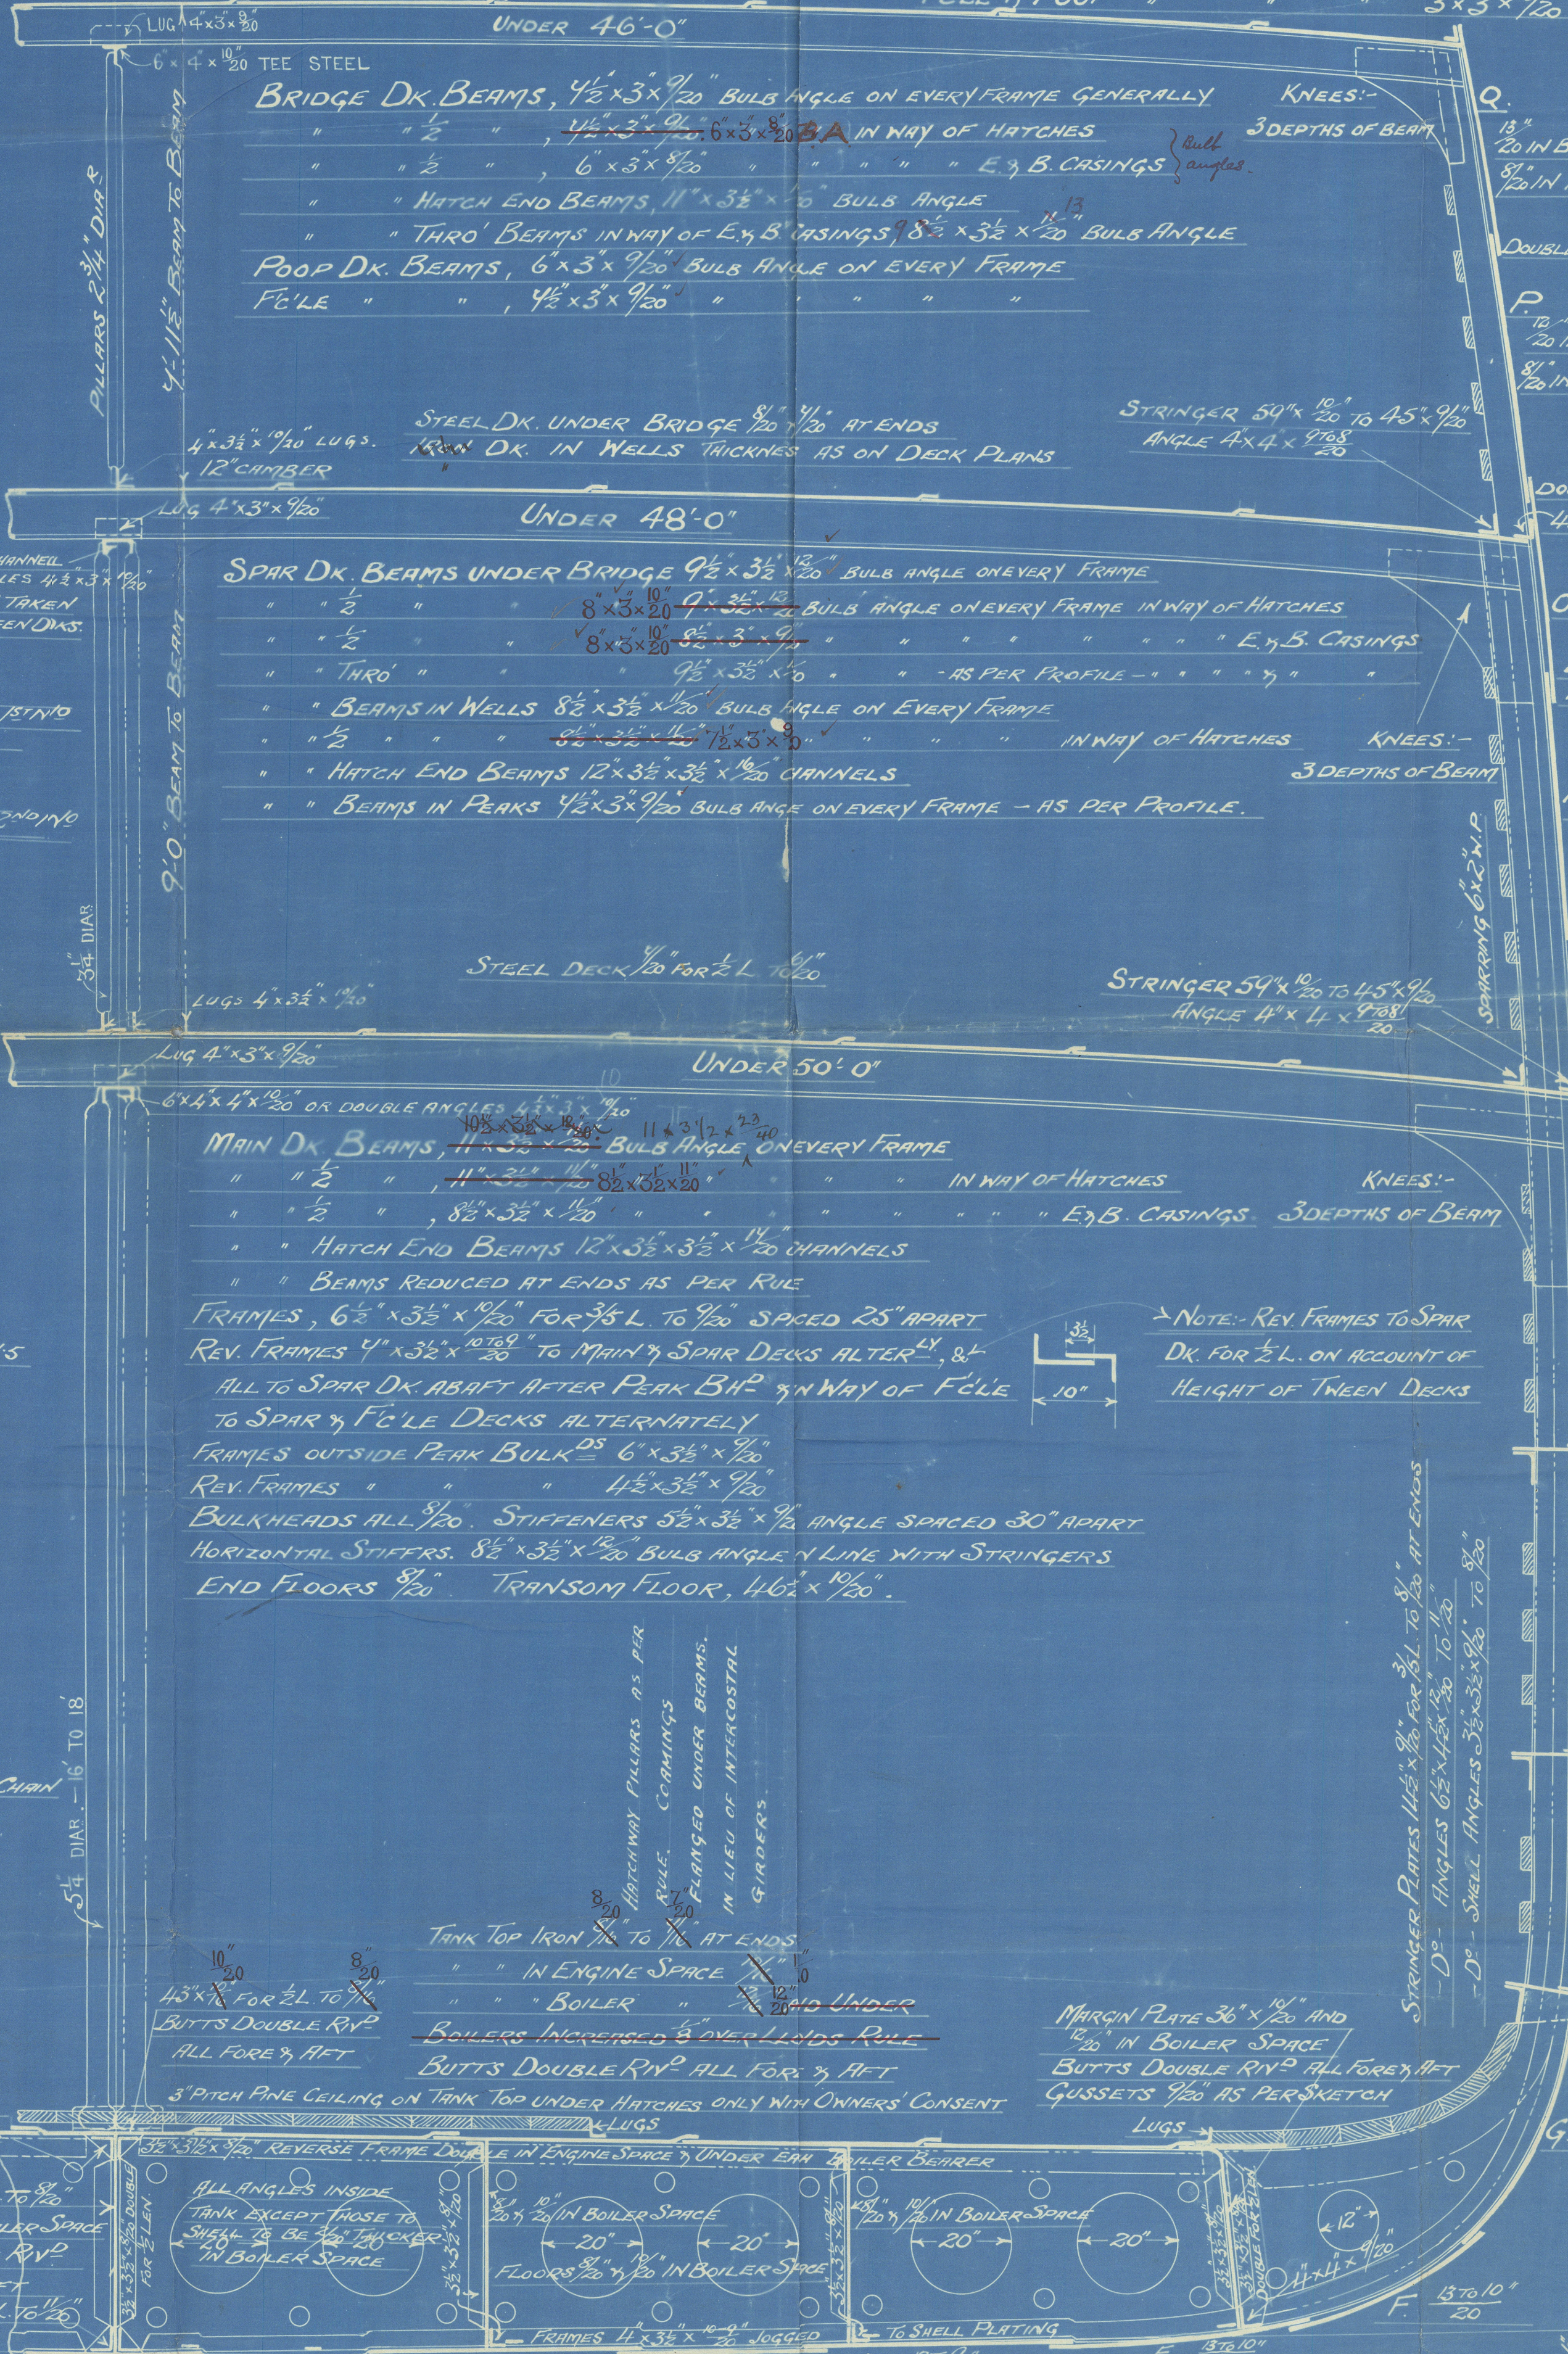

NOTE: FLOORS & REV. FRAMES INSIDE DOUBLE BUTTOM OF IRON IN WAY OF BOILER SPACE 9 1/2" ABOVE RULES

STEM 11 x 3"
STERNPOST 11 x 4"
RUDDER HEAD 10" DIA.
PINTLES 5" -
PLATE 2 1/2" -
KEEL PLATE A. RULE 36" x 10" FOR 1/2 L TO 1/2 L
RULE 36" x 10" PROPOSED 11 1/2" x 10" FOR 1/2 L
WITH DOUBLING FOR 1/2 L
PROPOSED 42" x 10" FOR 1/2 L
1/2" FOR 1/2 L AT ENDS
NO DOUBLING
DOUBLE BUTTSTRIPS TREBLE RIV ALL FORE & AFT
B, C, D STRAKES REDUCED 20" INSIDE DOUBLE BOTTOM WHEN 20" AND OVER
PROVISION OF SECTION 129 NIL BE CARRIED OUT

SHALL BUTTS FROM A TO O INCLUSIVE TO BE OVERLAPPED & TREBLE RIV ALL FORE & AFT, EXCEPT P & Q IN POOP AND FORECASTLE WHICH WILL BE DOUBLE RIVS, AND WHERE STRAKES ARE OVER THE RULE WIDTH, BUTTS TO BE QUADRUPLE RIVETED WITHIN THE 1/2 LEN ONLY
MAIN AND SPAR DECK STRINGER PLATES OVERLAPPED & TREBLE RIVETED. POOP & FORECASTLE STRINGER PLATES OVERLAPPED & DOUBLE RIVETED

Kasama
Glo. rpt. no. 25009




W600-0228




© 2020

Lloyd's Register
Foundation

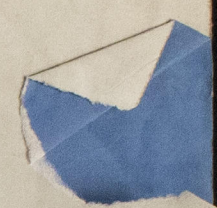

410
Induction

W 600-0226

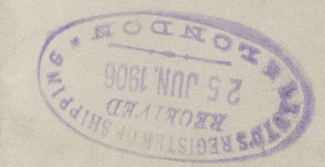

© 2020

Lloyd's Register
Foundation