



12.6.01
16.9.01
25.7.01

Speedonia MAIN DECK

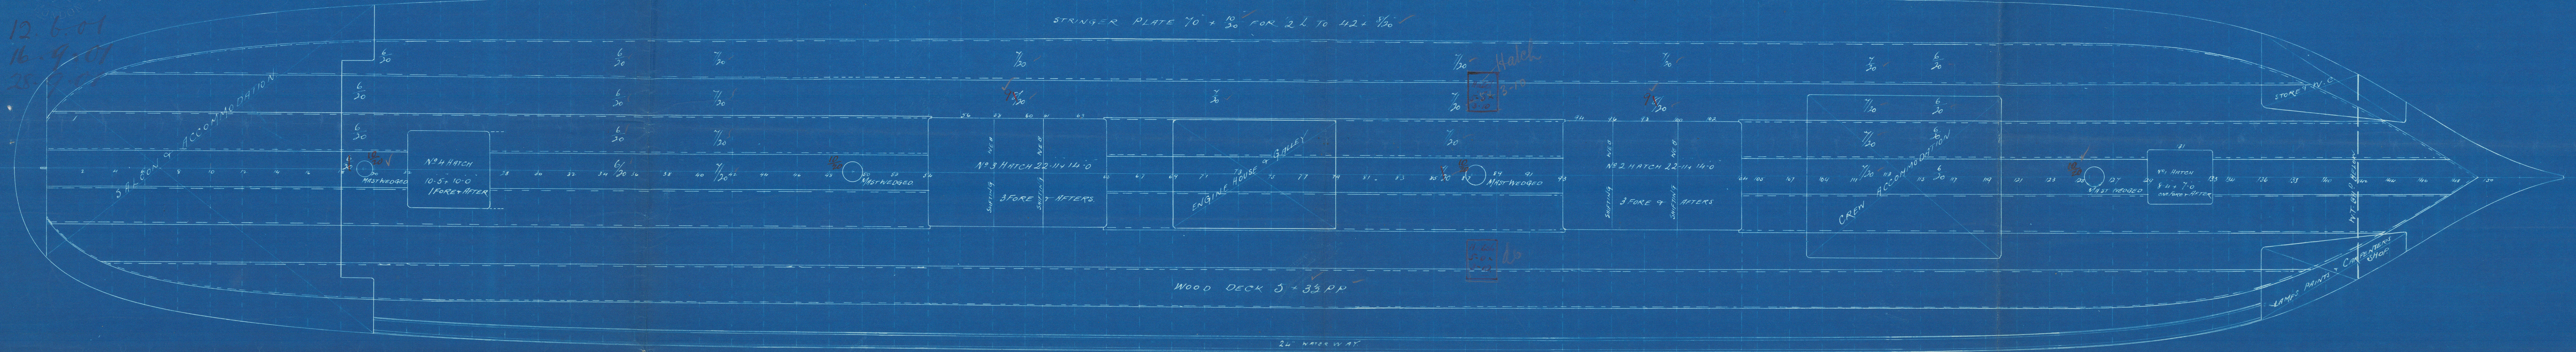

LOWER DECK

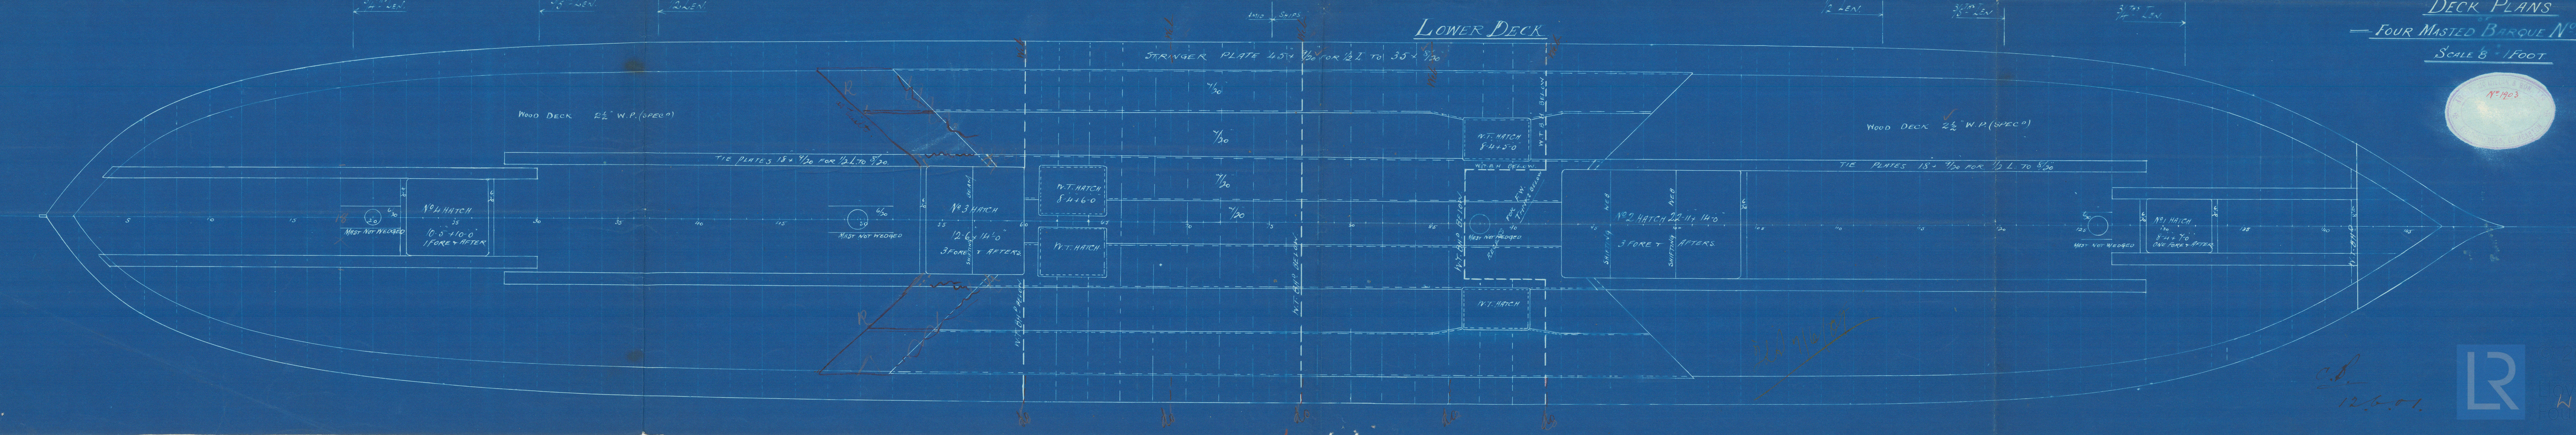

DECK PLANS
— FOUR MASTED BARQUE N°382 —
SCALE 8" = 1 FOOT



12.6.01

Deck Plans




A. McMillan Esq
No. 382 "Urania"

Glasgow. No 19699



No 382 Bk Alsterberg

Esq. No 19912

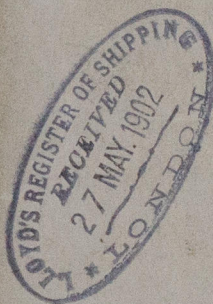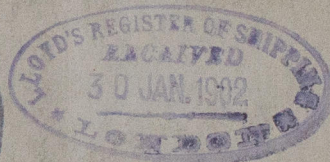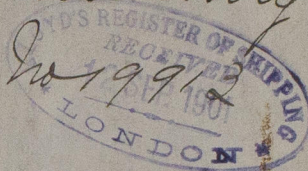

RECEIVED



© 2020

W601-0343

Lloyd's Register
Foundation