


16.5.01
12.6.01
16.9.01
14.10.01 (P.383)



PROFILE
OF
FOUR MASTED BARQUE N°382
SCALE 1/8" = 1 FT.

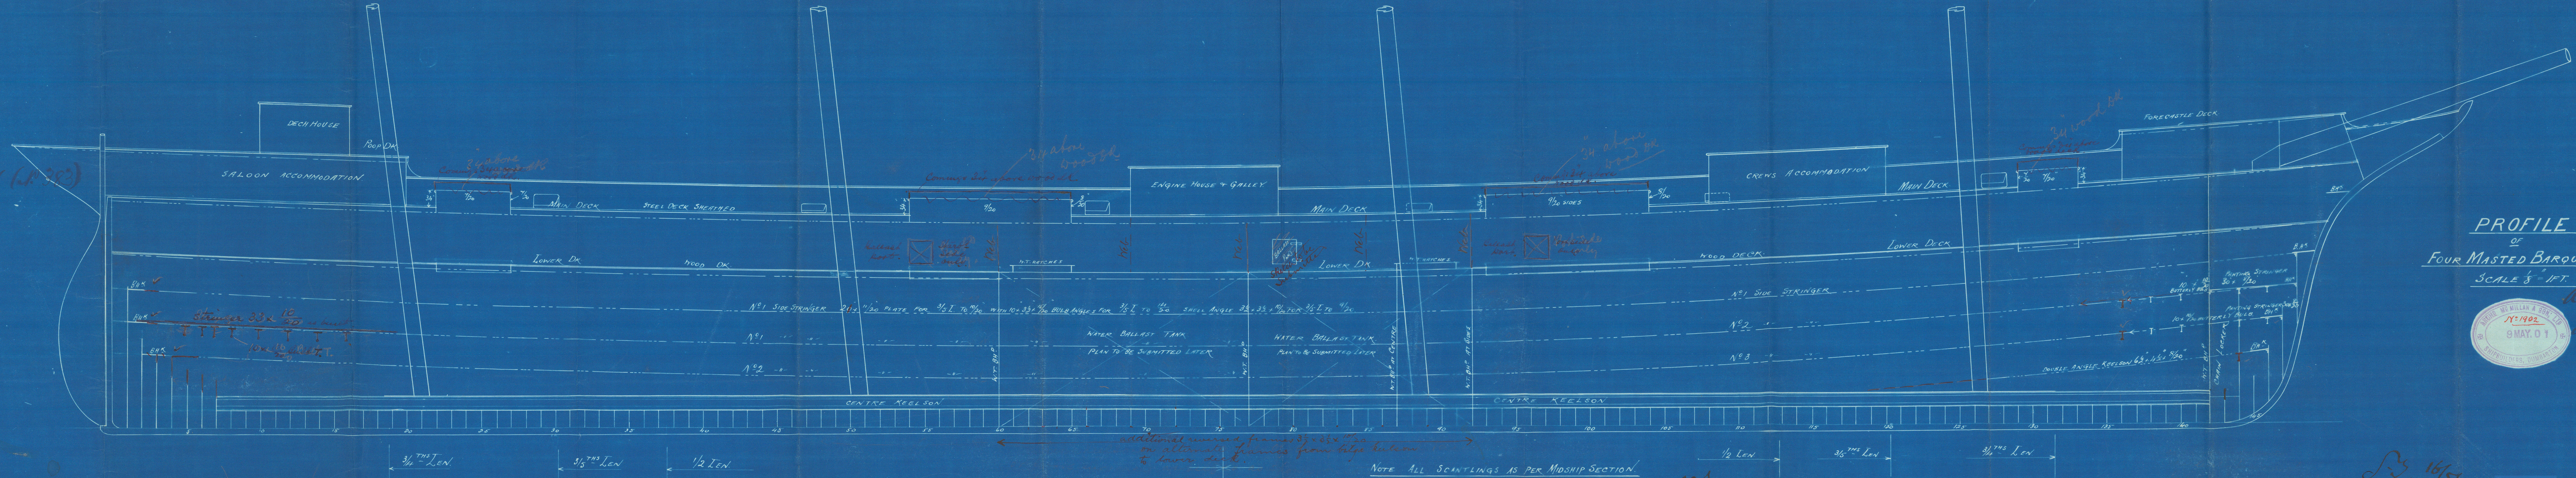

Also N° 383
app. 14/10/01


additional reversed frames 3 1/2 x 8 1/2 x 1 1/2 on alternate frames from bilge keelson to lower deck.
NOTE ALL SCANTLINGS AS PER MIDSHIP SECTION.

22.11.51


16/5/01

Profile plan


a. Mc Millan & Sons
in 382. BR "Urania"
No. 383

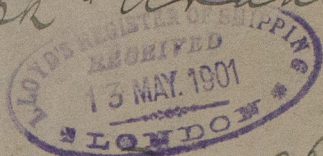

Glasgow. no 19699

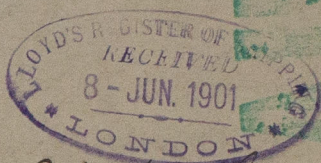

no 383 - Alister
Glasgow no 19913

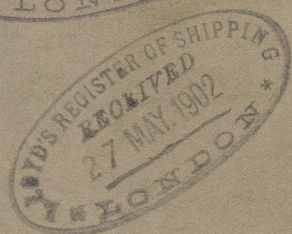




© 2020

Lloyd's Register
Foundation
H601-0345