


20.4.31


S. RUY BARBOSA

Außenhaut 1.50

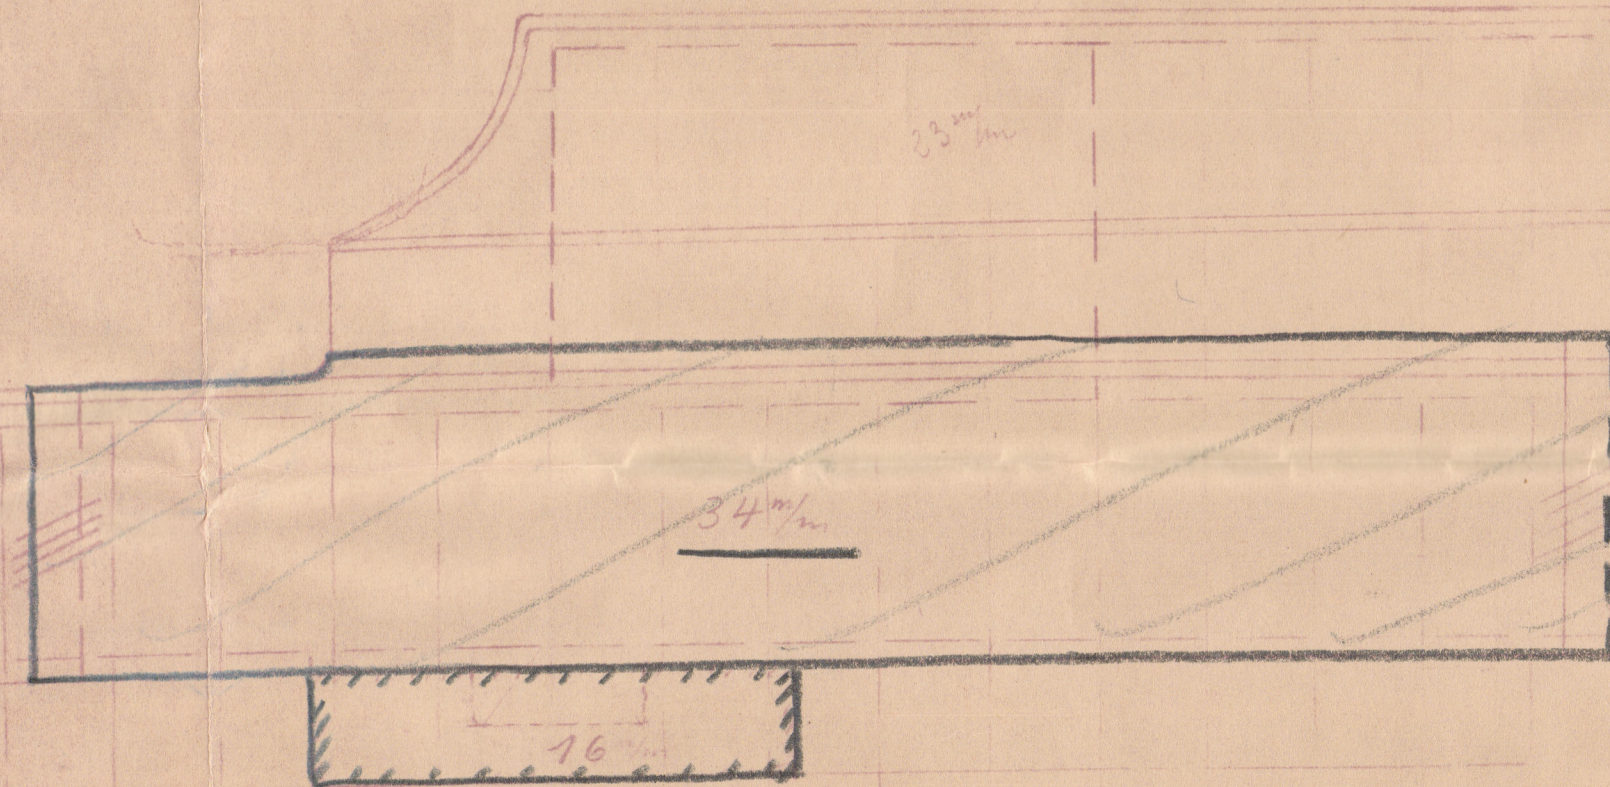

44 46 48 50 52 54 56 58 60 62 64 66 68 70


Schnitt A-B

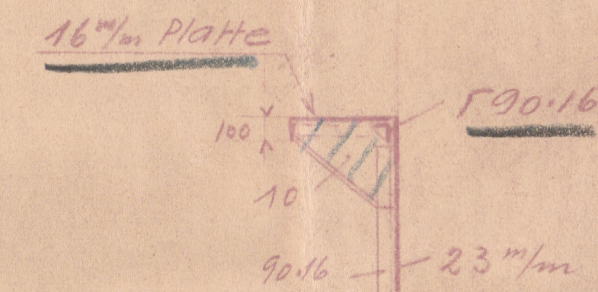


Brückendeck

Hauptdeck

I. Deck

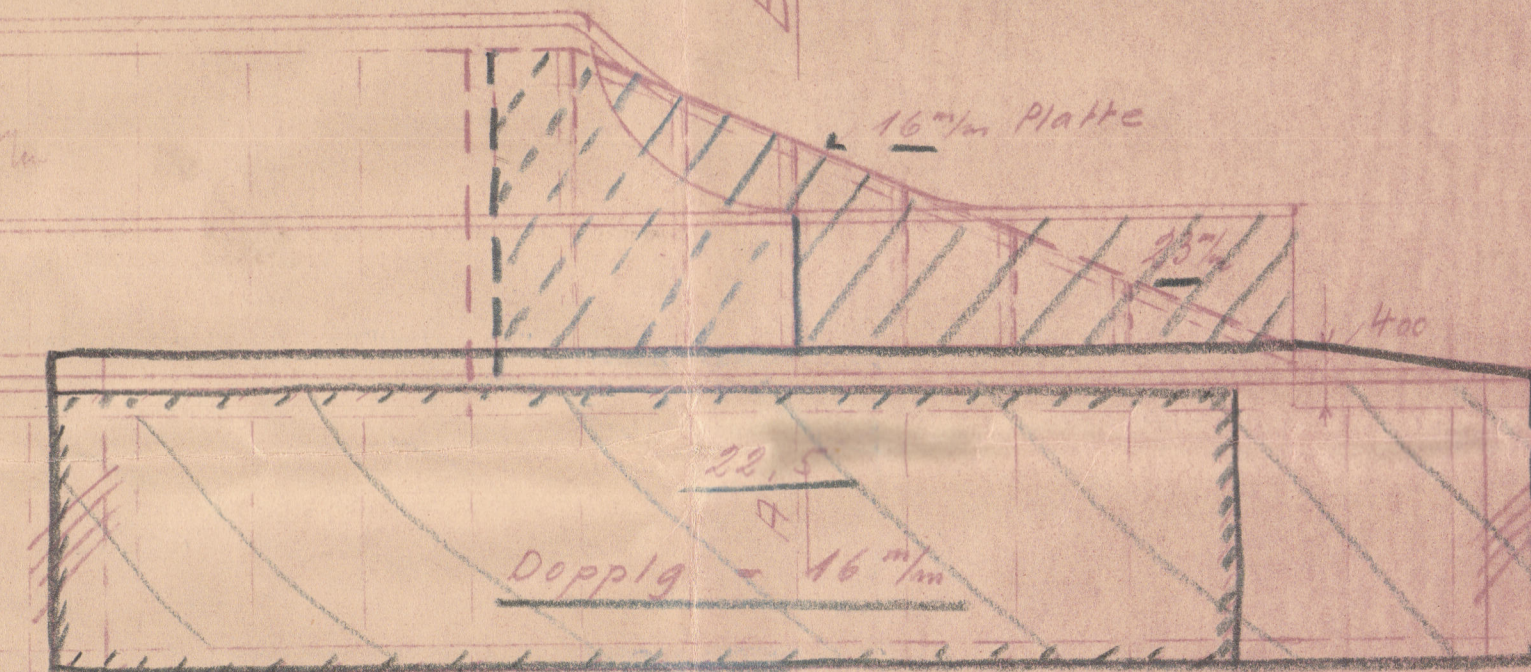


112 114 116 118 120 122 124 126 128 130 132 134

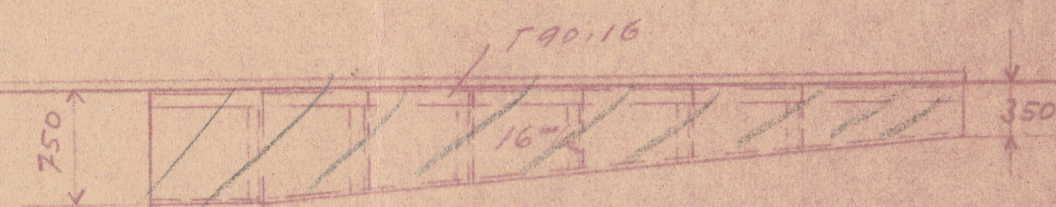

20.4.31

L. 17742.

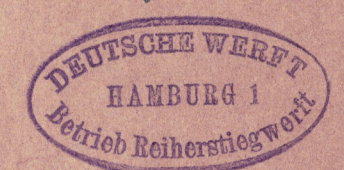

14. April 1931



© 2019

Lloyd's Register Foundation

W602-0052

RECEIVED



© 2019

Lloyd's Register
Foundation

W602-0052