
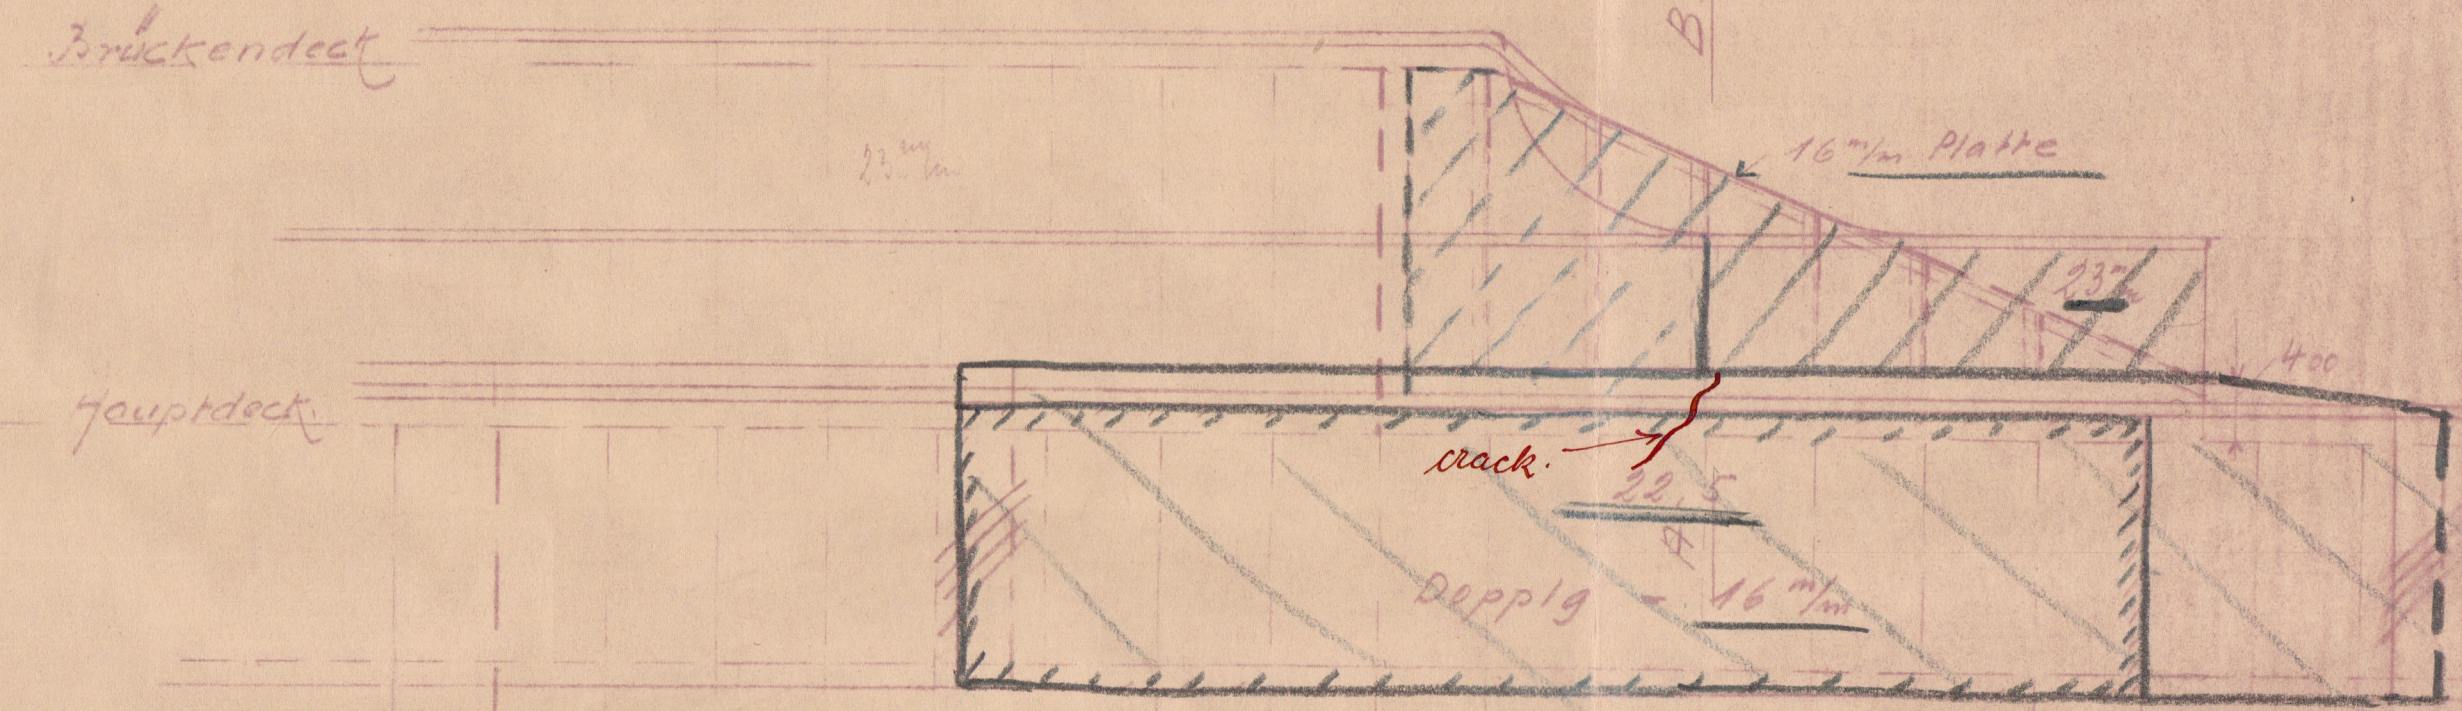


S. RUY BARBOSA

Flüßer 1:50

Schnitt A-B

Office

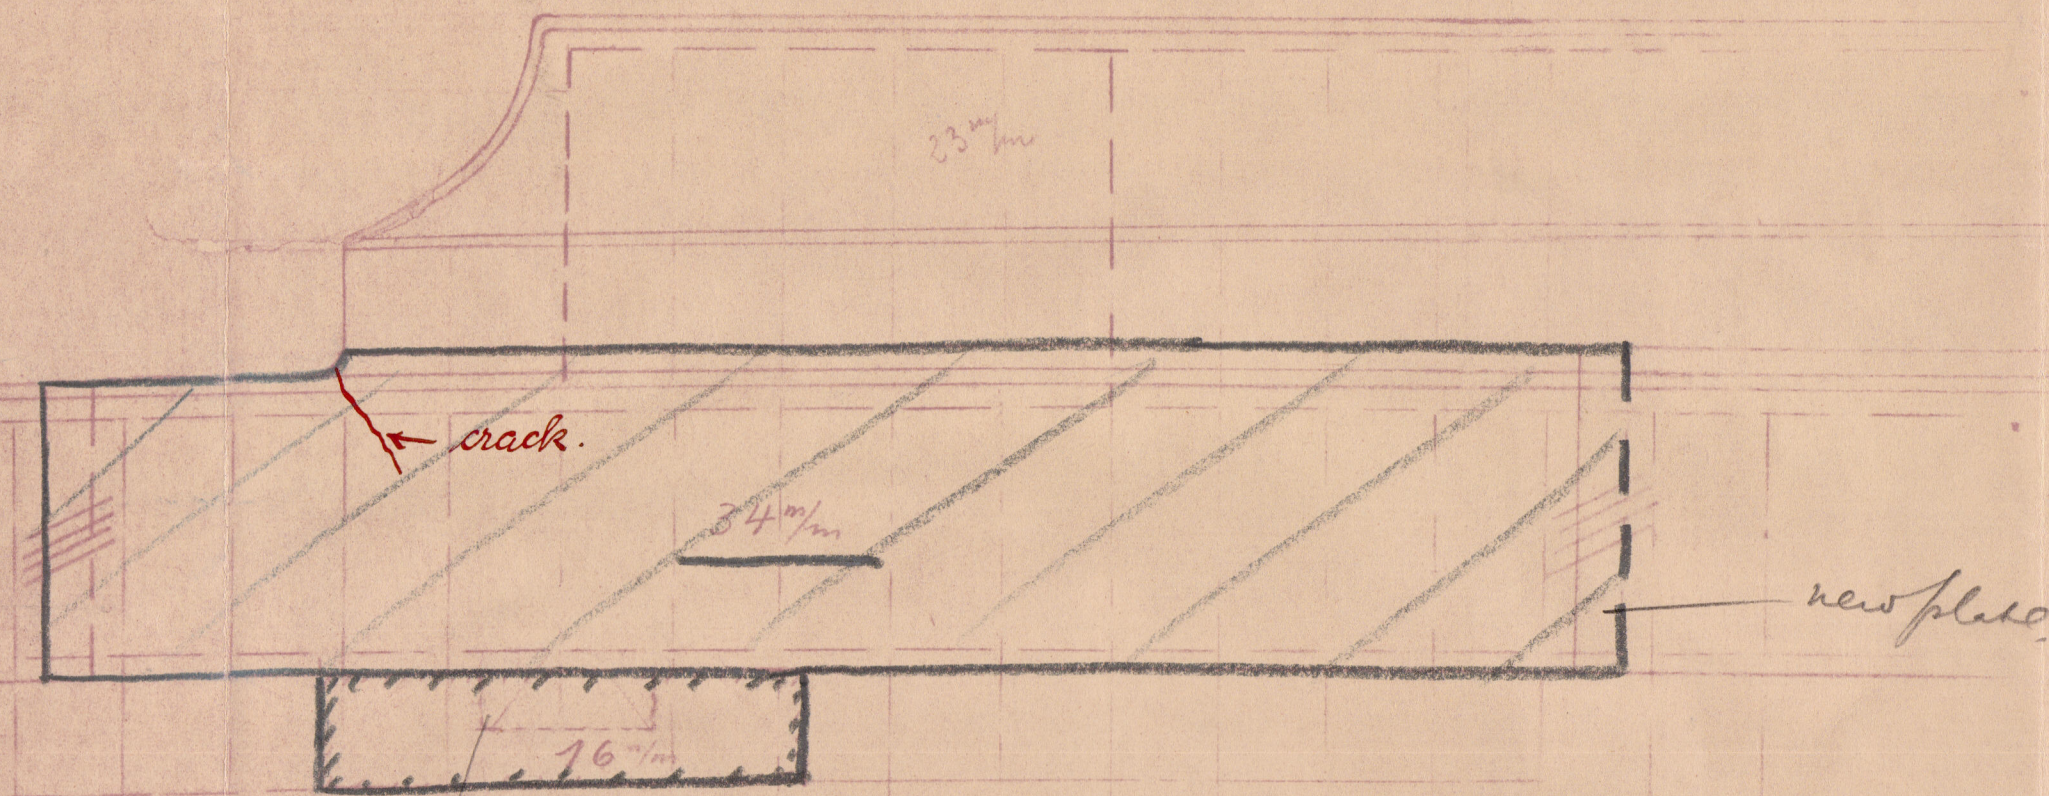


44 46 48 50 52 54 56 58 60 62 64 66 68 70

112 114 116 118 120 122 124 126 128 130 132 134

part of an opening which was formerly cut in
sheerstrake & stables below and is now closed.
Doubling fitted to compensate for part still remaining
in stabe below sheerstrake

20. 11. 21

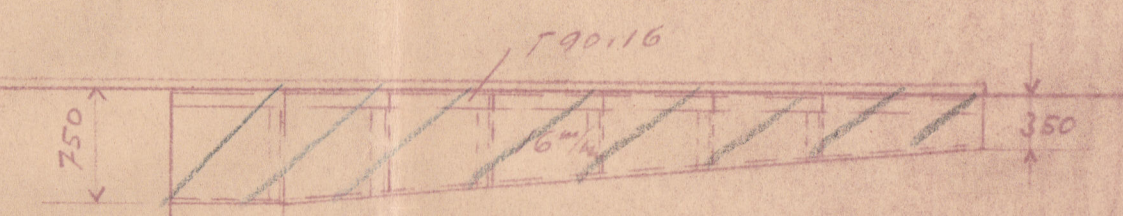

(NEW)
- new



14. April 1931



Lloyd's Register Foundation

"RUY BARBOSA"

RECEIVED



© 2019

Lloyd's Register
Foundation

W602-0056