

20.7.12
 6.8.12
 11.10.12
 2.12.12
 26.8.13

16" 555-556.
 Two twin screw Steamers.




300' x 42' x 26'

To be classed 100 A1 Lloyd's Register.

Scale 1/4" = 1 foot.



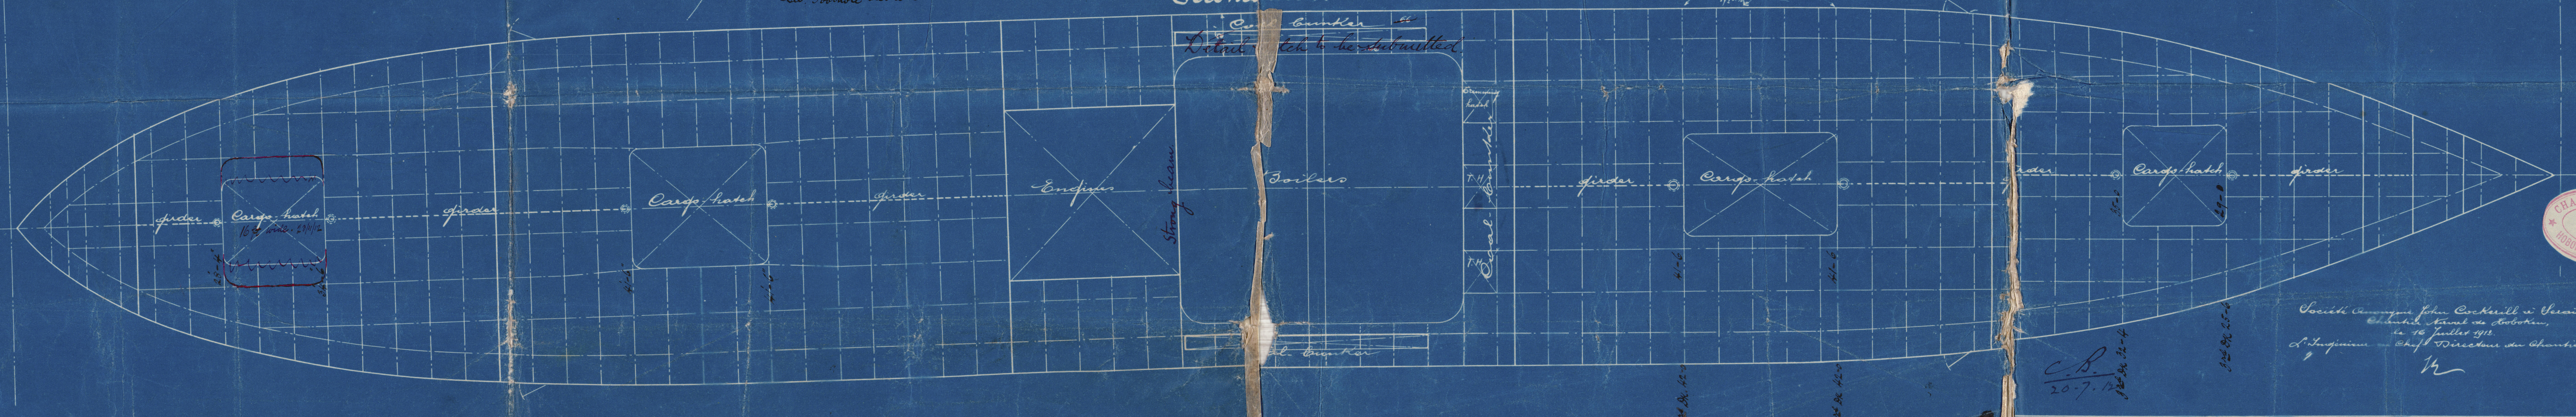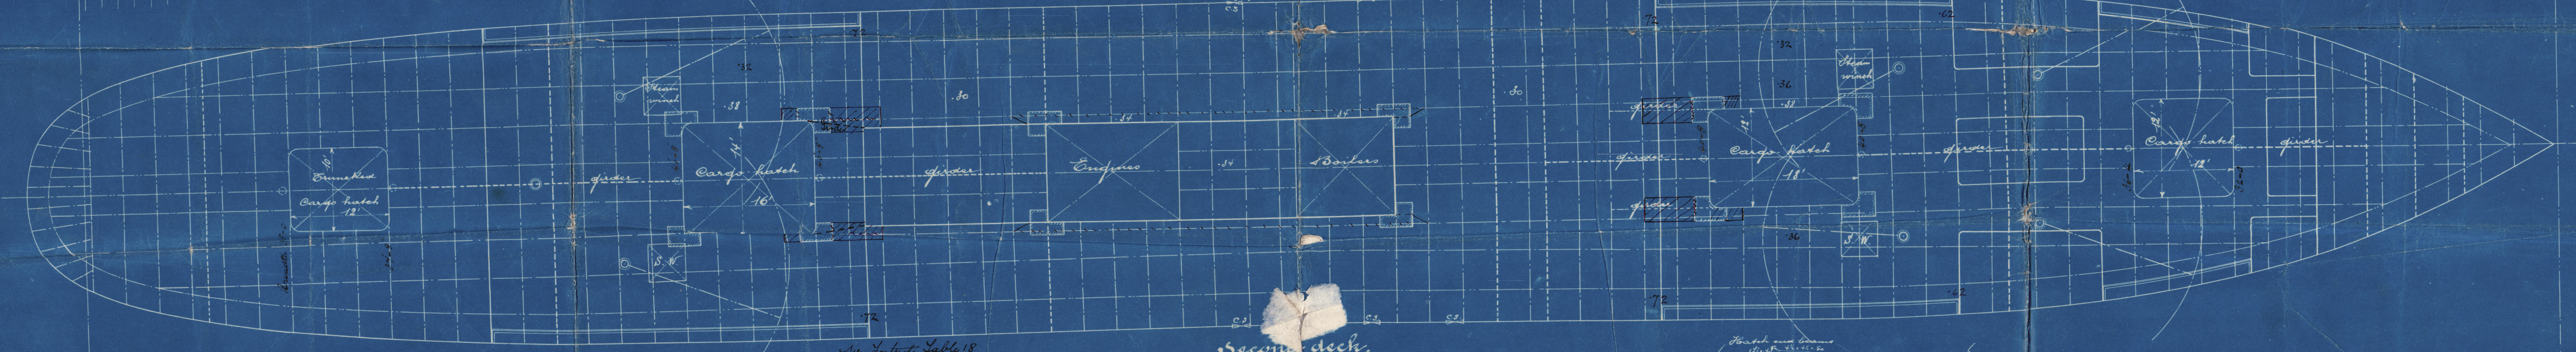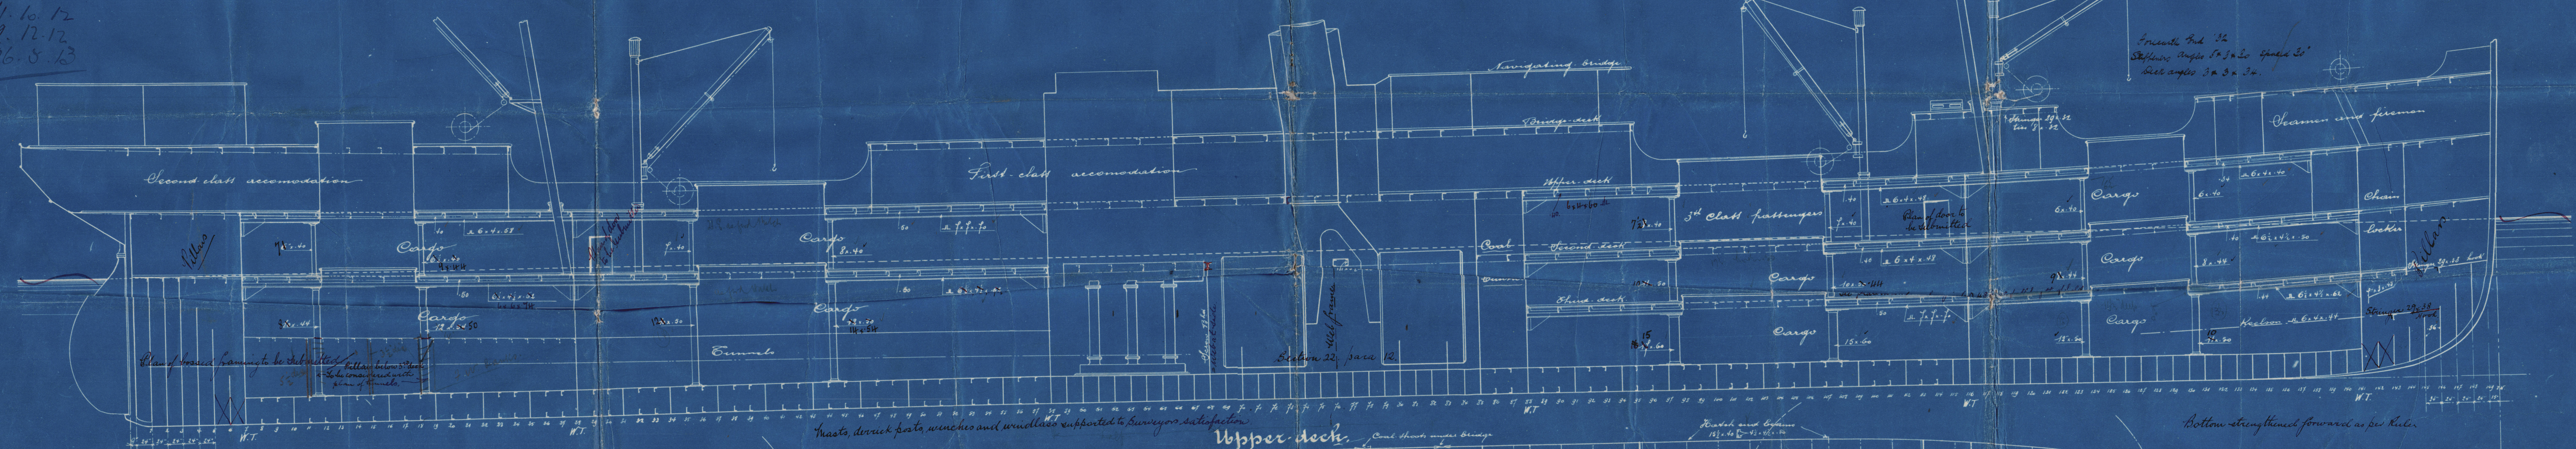

Société Commerciale John Cockrell & Co
 10, rue de la Bourse
 L'Ingénieur en Chef Directeur des Chantiers

C.B.
 20.7.12

(2)

Soc. Anon. John Cockrill.

Profile & Deck plans.

No 535 - 6.

18 JUL 1872

Tzork Michael Theodorowitch
Aut. 1065

also

Tzesarawitch Alexes Nicolaewitch
Aut. 1069 3

LLOYD'S REGISTER OF SHIPPING
RECEIVED
3-OCT. 1872

LONDON.
LLOYD'S REGISTER OF SHIPPING
RECEIVED
1-NOV-72

W602-0292



© 2019

Lloyd's Register
Foundation


~~4 Tank on Side~~
~~M 2 Tank on Port Side~~
~~M 1 Tank full~~

W602-0292



© 2019

Lloyd's Register
Foundation

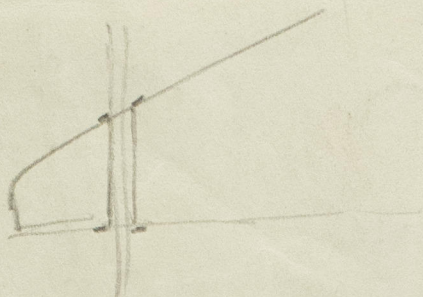

© 2019

Lloyd's Register