

Bassode
Belgium

LLOYDS NUMERALS

DEPTH	9.45
BREADTH	21.50

LYODS NUMERALS

DEPTH ----- 9.75


BREADTH ----- 21.50

TRANSVERSE N° = 31.25

LENGTH ----- 120.0


LONGITUDINAL N° = 3450.00

12-7-11
16-9-11

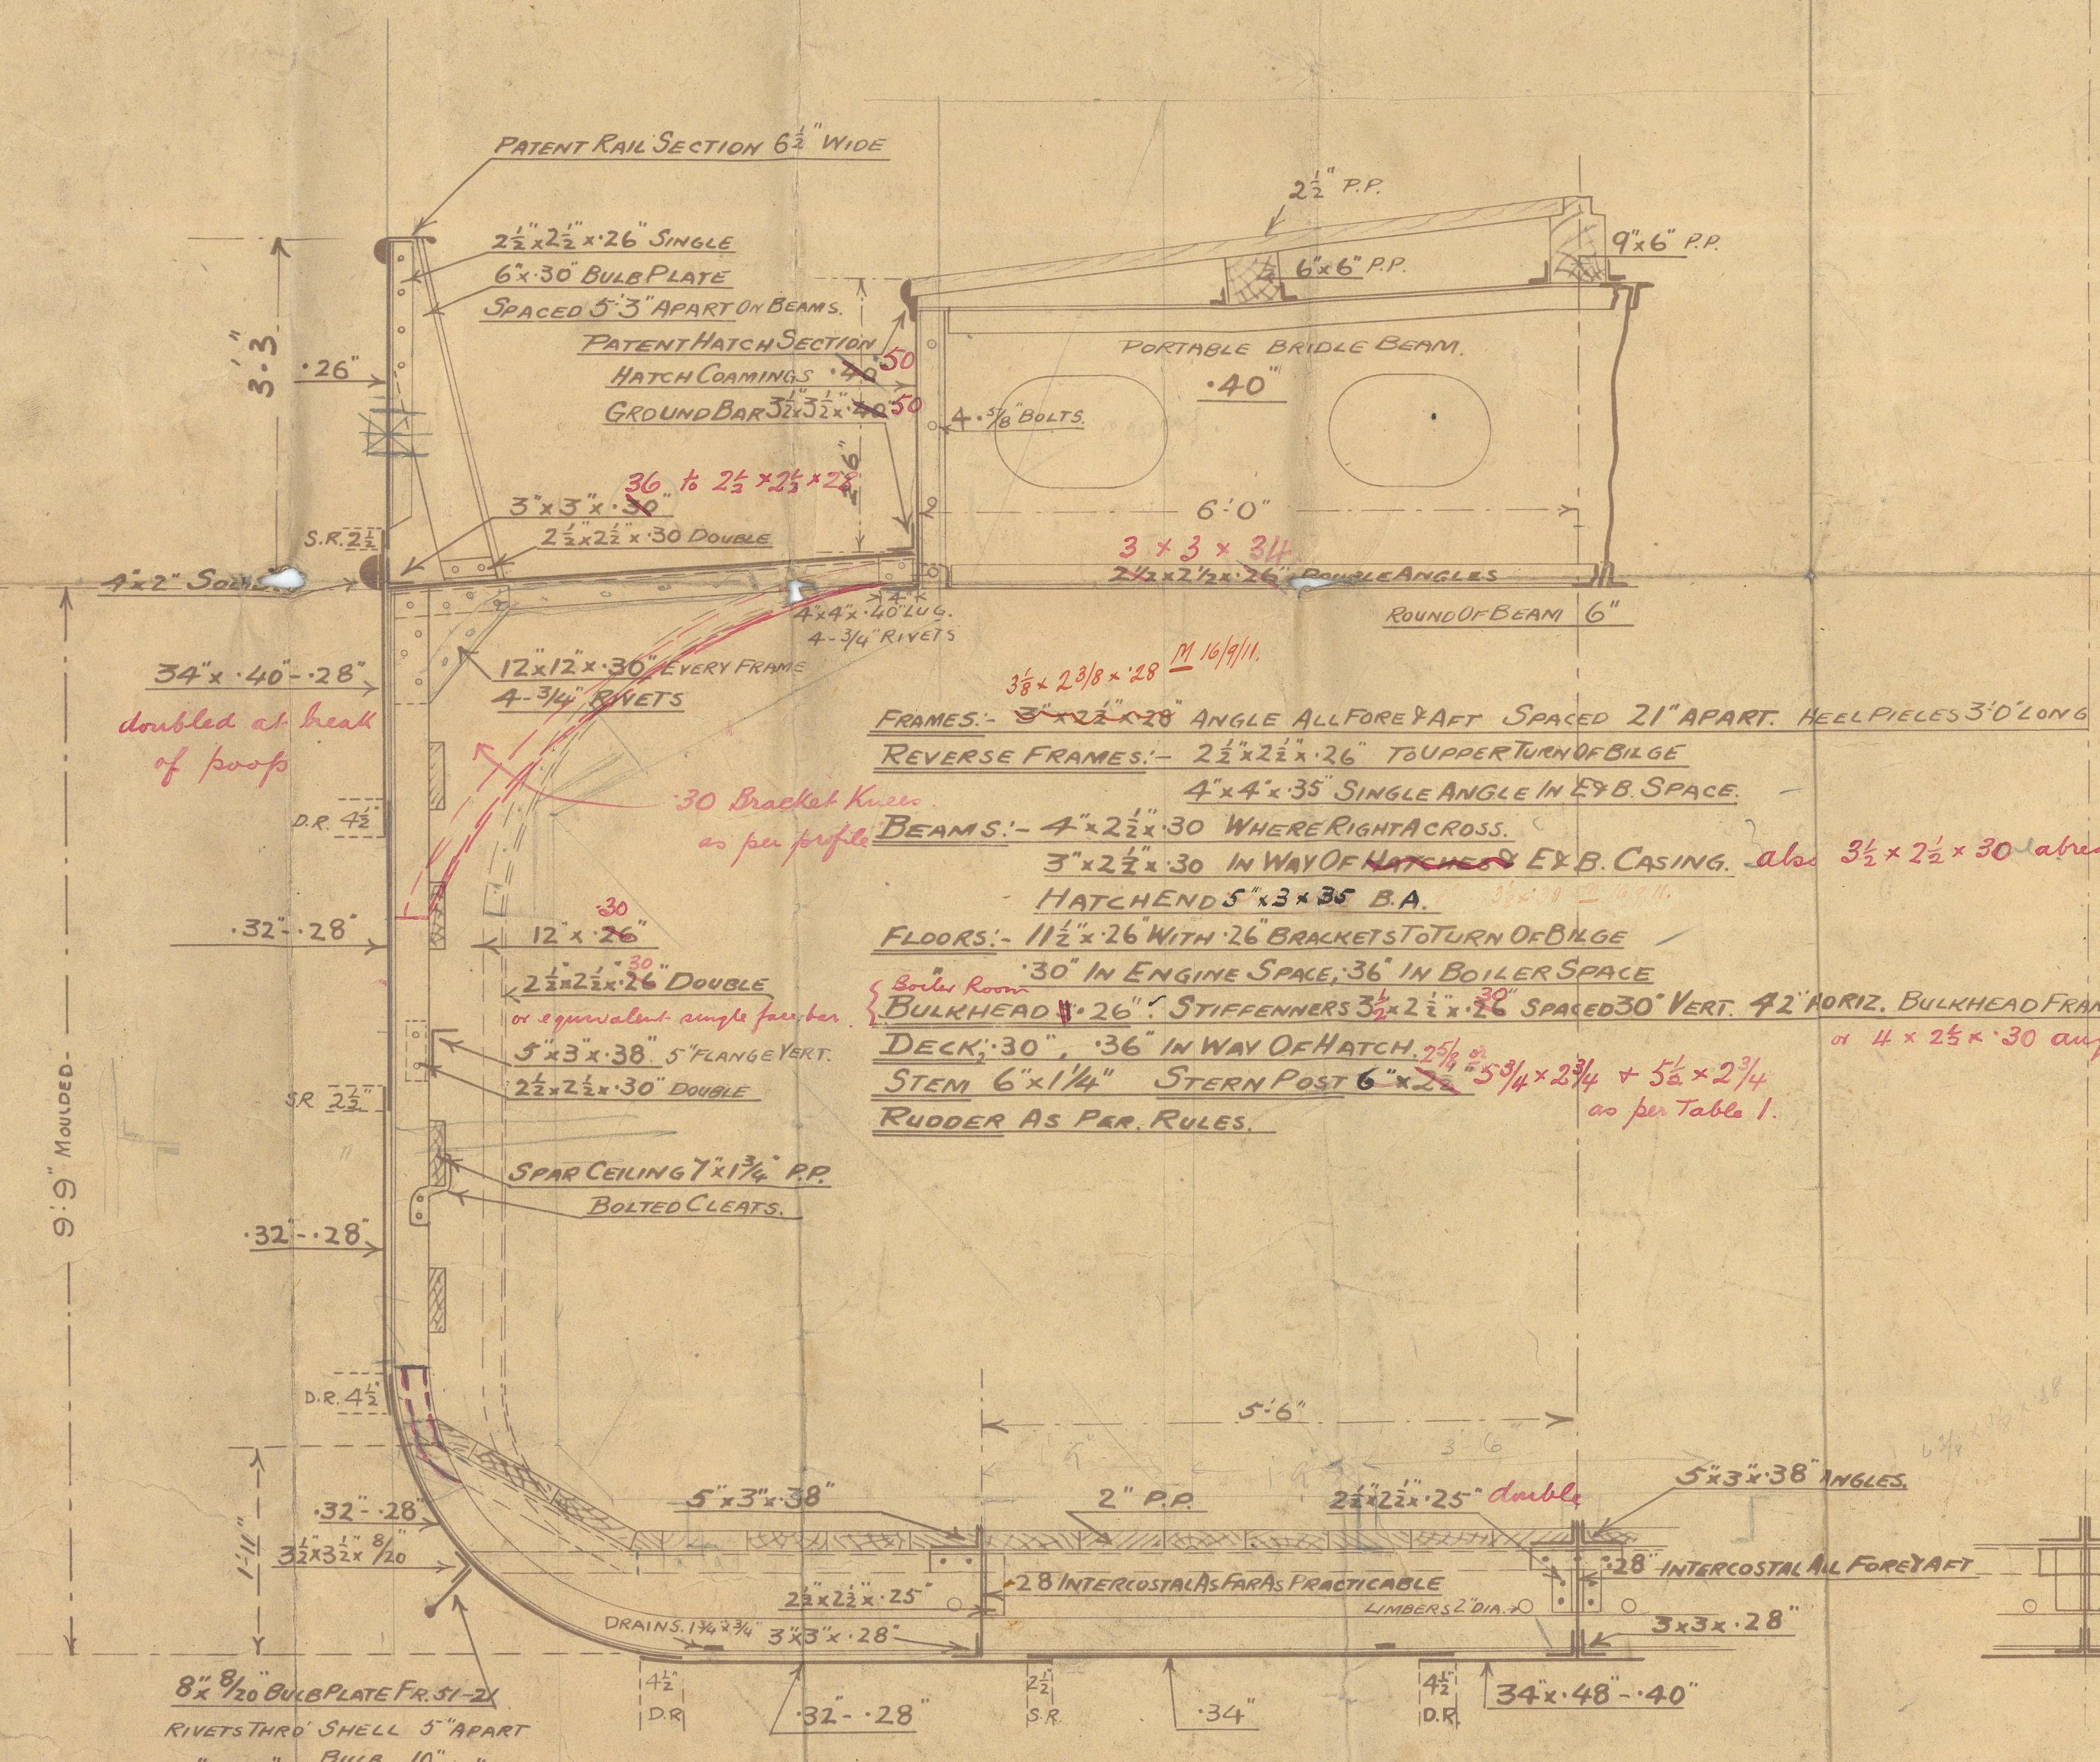

RIVETTING
SHELL PLATING $\frac{3}{4}$ " RIVETS THROUGHOUT.
REMAINDER AS PER RULES.
ALL OUTSIDE WORK AND INSIDE HATCH COAMINGS COUNTERSUNK

- CEMENTING -
CEMENT TO CONSIST OF 50% BEST PORTLAND CEMENT &
50% FINE SAND. THICKNESS 1" WORKED OVER FRAMES &
PARTIALLY UP FLOORS TO SURVEYORS SATISFACTION..

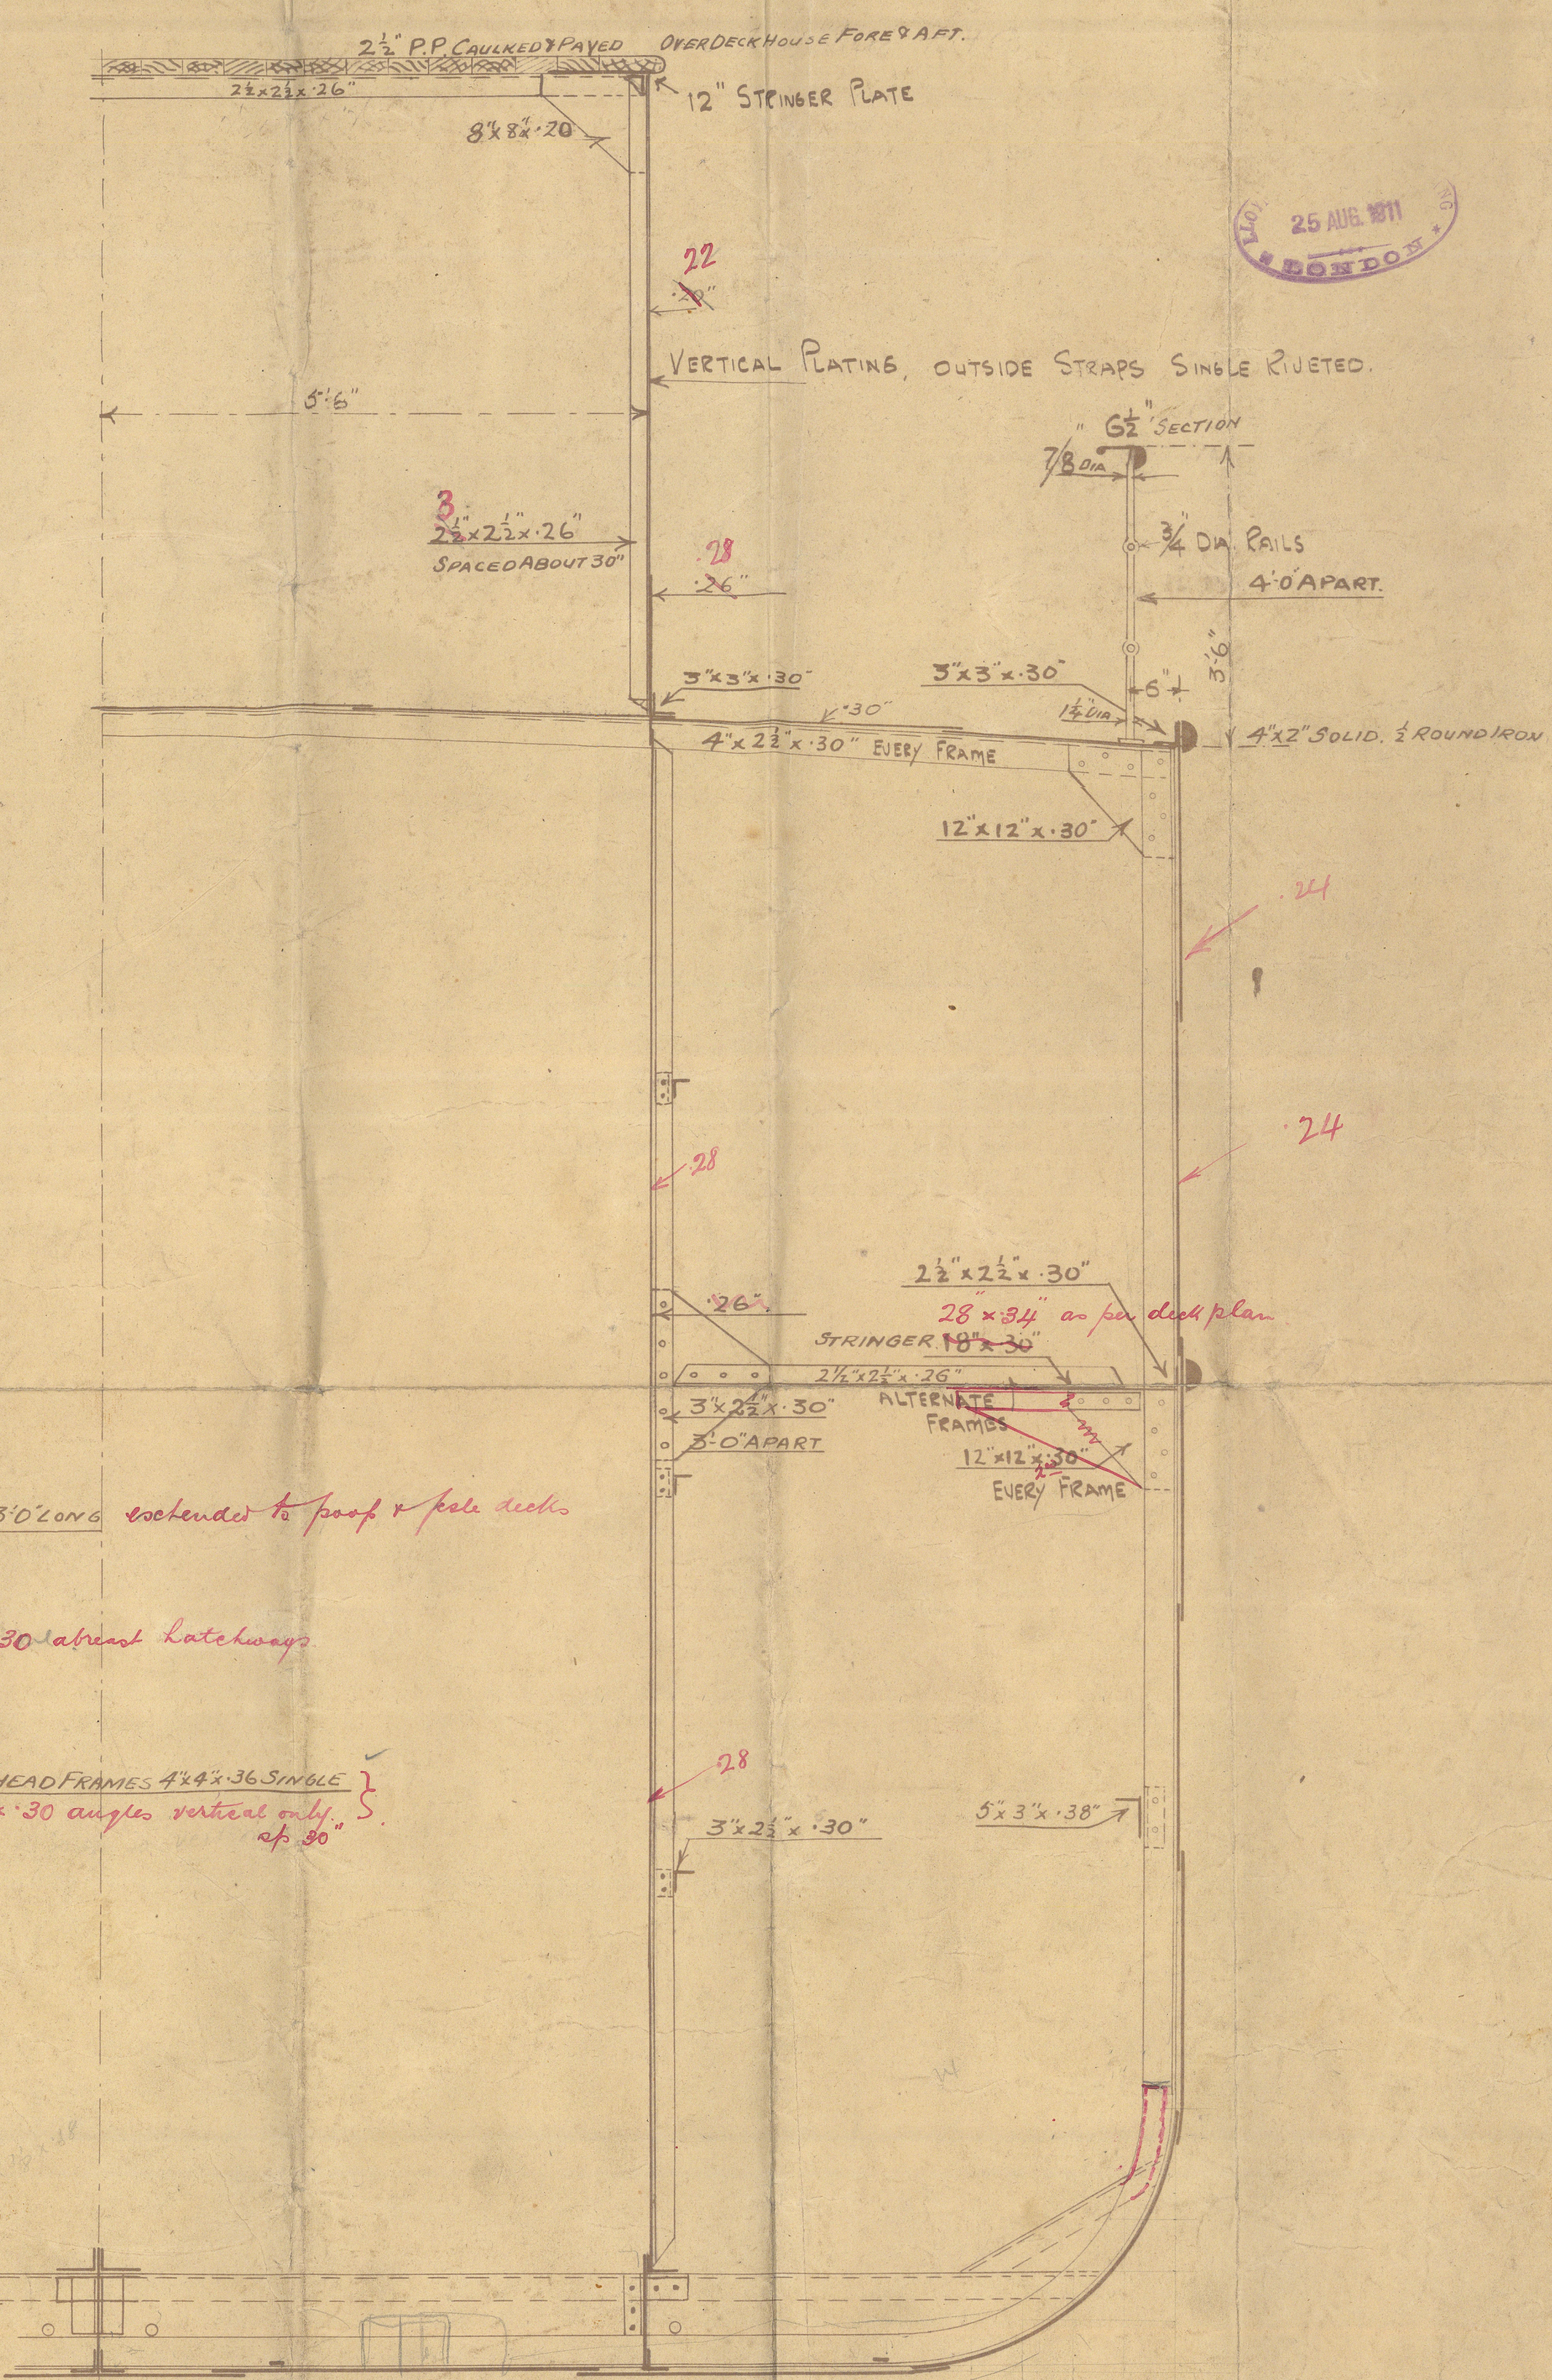

EQUIPMENT.

2-6 CWT. STOCKLESS BOWER ANCHORS.

1-1 3/4" STREAM ANCHOR

1-3/4" KEDGE "


135 FATHOMS 1 1/2" STUD CABLE

45 " 2" STEEL WIRE

75 " 6" MANILLA

90 " 4" "

C. B.
12. 7. 11.

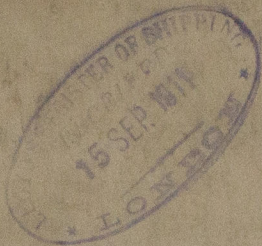

Van Damme Freres & Adam

Nos 355-6.

Midship Section

Antwerp Reports Nos 9884-5.

" "

MATE

Deck No 355

Rosine

Deck No 356

Deck 9485

RETAIN



© 2020

Lloyd's Register

W603-0059
Foundation