


SCALE $\frac{1}{8}$ " = 1 FOOT.

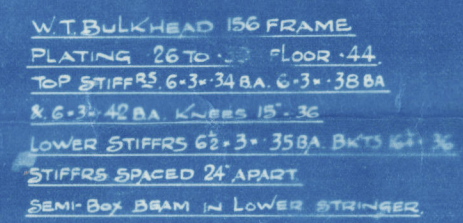

F'CLE DECK

SUNDERLAND

S/S "USWORTH"

MESSRS J. BLUMER & SONS

N° 257

PROFILE (AS BUILT)

SUNDERLAND RPT. NO. 29324

RETAIN



© 2021

Lloyd's Register
Foundation

Woods 0123