

Cochrane & Sons. Ltd.

No. 568.

~~Profile and Deck.~~
Midship Section



135-0 x 23.37 x 13.33.

$\frac{1}{2}$ Macleay

Hull No: 26958.

FOR ENCLOSURE TO
Messrs. Cochrane & Sons Ltd.
FROM
Hull

DATE 10/10/13

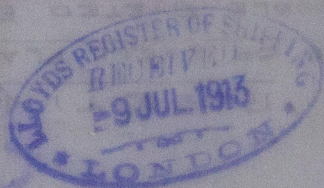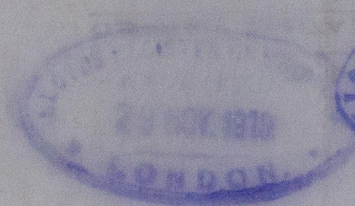

RETAIN



© 2021

Lloyd's Register
Foundation