




SUPPORTED TO ✓

Nº 568

SCALE 1/4 INCH = 1 FOOT

DECK BEAMS 6" x 3" x .45" ✓

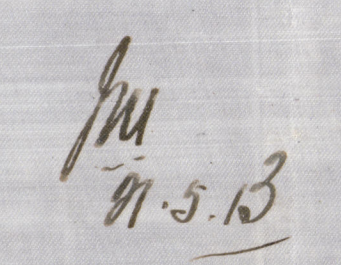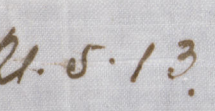



Cochrane & Sons. Ltd.  
No. 568.

~~Midship Section~~  
Profile of Decks  
135-0 x 23-37 x 13-33.

J. Marleay

Drawn Rpt No: 26958

DECK

10 568


0. 23-37 EXT. x 13-33 MID

1/4 INCH = 1 FOOT

RETAIN

BEAMS 6 x 9 x 12

CABIN STIFFENED  
SURVEYORS SATISFIED

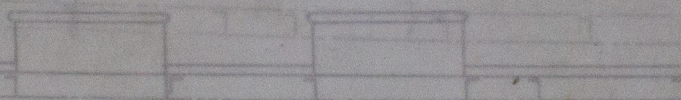

STEEL 2 x 4 x 10



© 2021

Lloyd's Register  
Foundation