

 


8.4.03

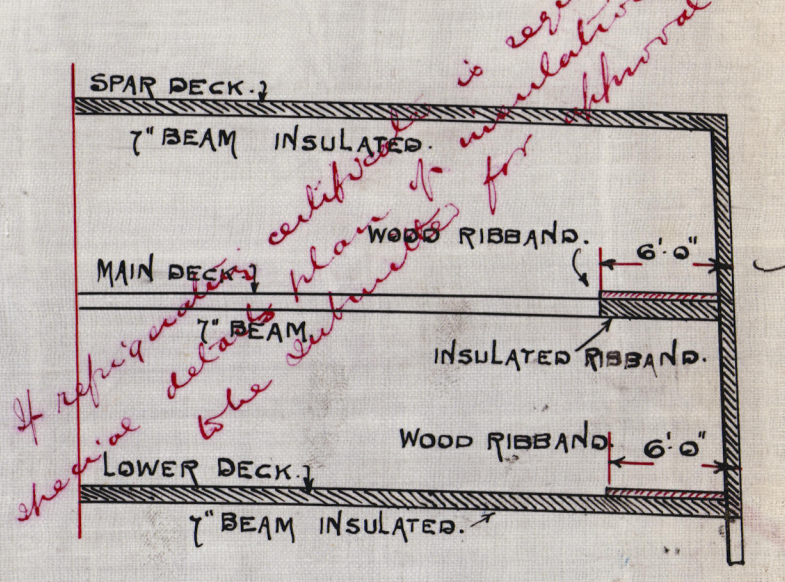

N.B. SMALL DOORS & COAL SHOTS TO BE COMPENSATED FOR TO SURVEYORS SATISFACTION.

LLOYDS DECKS.
TWIN SCREW STEAMER. h=403
460' x 55'6" x 36'0"
SCALE 1/8" = ONE FOOT.

 

Alex. Stephen & Sons Ltd
SHIPBUILDERS & ENGINEERS.
65 A S E O W
BRAYNE ME 2722
APRIL 22ND 1903

a. Stephen & Sons.

J. Sfs. N° 403.

Plan of lower & oiler decks.

See also ~~another~~ plan of lower
deck in Machinery Case.

Port Kingston
No report No 21984.



© 2021

Lloyd's Register
Foundation