


**N<sup>o</sup> 403**

**MAIN BOILERS**

**3 OFF THUS**


**SCALES - 1" & 3" = 1 FOOT.**



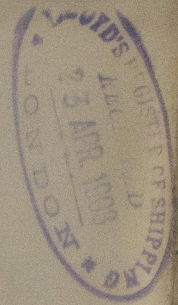

*A. Stephensons  
Berth No 403  
Single ticket  
Port Kingston  
His report No 21984*

RETAIN

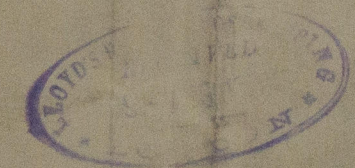

RETAIN



© 2021  
Lloyd's Register  
Foundation