
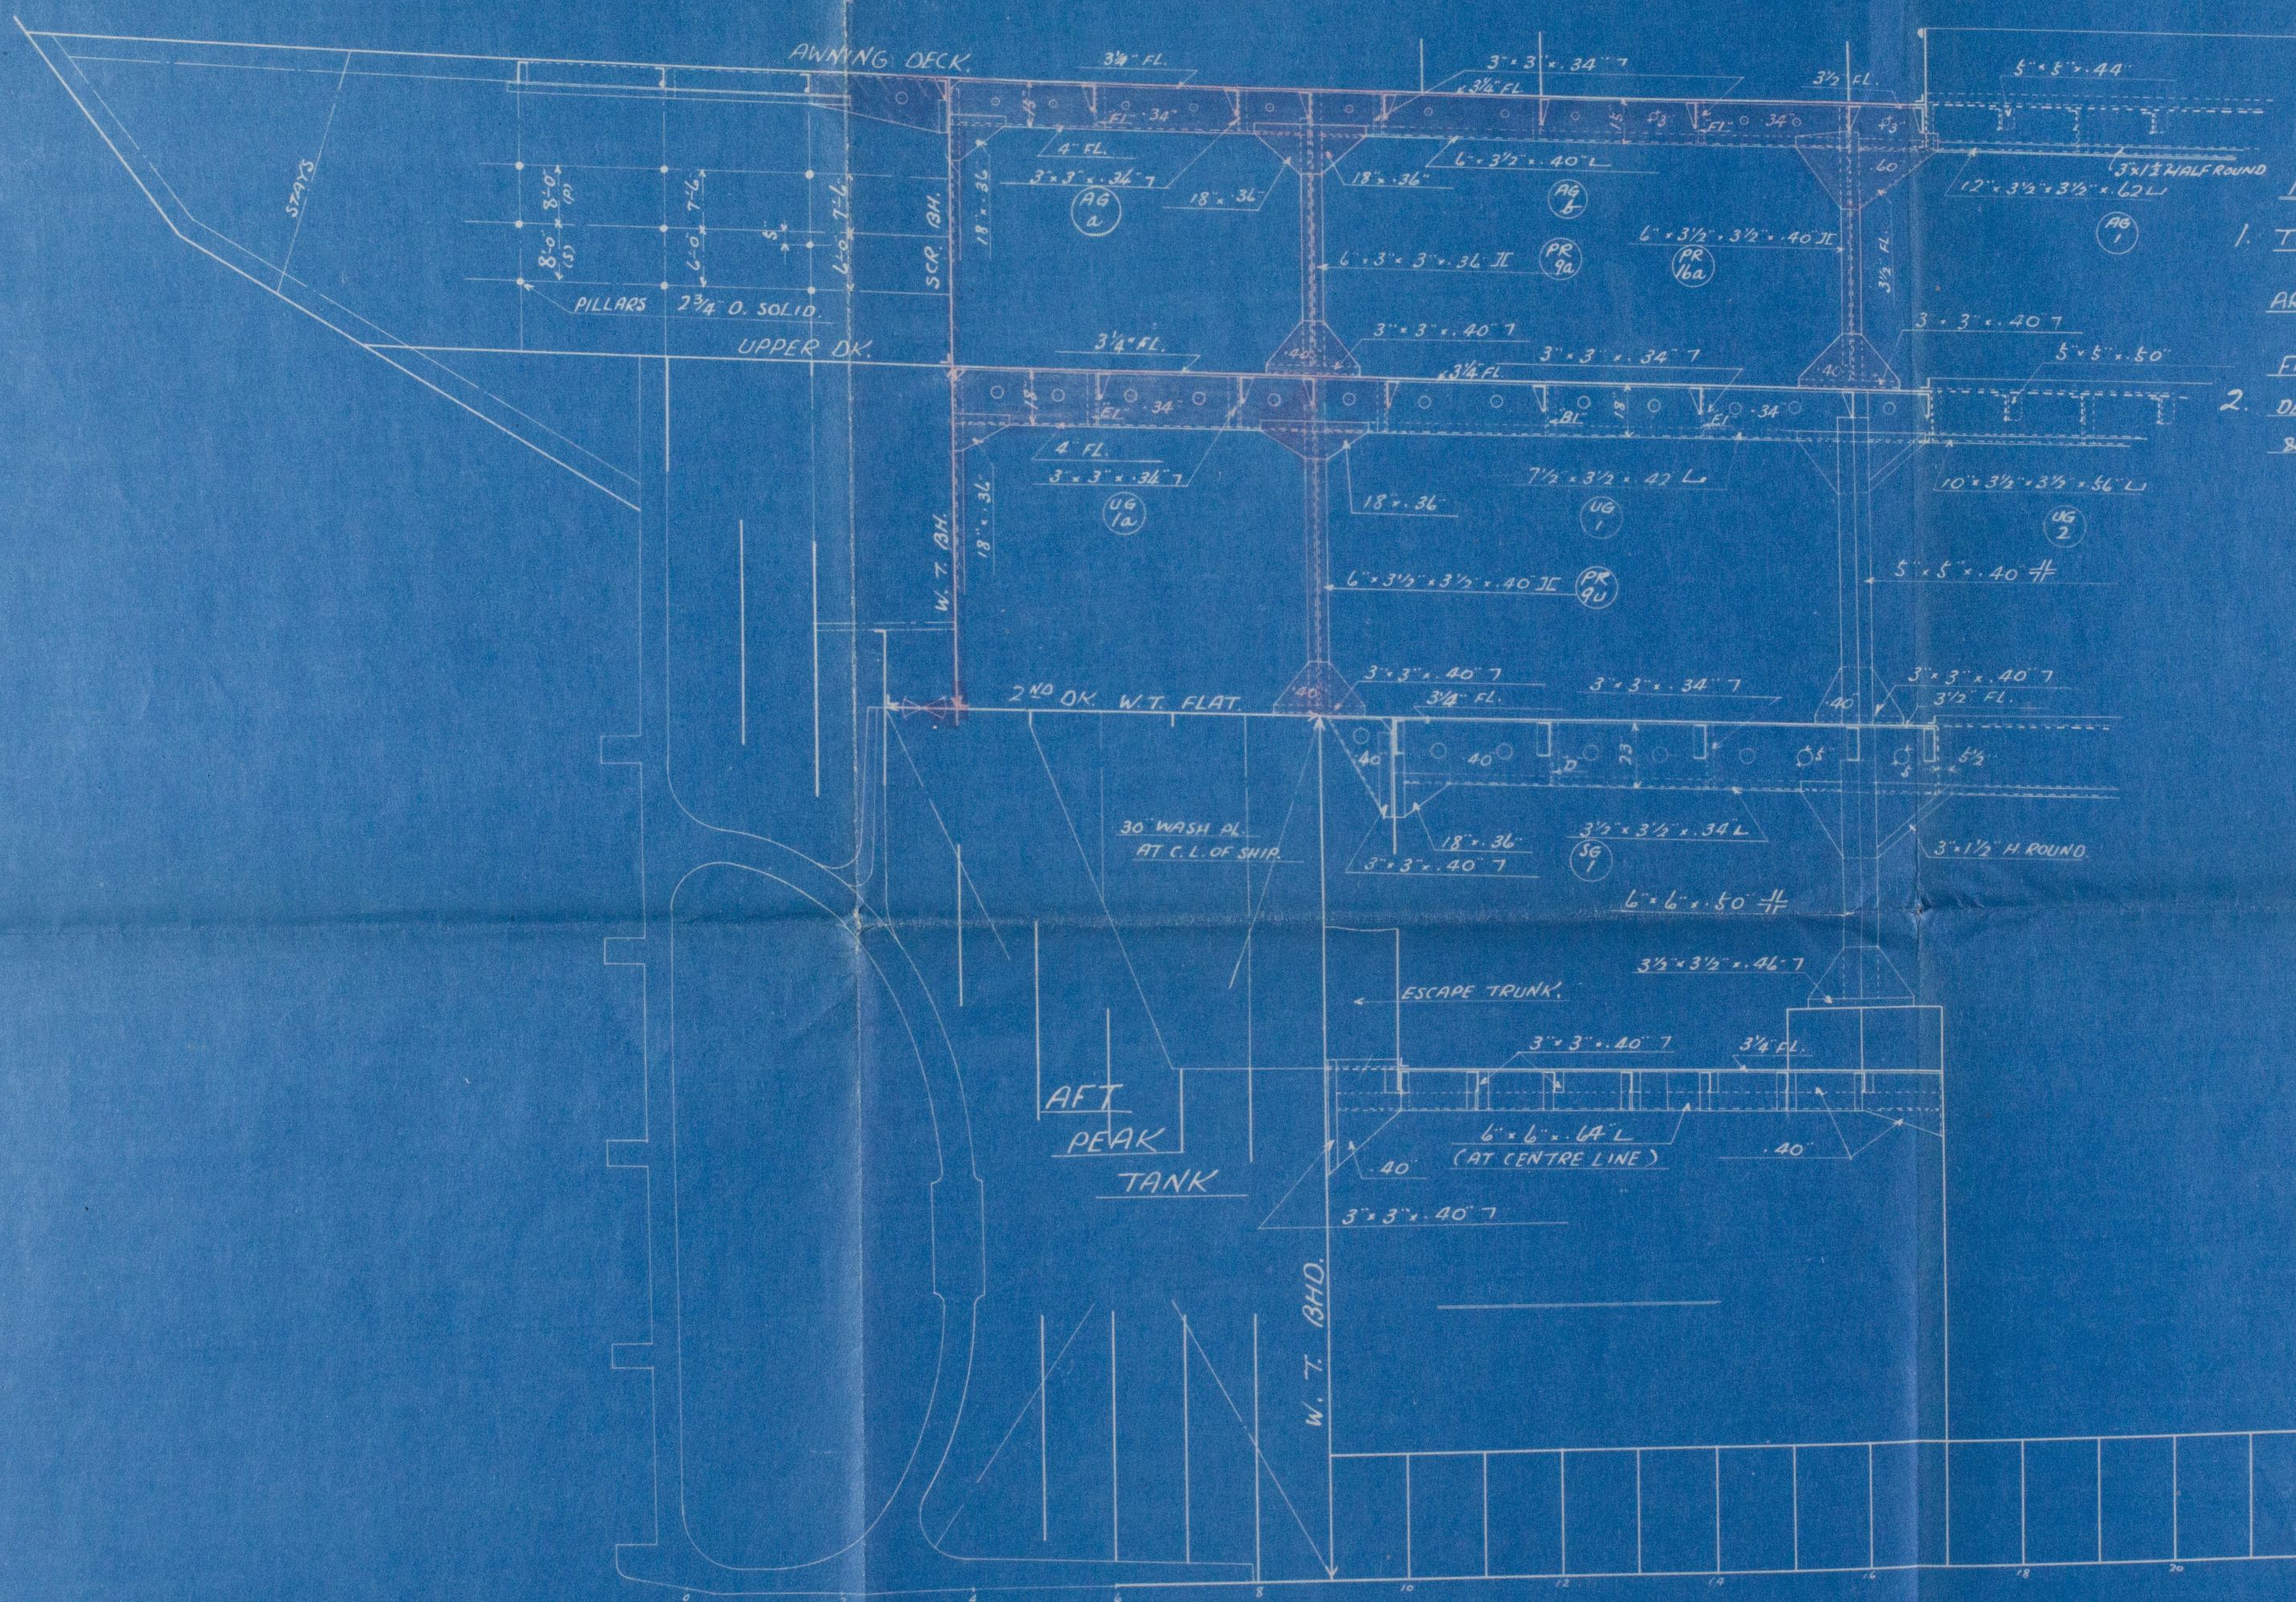


Nº 481 & 3.

# ADDITIONAL DK. GIRDERS. & PILLARS.



SCALE 1/4" = 1'-0" PLAN Nº 41A

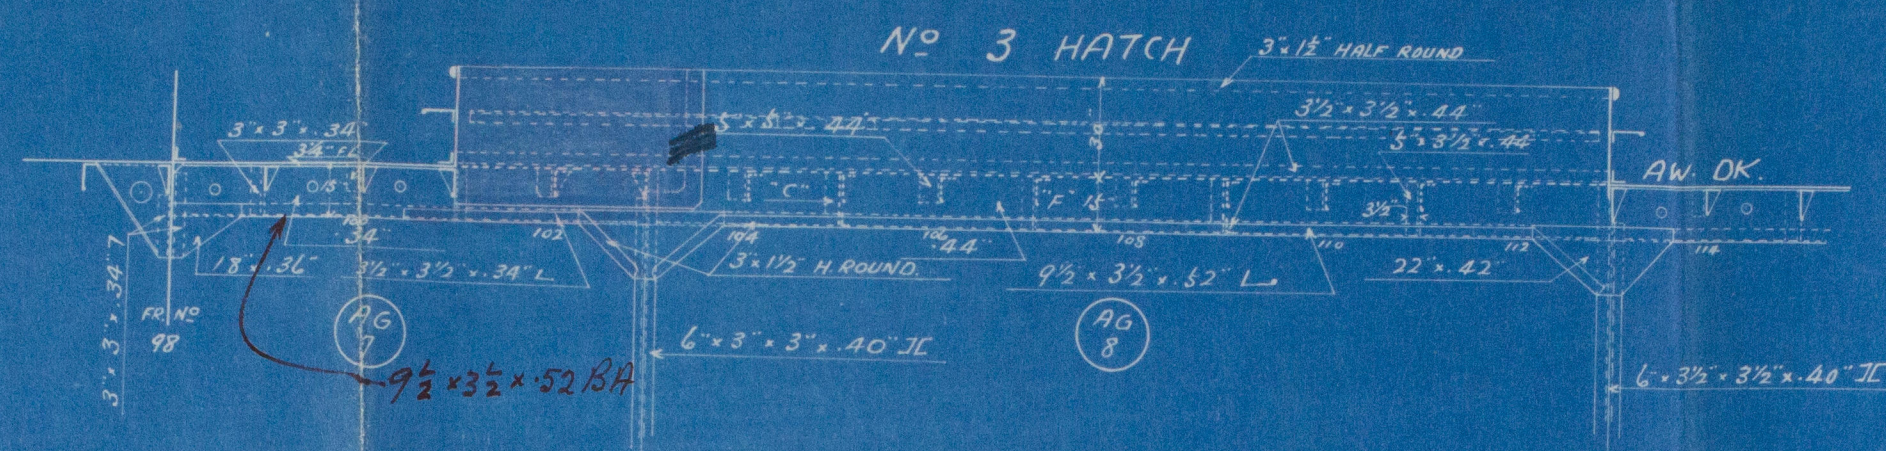

N. 8

1. TINTED GIRDERS & PILLARS ARE THOSE ADDITIONALLY FITTED.
2. DETAILS OF ATTACHMENT OF GIRDER & W.S. PILLARS ARE AS PER PLAN Nº 41 & 42.

APPROVED

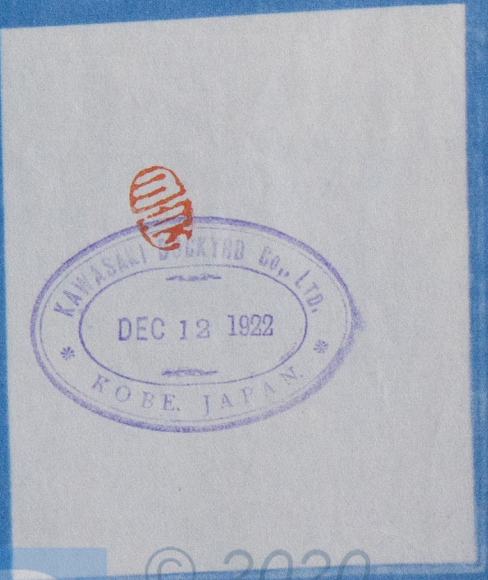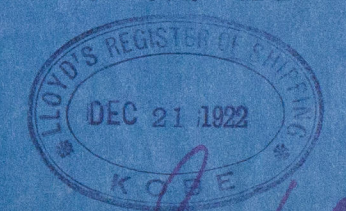



APPROVED PLAN "B"

Kawasaki No 481 + 483

Alterations at Aft End  
and at No 3 Hatchway

S/S RHINE MARU No 481.

Kobe Rpt No 3920

RETAIN



© 2020

Lloyd's Register  
Foundation

W606-0118