

16.3.11

PROFILE & DECK PLAN



N^o. 497 & 8.

DIM^s 141'-8" x 24'-0" x 13'-4" M.L.D.

SCALE 1/4" = ONE FOOT.

Pillars throughout to Surveyors satisfaction

PLAN No. 98
FOR ENCLOSURE TO
Messrs Lloyds Surveyors
Hull FROM
COCHRANE & SONS
SHIPBUILDERS LTD
DATE 11/3/11 RL

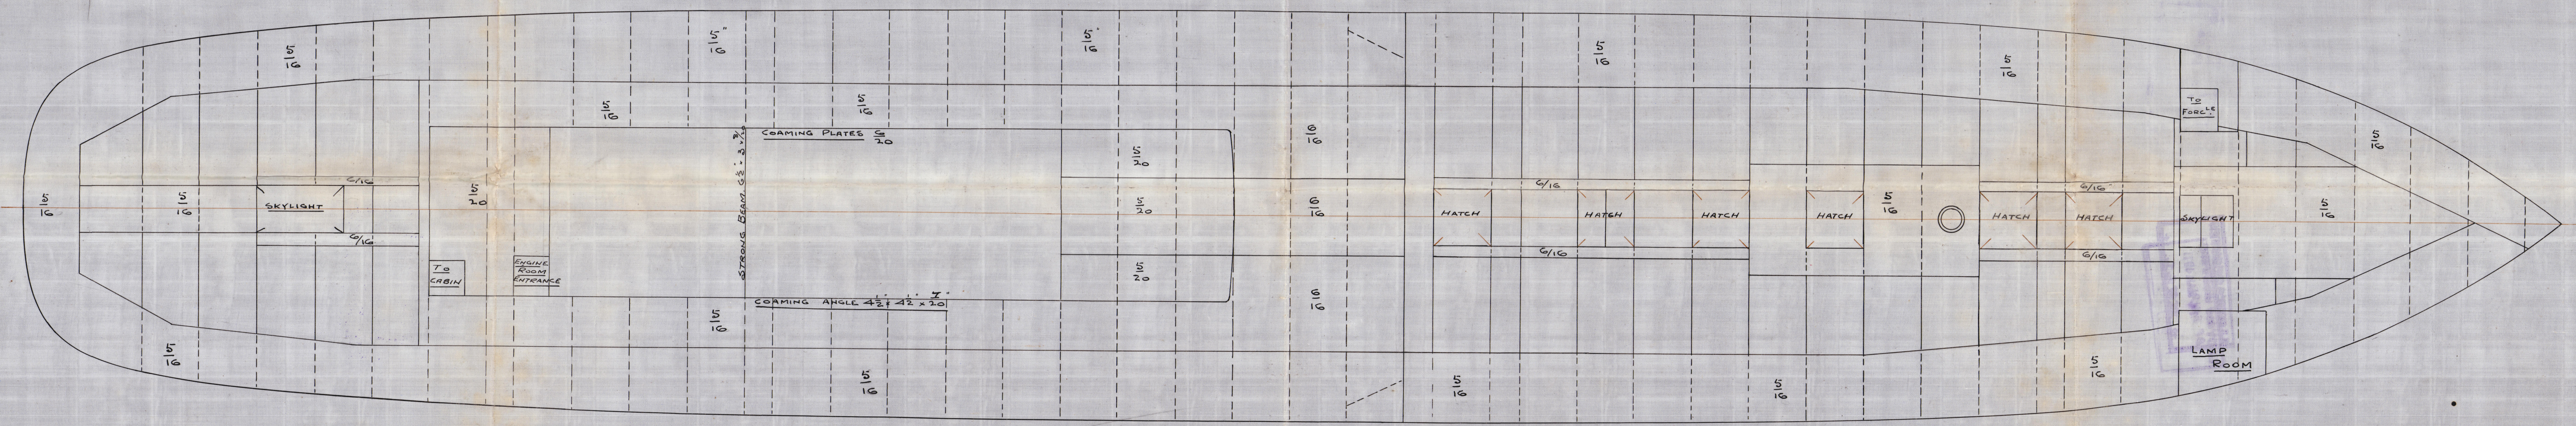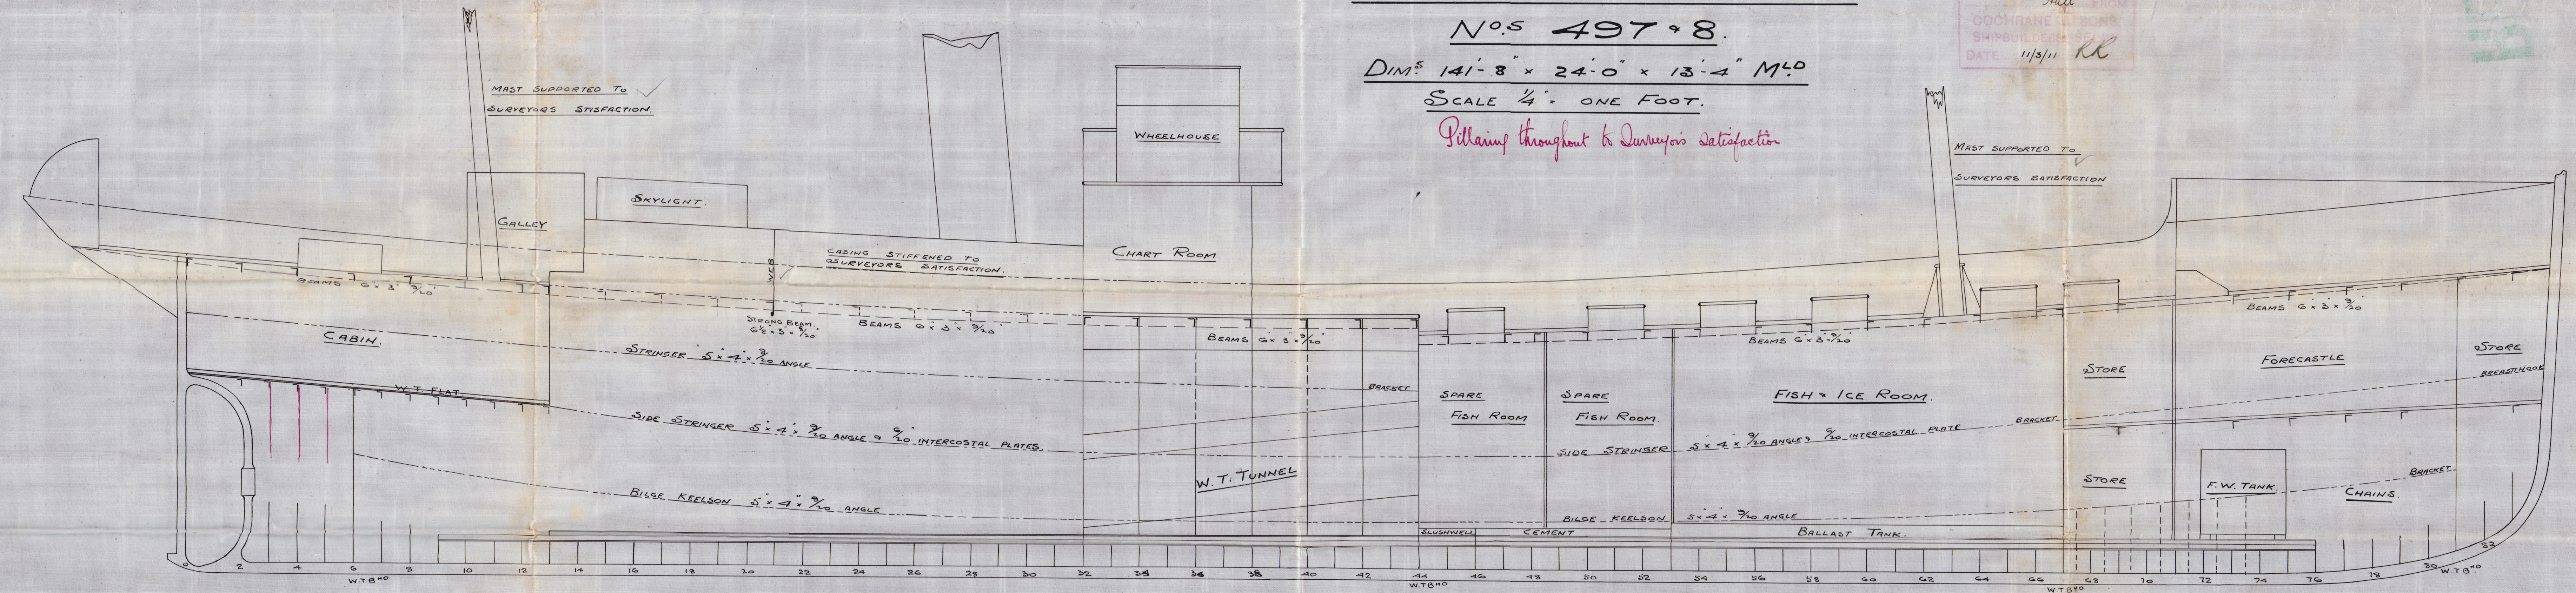

PILLARS THROUGHOUT TO SURVEYORS SATISFACTION.

C.B.
16.3.11.

-Profile + Deck Plan-

Cochrane & Sons

- Nos 497-8 -

s/s Drypool Hull Rpl No. 24460

- Sutton - - - 24446

RETAI



© 2021

Lloyd's Register
Foundation

W607-0130