

Copy of approved midship section to
accompany first entry report.
No. 13665

Midship Section

S.S. 7605 ~~126~~ + 488

Dimensions 345' x 49' 9" x 49' 4" x 28' 5" mid to Spar Deck

1/2 class 100 A-1. at Lloyds & Spar Deck Rule


Scale 1/2" = one foot

20.2.02
20.5.02

Bridge 202 ft

Steel Deck 7/16". Wood deck in way of Housings

Stringer 40 x 7/16" flanged to shell
Bulls lapped 1/2" R. 3/16" x 10

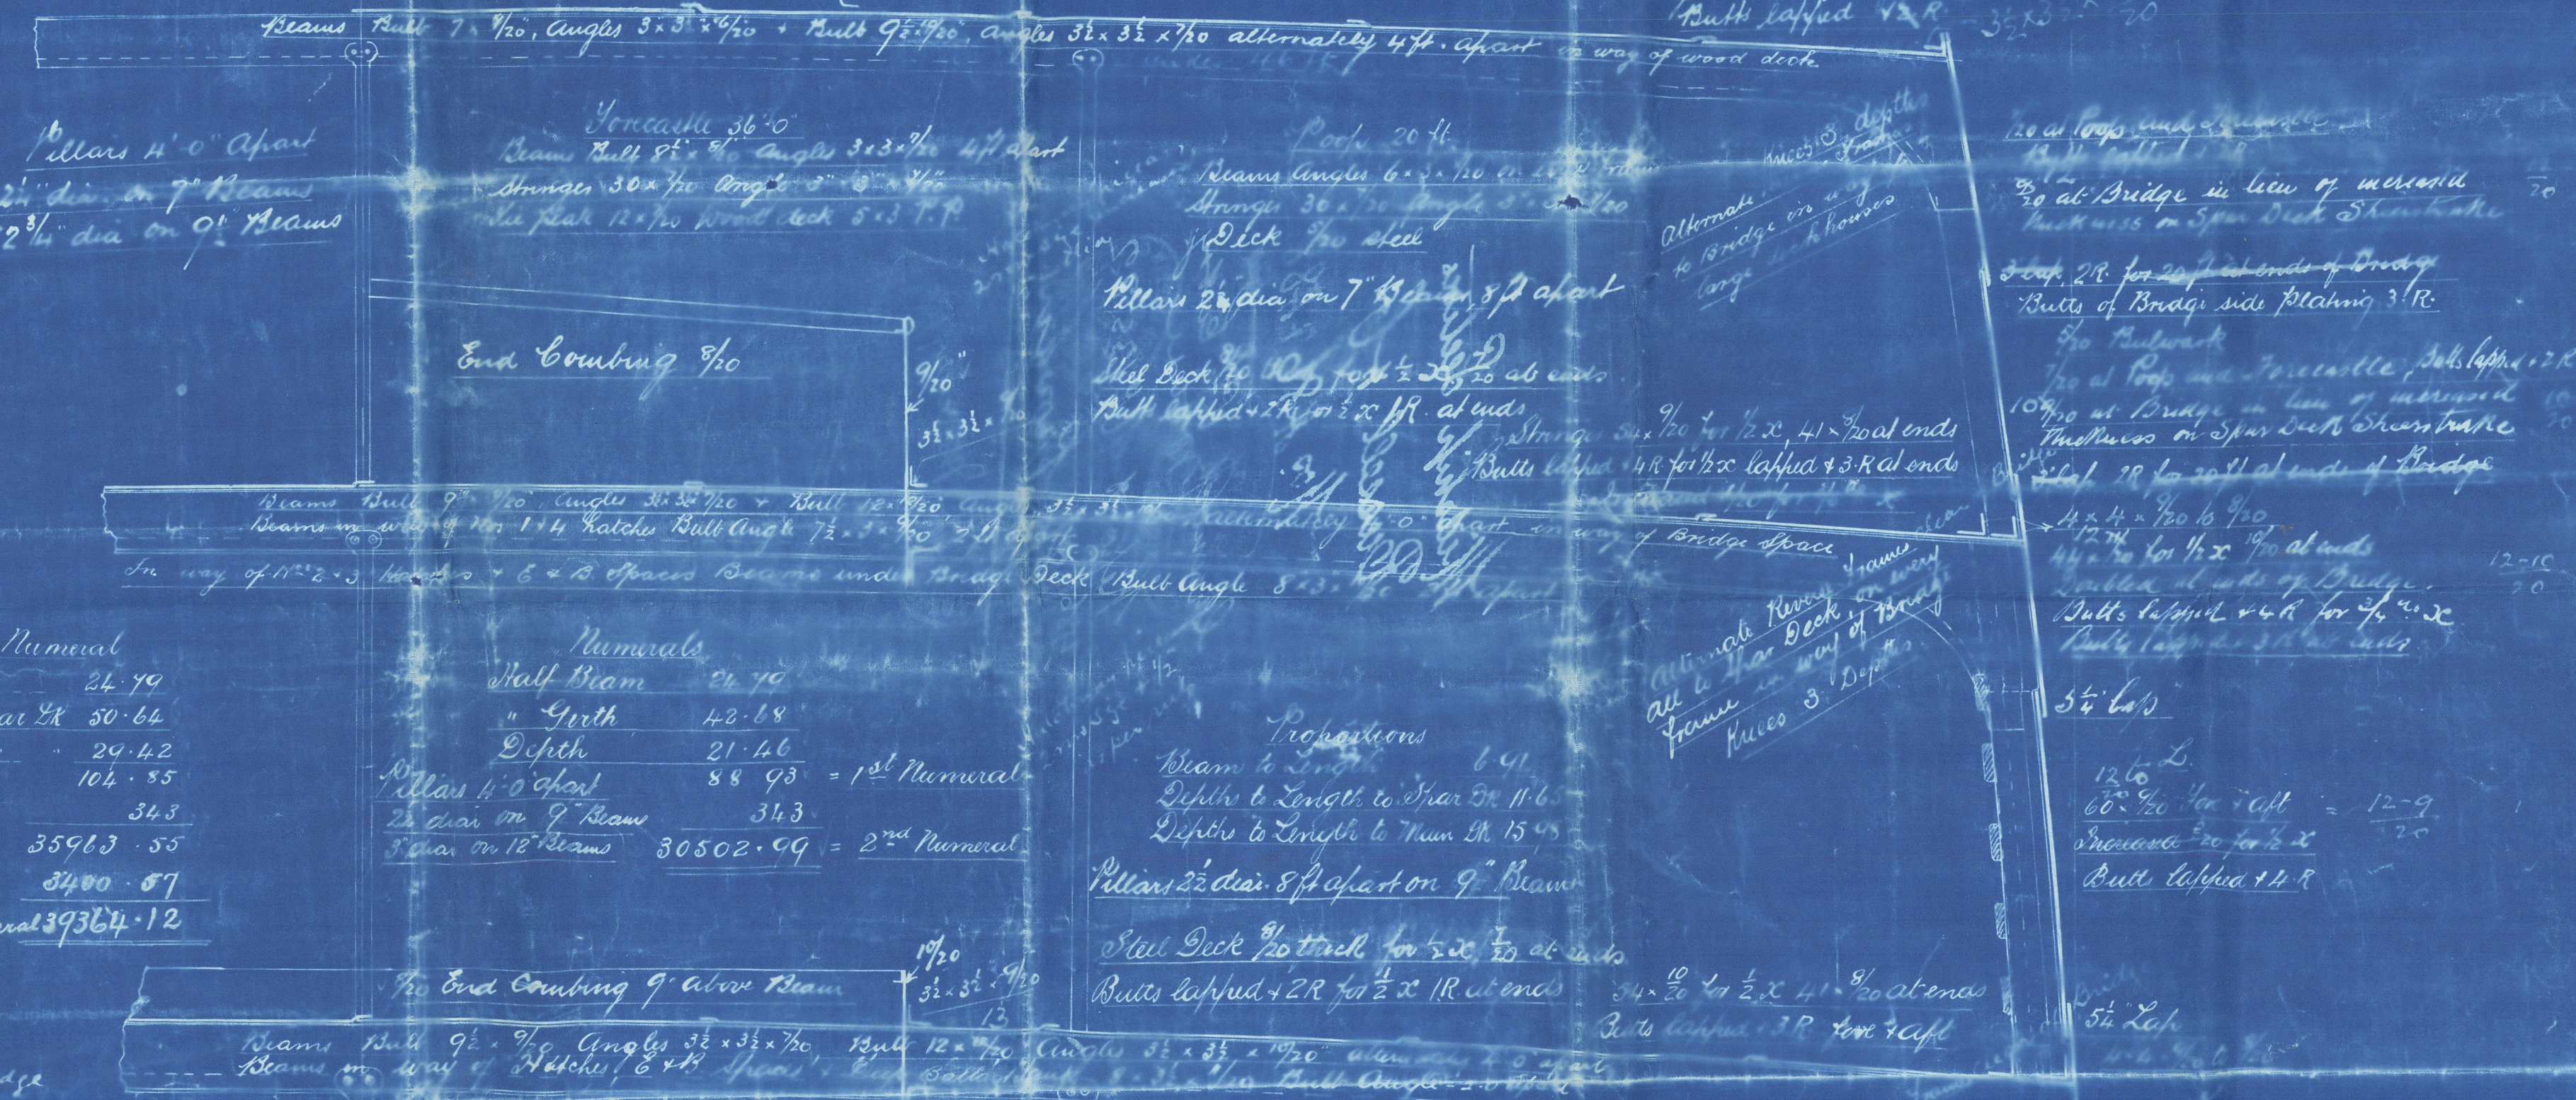

Equipment Manual	
Half Beam	24.99
Half Girth to Spar Deck	50.64
Depth to	29.42
	104.55
	34.3
	35963.55
Exclusions	3400.87
Equipment Manual	39364.12

Manuals	
Half Beam	24.99
" Girth	42.68
Depth	21.46
Pillars 4' 0" apart	88.93 = 1st Manual
2 1/2" dia on 9 Beams	34.3
3 1/2" dia on 12 Beams	30502.09 = 2nd Manual

Proportions
Beam to Length 6.41
Depth to Length to Spar Deck 11.6
Depth to Length to Main Deck 15.95

Pillars 2 1/2" dia 8 ft apart on 9" Beams

Steel Deck 7/16" thick for 5' x 5' at ends

Bulls lapped 1/2" R. for 1/2" x 1/2" IR at ends
34 x 20 for 1/2" x 41 x 20 at ends
Bulls lapped 1/2" R. for 1/2" x 1/2"

Equipment	
1 Beam Under 40 Cuts in Stock	
1 Beam	38
1 "	36
1 "	12
1 Ridge	6

270 Fathom 2 1/2" Steel Chain Cable 573.2.14
90 " 1 1/2" Stream Steel Chain 44.2 Steel Wire 98
120 " 1 1/2" Stream or 4 1/2" Steel Wire
90 " 7" Hauls to 2 1/2" " 4 9 ft

Plate 36 x 20 for 3/16" x 1/2" at ends
Pipelay East connect to deck plating. Ladder 9 at head 4 1/2" at front
Beams 32 x 32 x 7/16" for 3/16" x 8 7/16" at ends
Kerene Frames 6 x 3 1/2" x 7/16" for 3/16" x 7/16" at ends
all to spar deck above after plate bulkhead. Alternately to Forecastle. 4.5 x 3/16" in peak
Double under engine 3 1/2 x 3 1/2 x 3/16" from margin to margin plate. Single under Boiler 6 x 3 1/2 x 3/16"
Bulkheads Lower half 3/16" upper half 5/16" Vertical Stiffeners Bulkheads 8 x 3 1/2 x 3/16" spaced 30
apart - 1 bracket to Tank Top - Angles 4 x 3 1/2 x 3/16" between main & Spar Decks
Bulkheads 5/16" x 3 1/2" horizontally to main for lower half
Joints 7/16" x 3 1/2" spaced 30 ft apart 30 ft below bulkhead 30 ft plating at bulkhead
After Hoods of plating on propeller port 6 1/2" frame thickness as main bulkhead
Cross Plates and plates above and below same 30 ft apart
Rods in Shell and Stinger Bulls 3 1/2" diam 8' 6" 0"
Rods in Frames and Kerene frames frame & shell plating 7 diam 8' 6" 0"
Rods in Stem - Sternpost 1 1/2" diam 8' 6" 0" 6" 0"
Rods in Bulkheads of inner bottom plating 4 diam 8' 6" 0"
Before 3/16" x rods in bottom frames 3 1/2" diam 8' 6" 0"
Before 3/16" x rods in plate (main) in way of Tank 4 diam 8' 6" 0"
Frames to be joggled as in previous Cues

All parts of Double Bottom in Boiler Room
measured 1/20" except floor, 1/16" plating which are
measured 1/20" and 1/16"

Pillars 4' dia 8' 0" apart on 9" Beams

measured at ends as per rule

measured at ends as per rule

Copy of Madship Section


S.S. Mercury

Grk 1st Entry report

N^o. 13661.

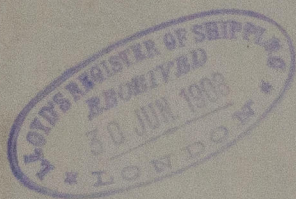


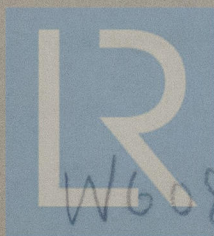

© 2021

Lloyd's Register
Foundation

W608-0191