

# PROFILE & DECK PLAN.


PILLARING THROUGHOUT  
TO SURVEYOR'S SATISFACTION  
DIMENSIONS 147'-0"BP x 25'-0"MLD x 14'-6"MLD  
SCALE 1/4" = 1 FOOT.

S/T TERVANI.

Nº 473.

COOK WELTON & GEMMELL LTD  
SHIPBUILDERS  
BEVERLEY

SUBMITTED TO LLOYDS  
APPROVED BY 28/1/25

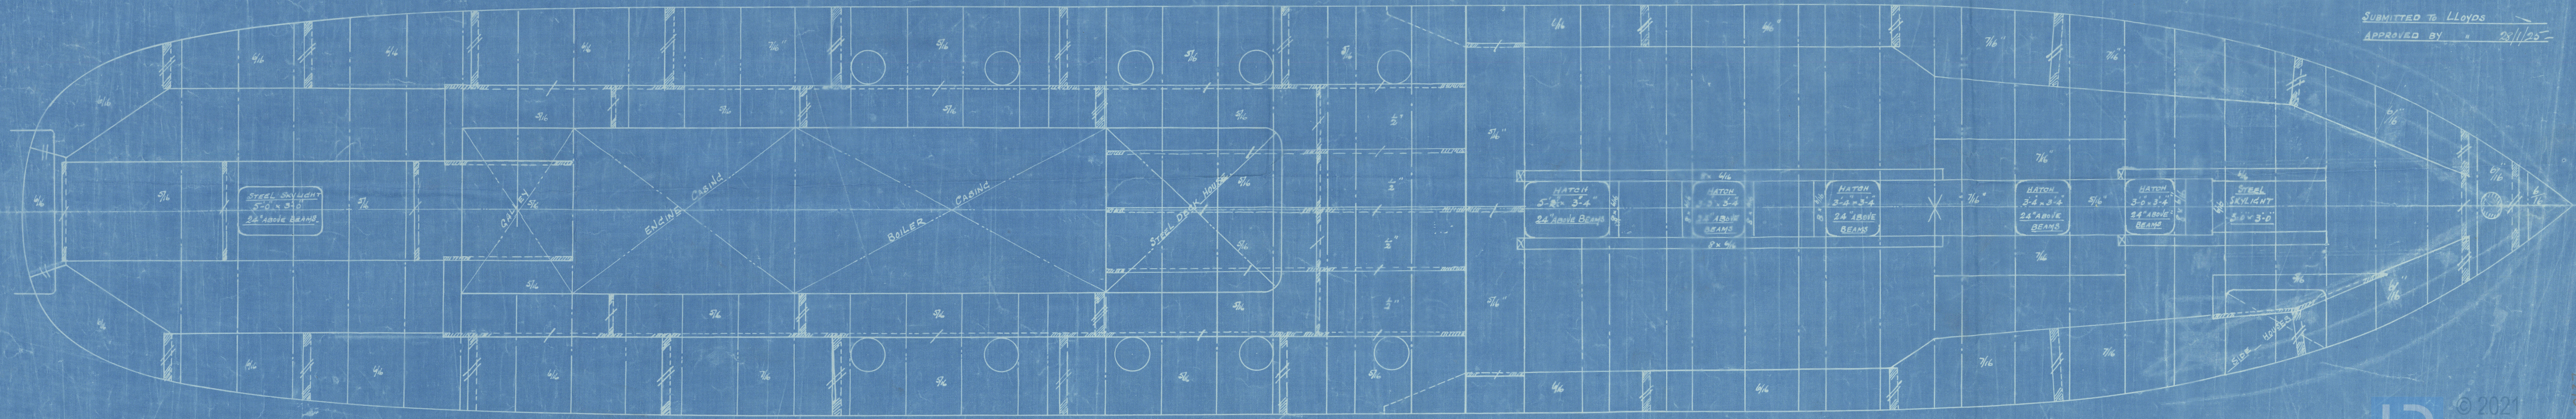



Profile + Deck  
as fitted

S/T TERVANI.

Hull Report No. 36664.

W61-0137



© 2021

Lloyd's Register  
Foundation