



30.12.11

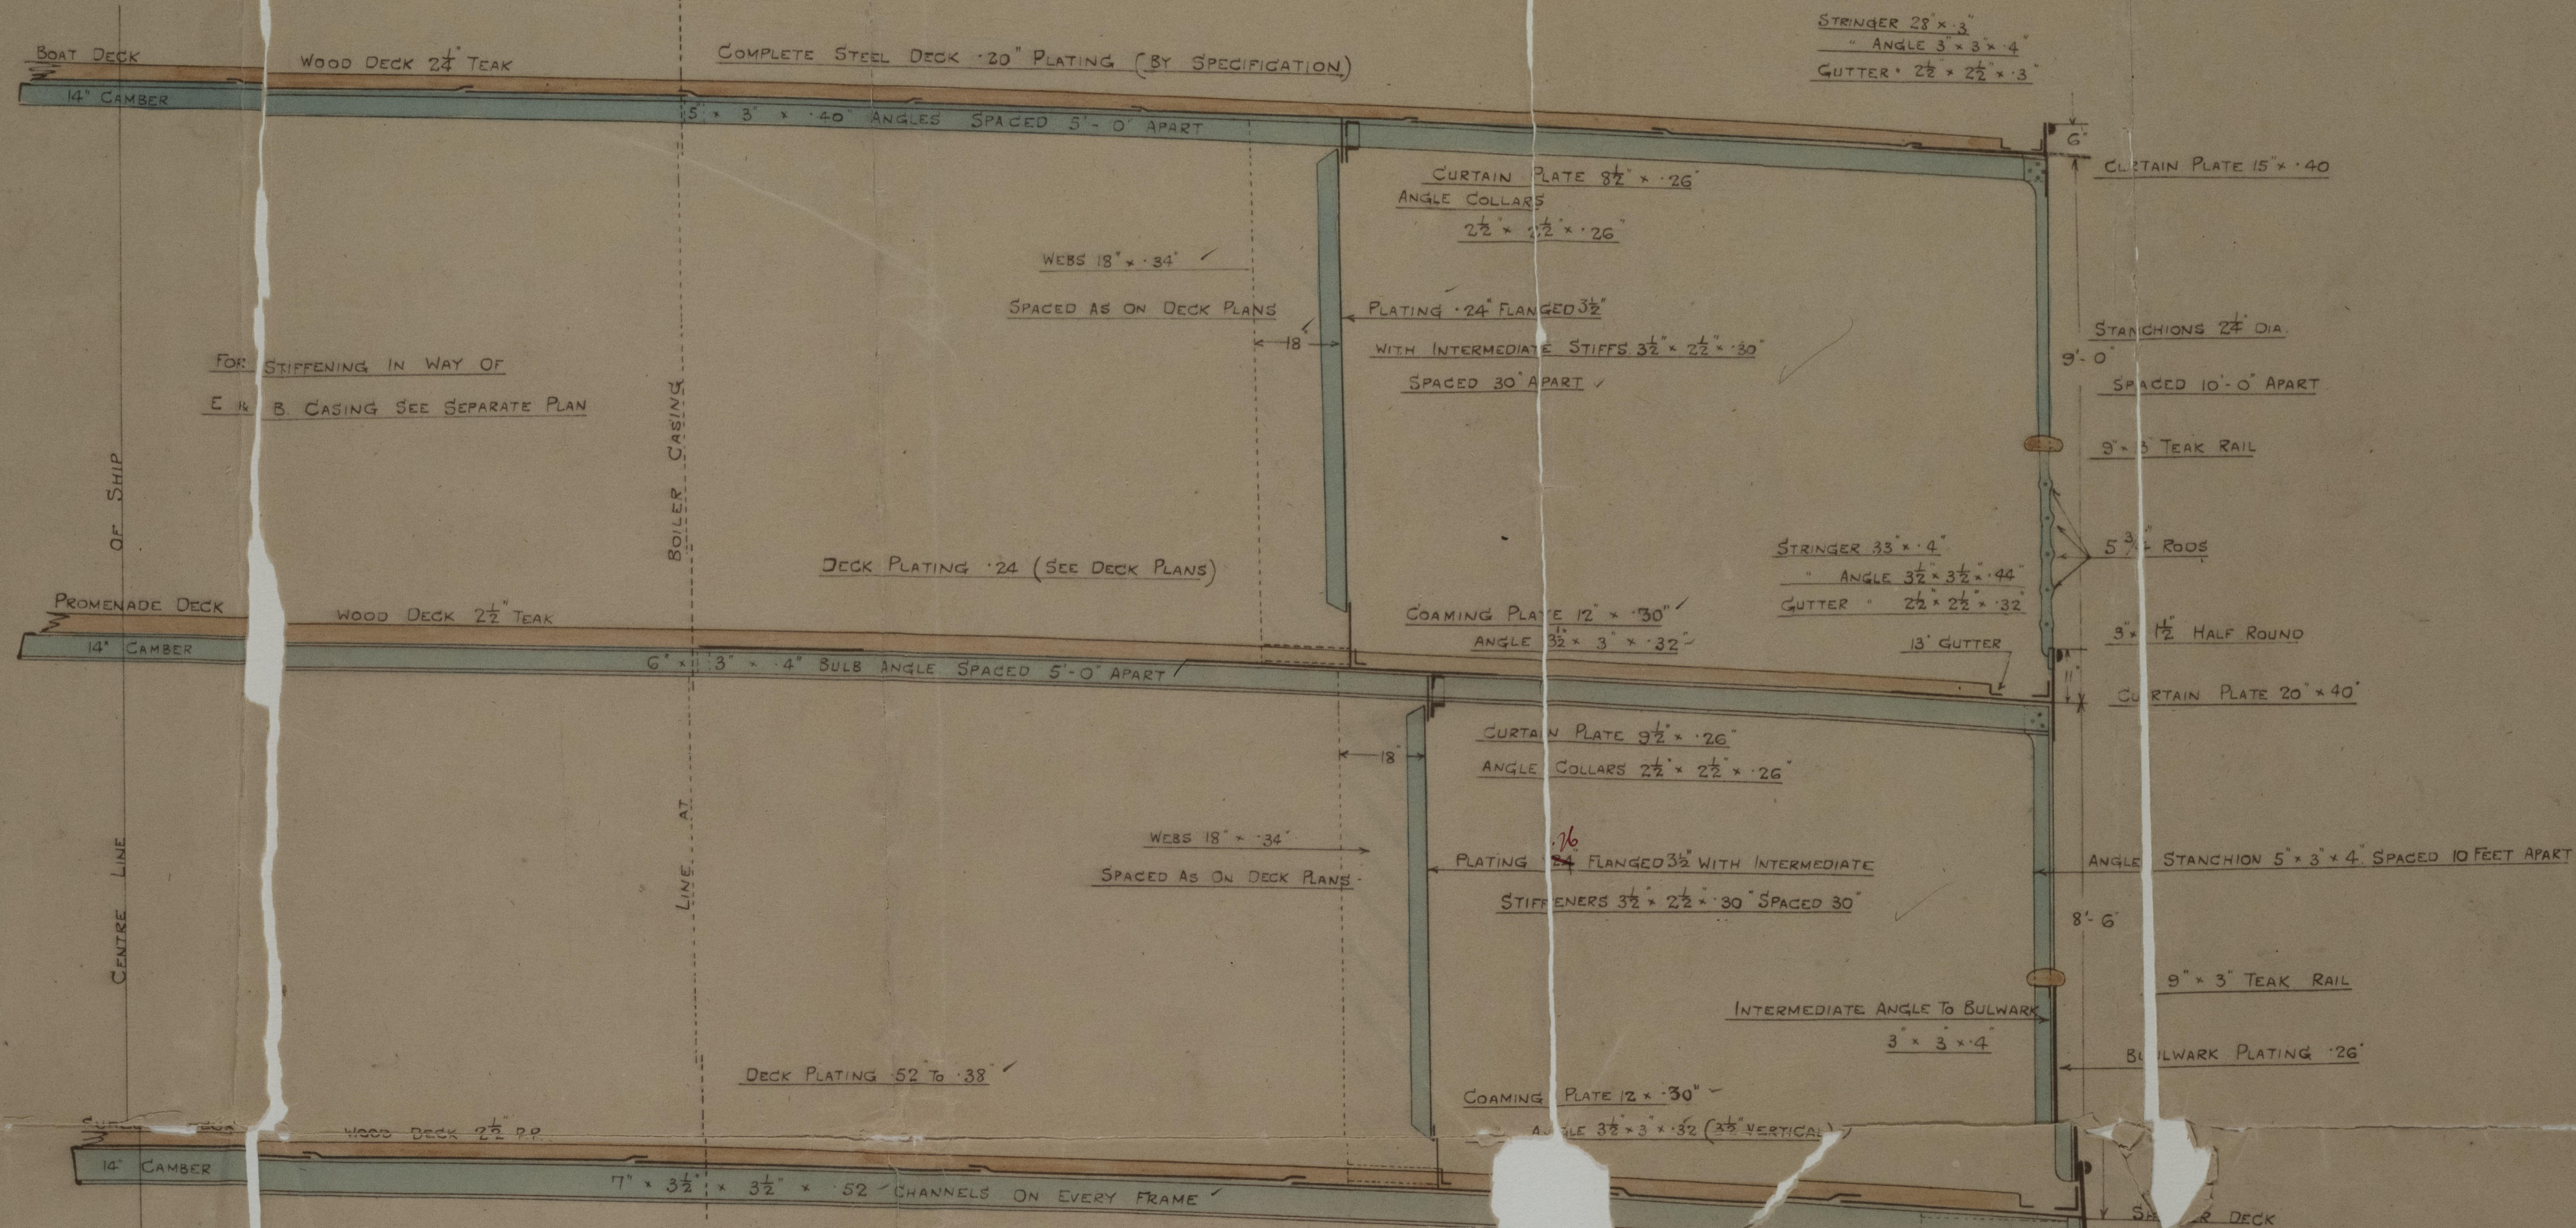

SECTION ABOUT 105 FRAME

SHEWING SUPERSTRUCTURE

SCALE 1/2" = 1 FOOT

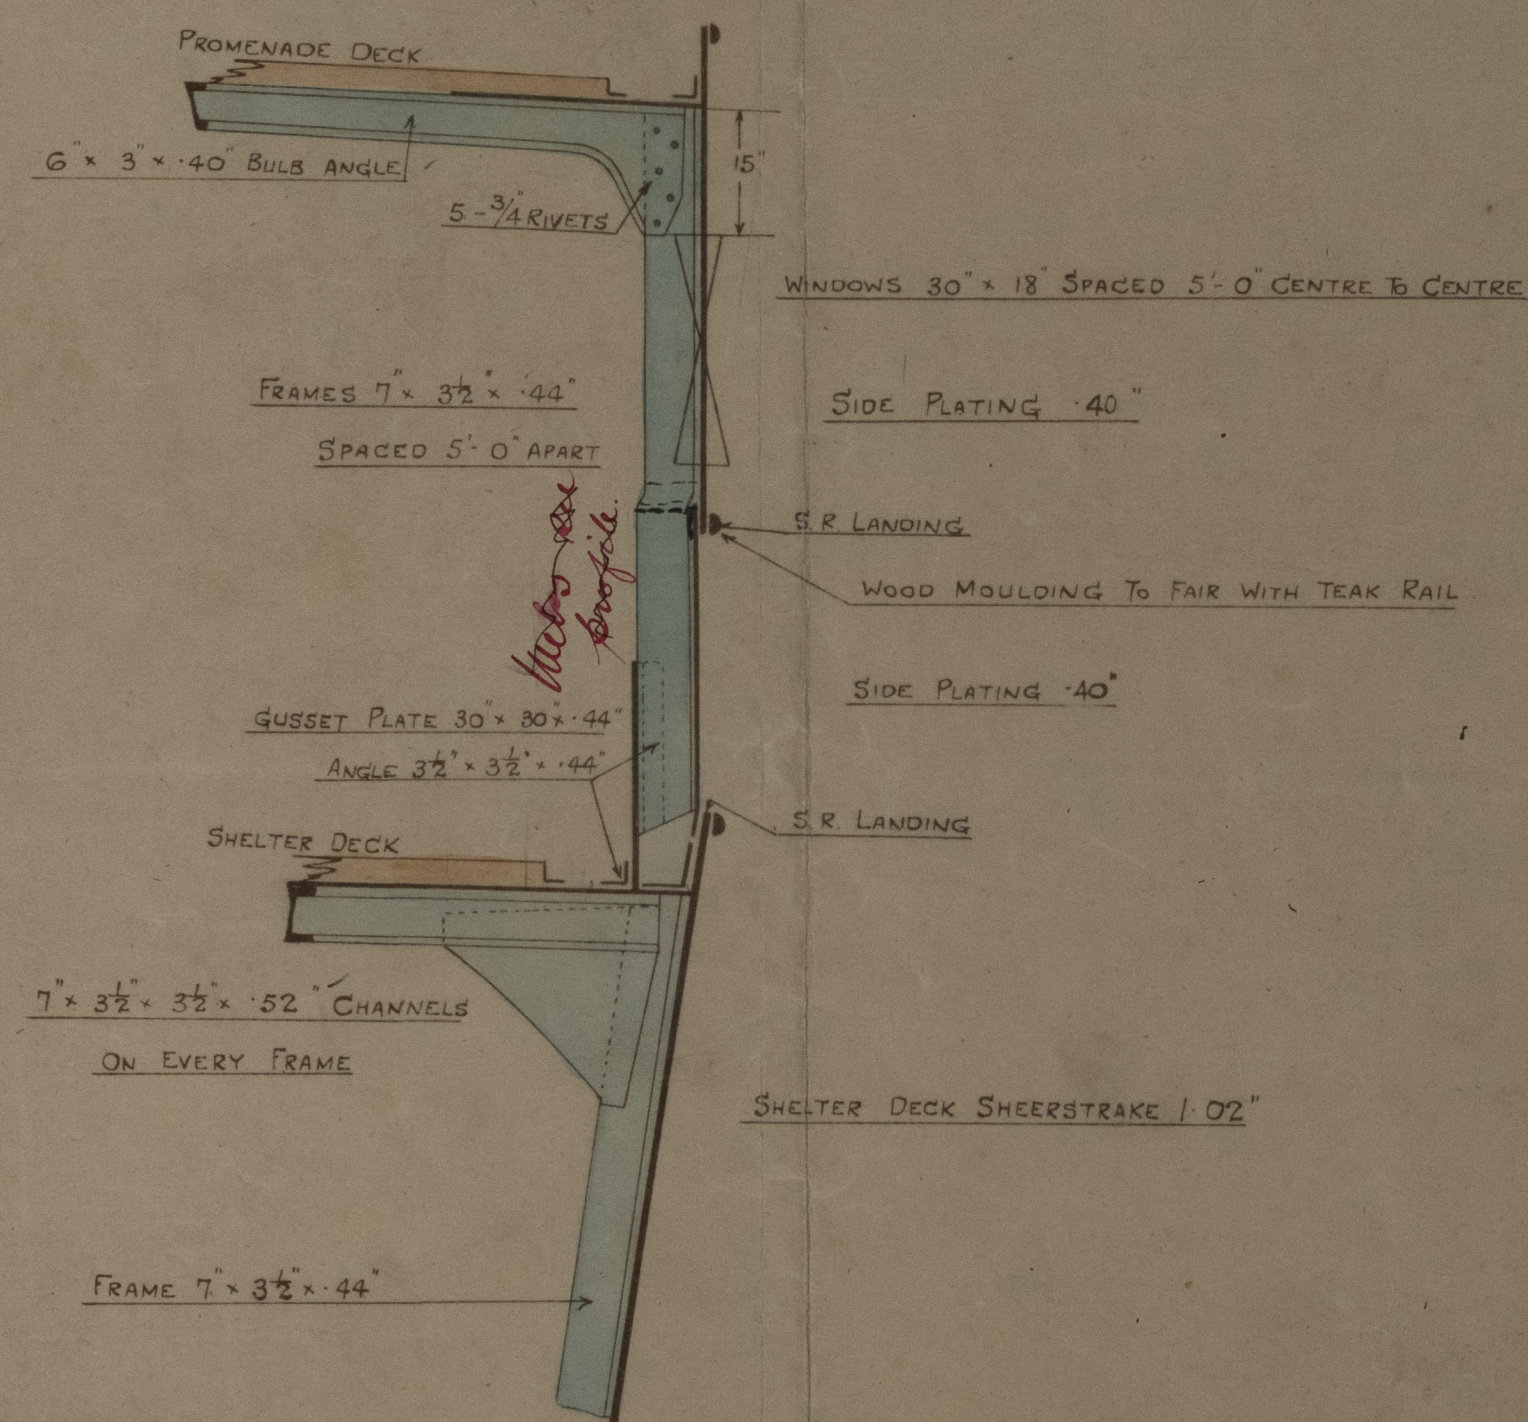

SECTION AT FRAME 158

SHEWING SIDE PLATING ABOVE SHELTER DECK

SCALE 1/2" = 1 FOOT