


HANGER SURFACE IN ONE BOILER.	
4 <del>COMB</del> ICES =	204 #
492 <del>TUBES</del>	2573 #
BACK <del>PLATE</del> PLATES =	60 #
COMB <del>INGS</del> SIDES & TOP =	199 #
BACKS =	96 #
TOTAL	3132 #

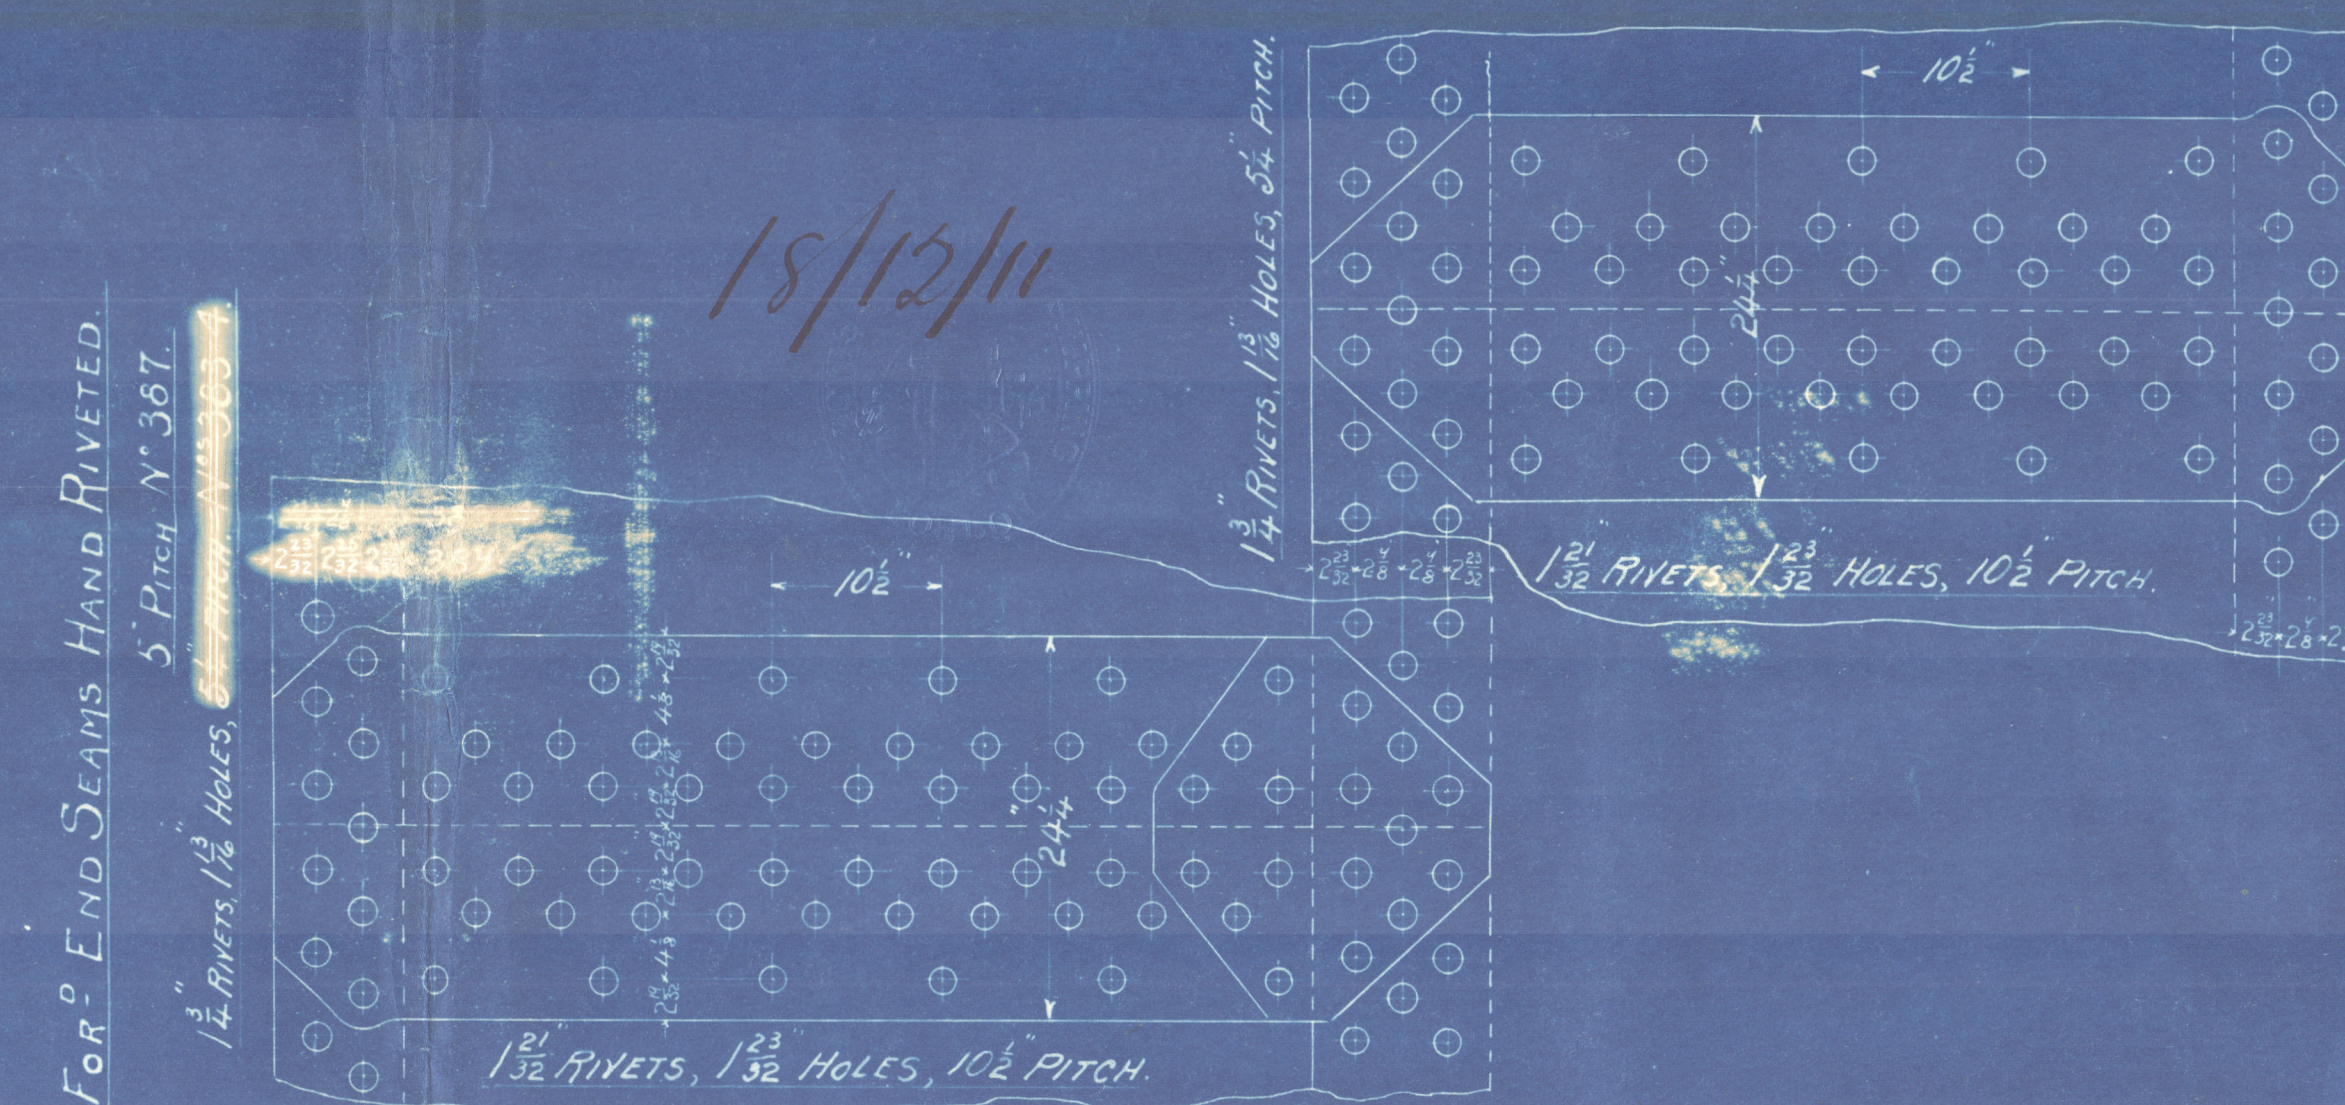

2-OFF (FOR EACH NO.)  
S. E. BOILER NO. 383 & 4. 387

SCALE:- 1 INCH TO THE FOOT

- ENGINE DEPT -  
 - CAIRD & CO LTD -  
 - GREENOCK -



Mult. Spec S.E. Rovers  
No 384.


by

Cand. 1604 Linn.

for their 1822 vessel

T.S.S. Benalla


215th working pressure

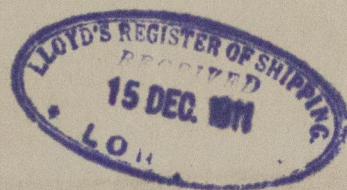

Greenock Report No 16402.  
— 4 —

RETAIN

RETAIN

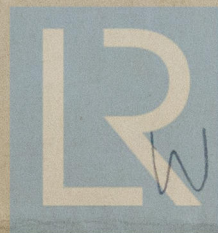

© 2020

Lloyd's Register  
Foundation