



15.4.07.
24.6.07
16.8.07

303 "ATBION"
305 "BEATRICE"
301 "CATTIOPBE"
300 "CLEOPATRA"
320 "CELENA"
No. 328 "ZAXON"

- N^o 358 TO 363 -
- ELEVATION -

— DIMENSION: 120'-0" B.P. x 21'-6" EXT. 12'-6" MOULDED. —

— SCALE $\frac{1}{4}'' = 1 \text{ FOOT.}$ —

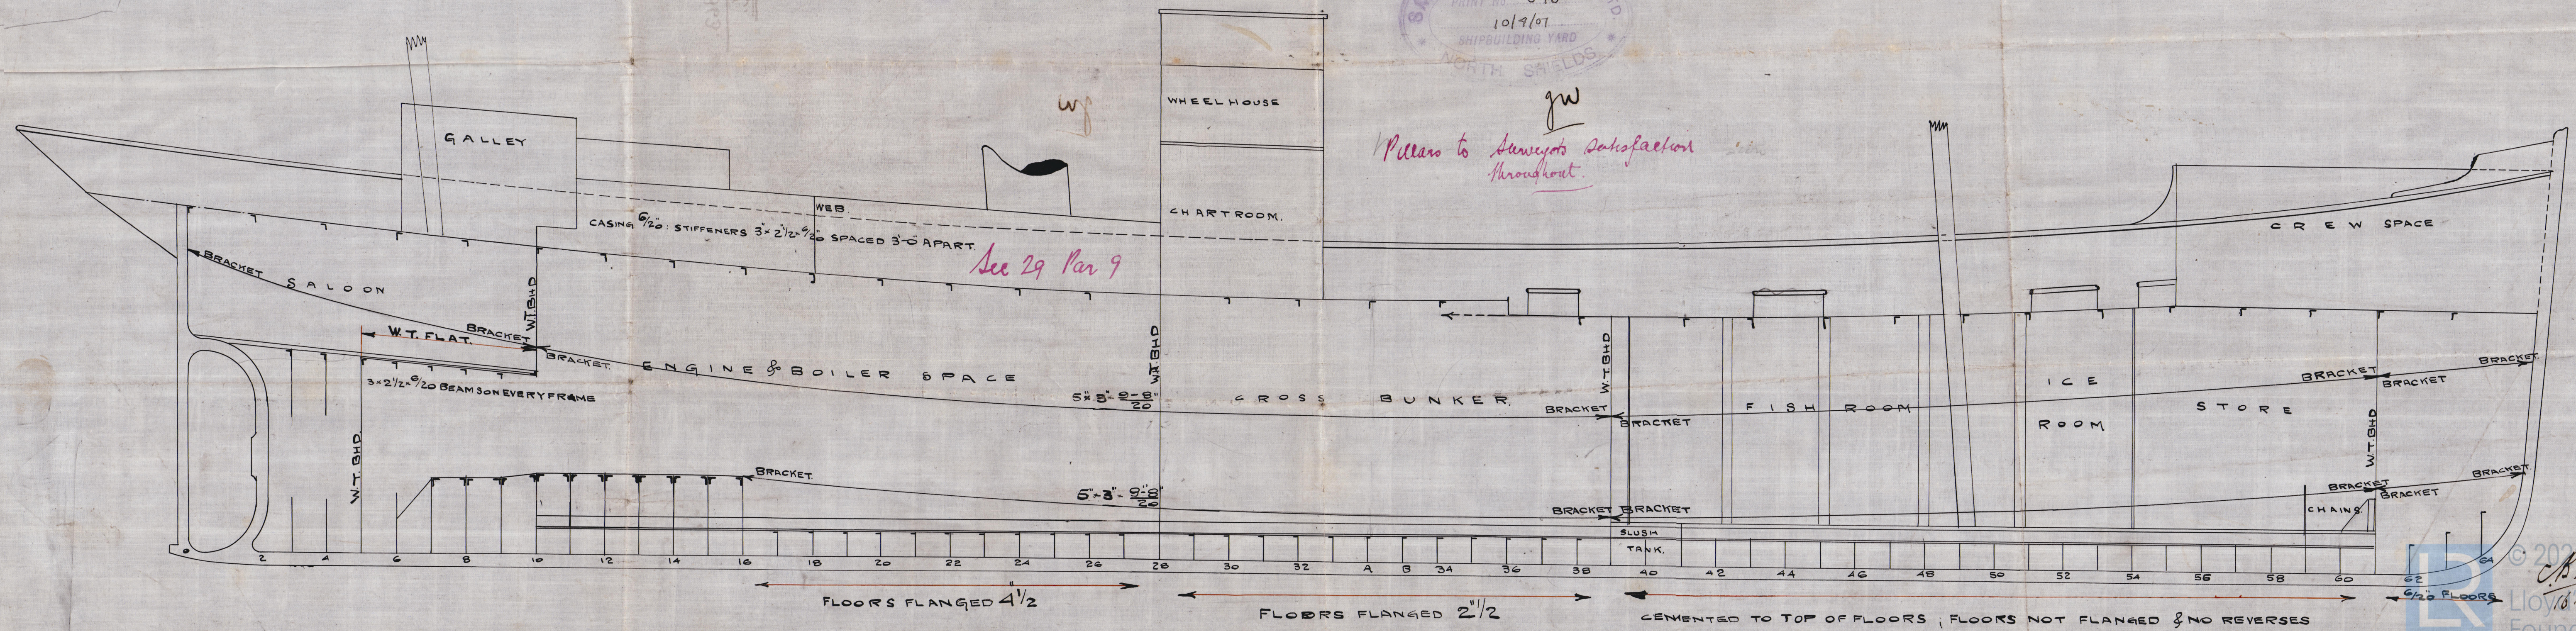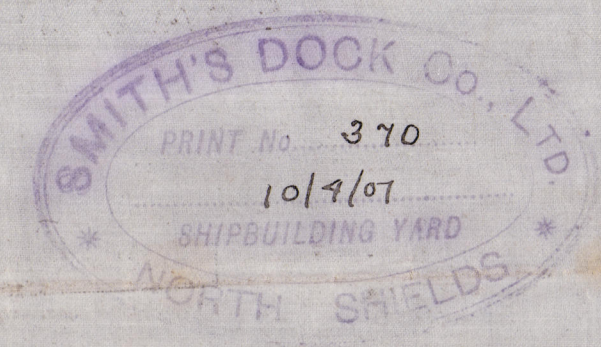

1 Pillars to Surveyor's Satisfaction
throughout.

Newcastle on Tyne
Plan of Wharfedale

Yard No 358 to 363.

Smiths Dock Co. Ltd.

No 358 "SAXON" 

359 "CELTIA"

360 "CLEOPATRA"

361 "CALLIOPE"

362 "BEATRICE"

363 "ALBION"

W. 66 B.

ALBION

53.961



© 2021

Lloyd's Register
Foundation