
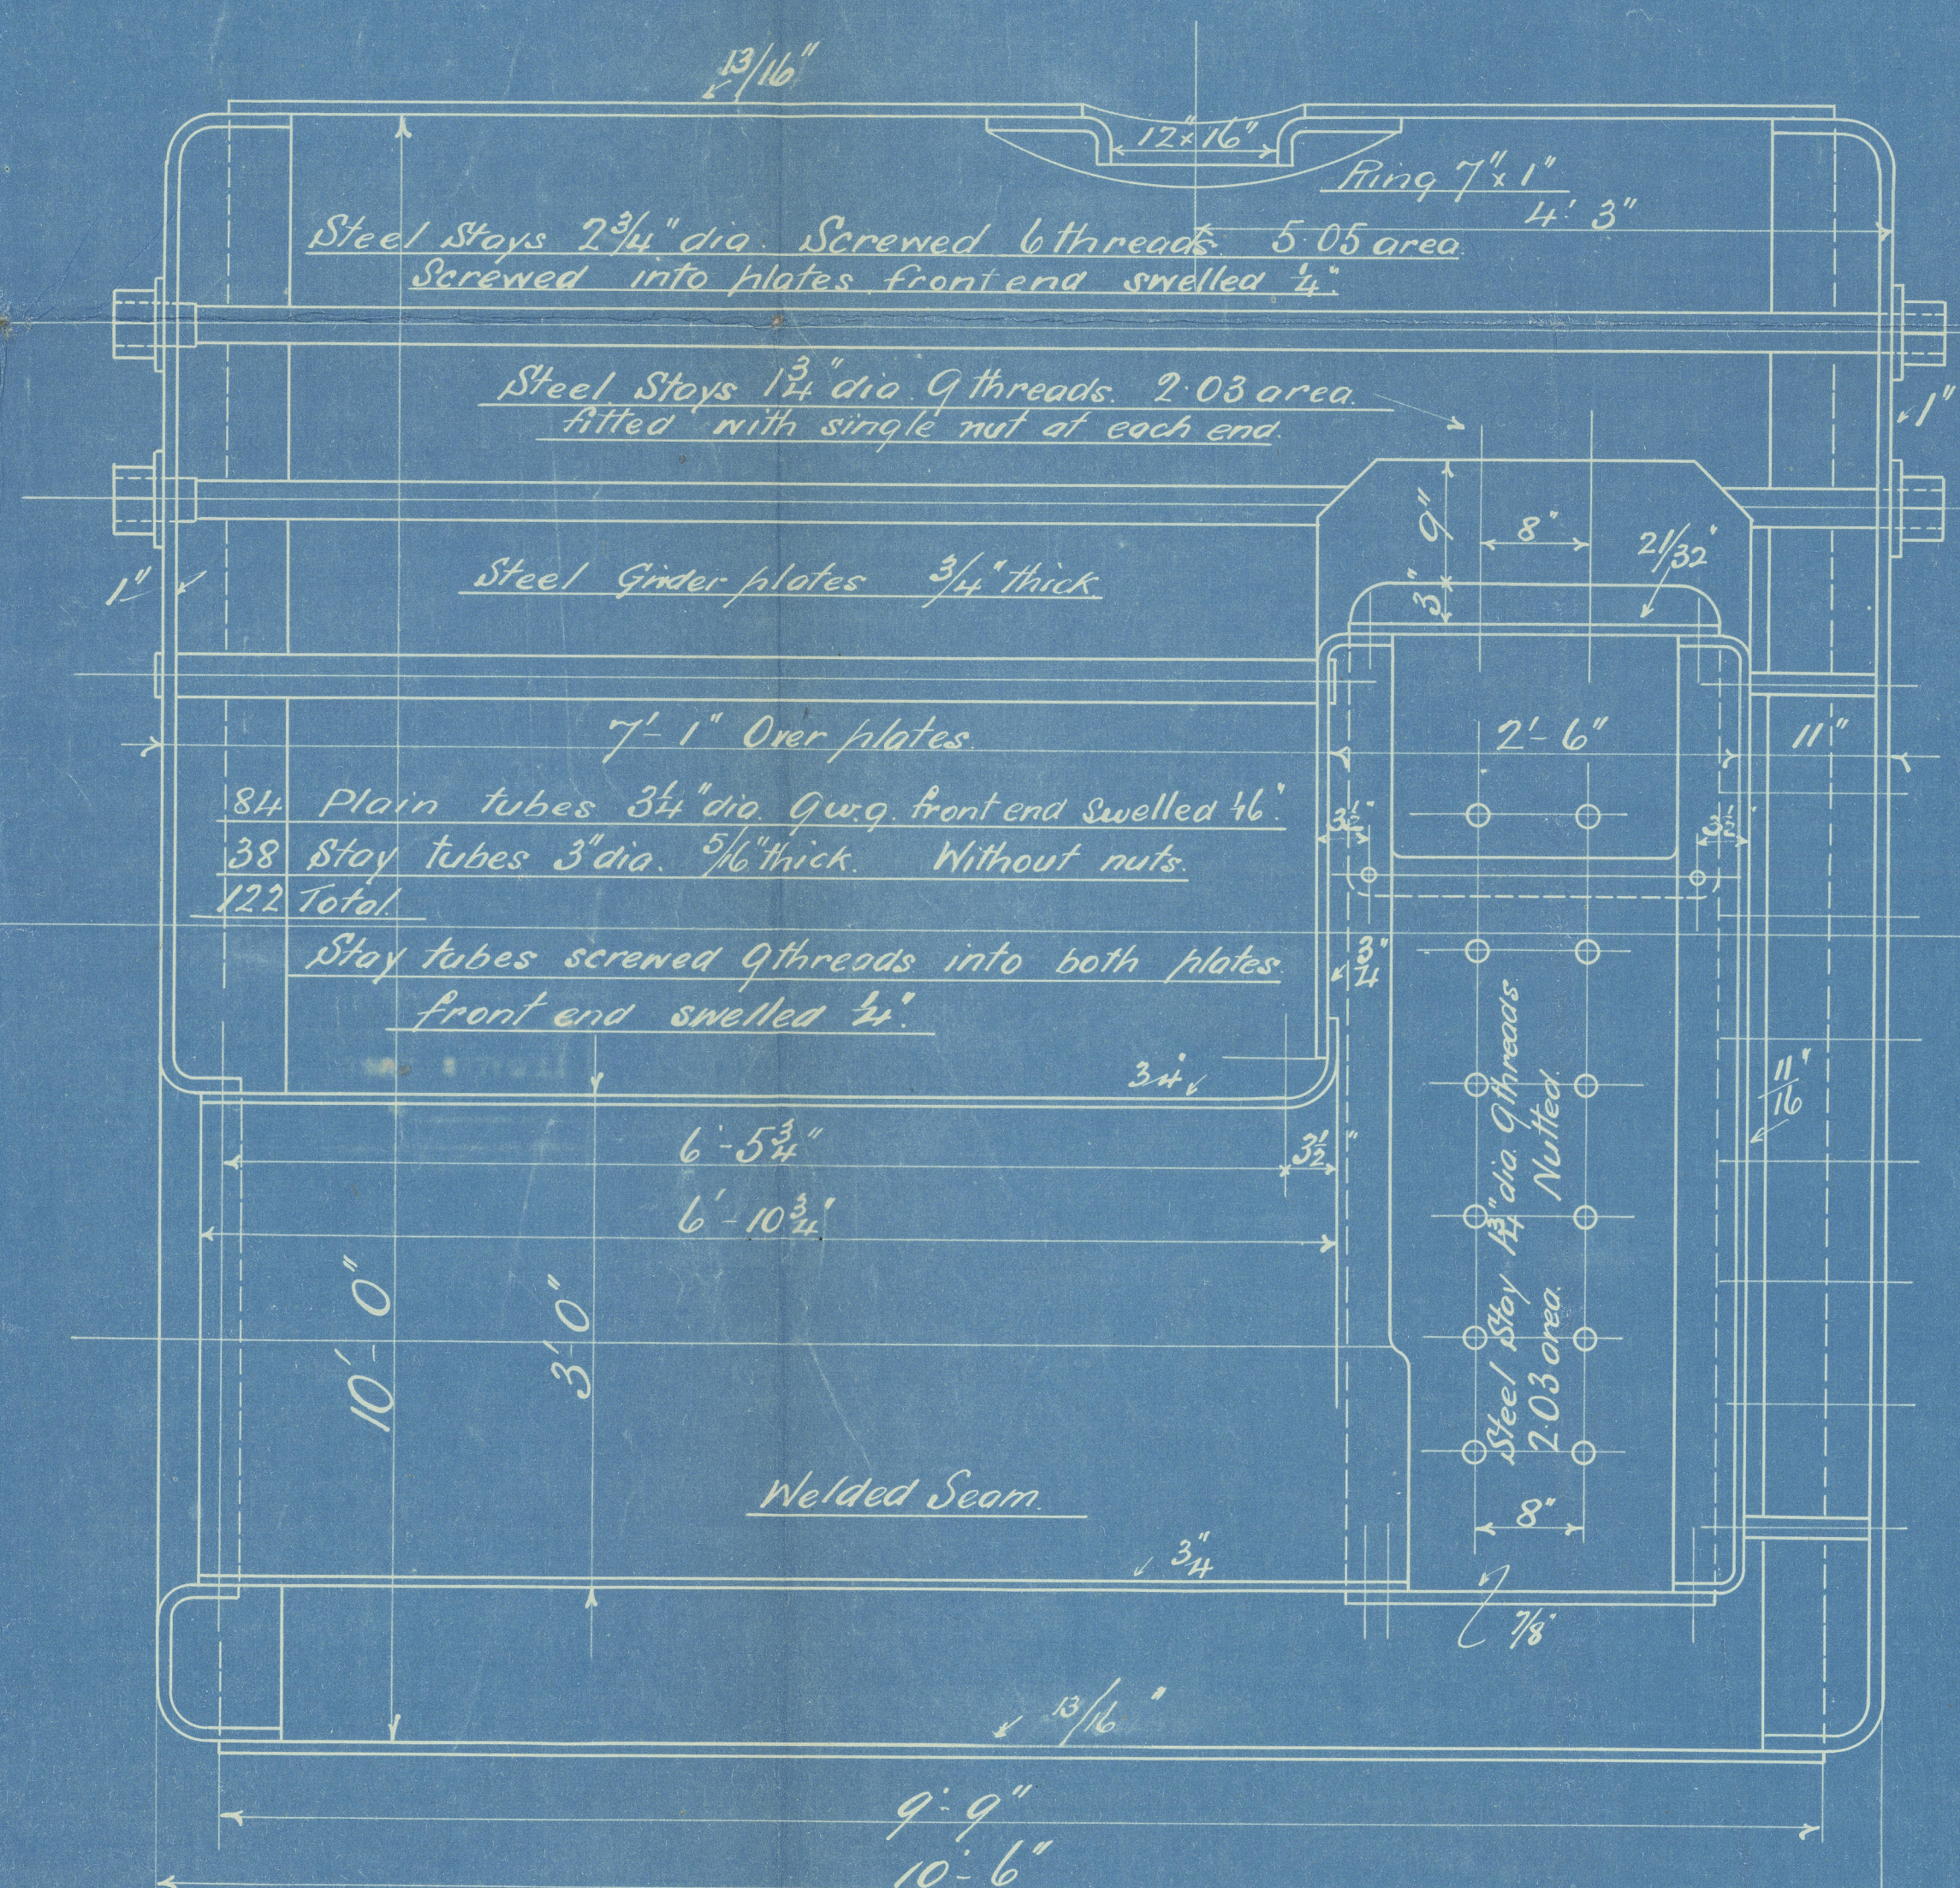


STEEL BOILER 10-0 DIA 10-6 LONG


LLOYDS 180 LBS W.P.

4816

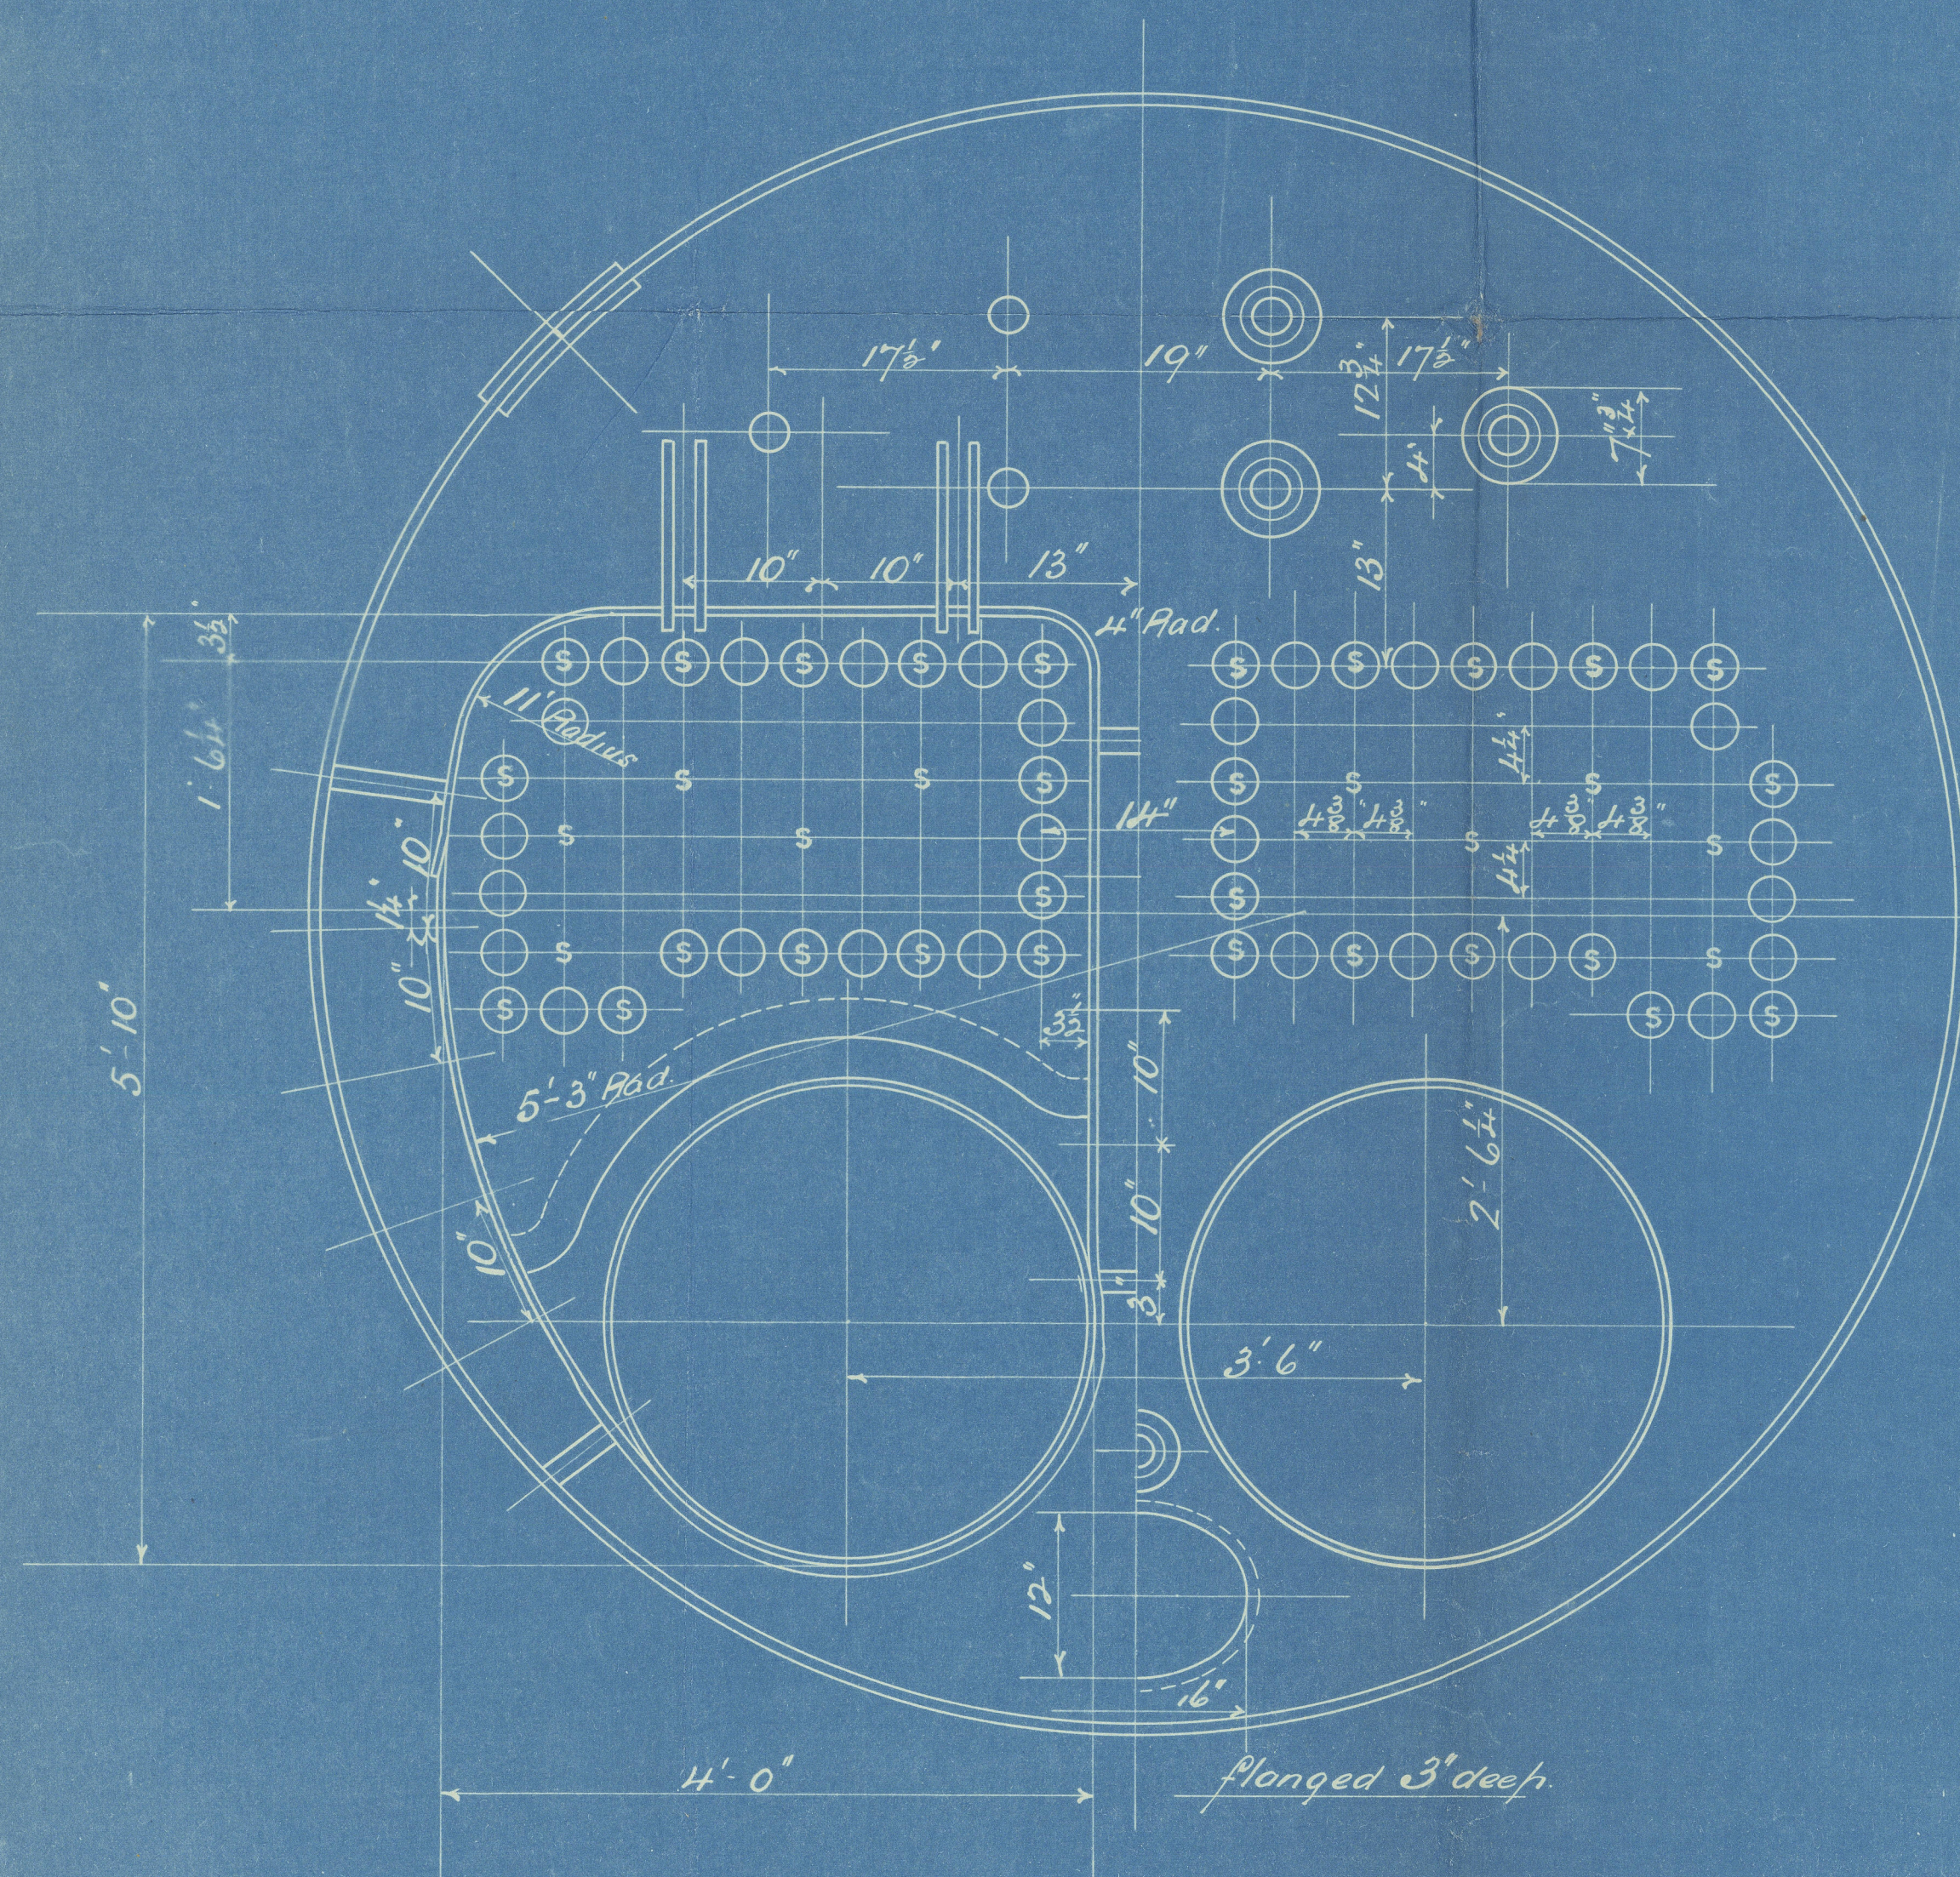


- Steel Stays 1 3/8" dia 9 threads 2.36 area
- 1 3/4" dia 9 threads 2.03 area
- Fitted with a single nut at each end

Heating Surface 920 sq ft
Grate area bars 5'-6" long 316 sq ft

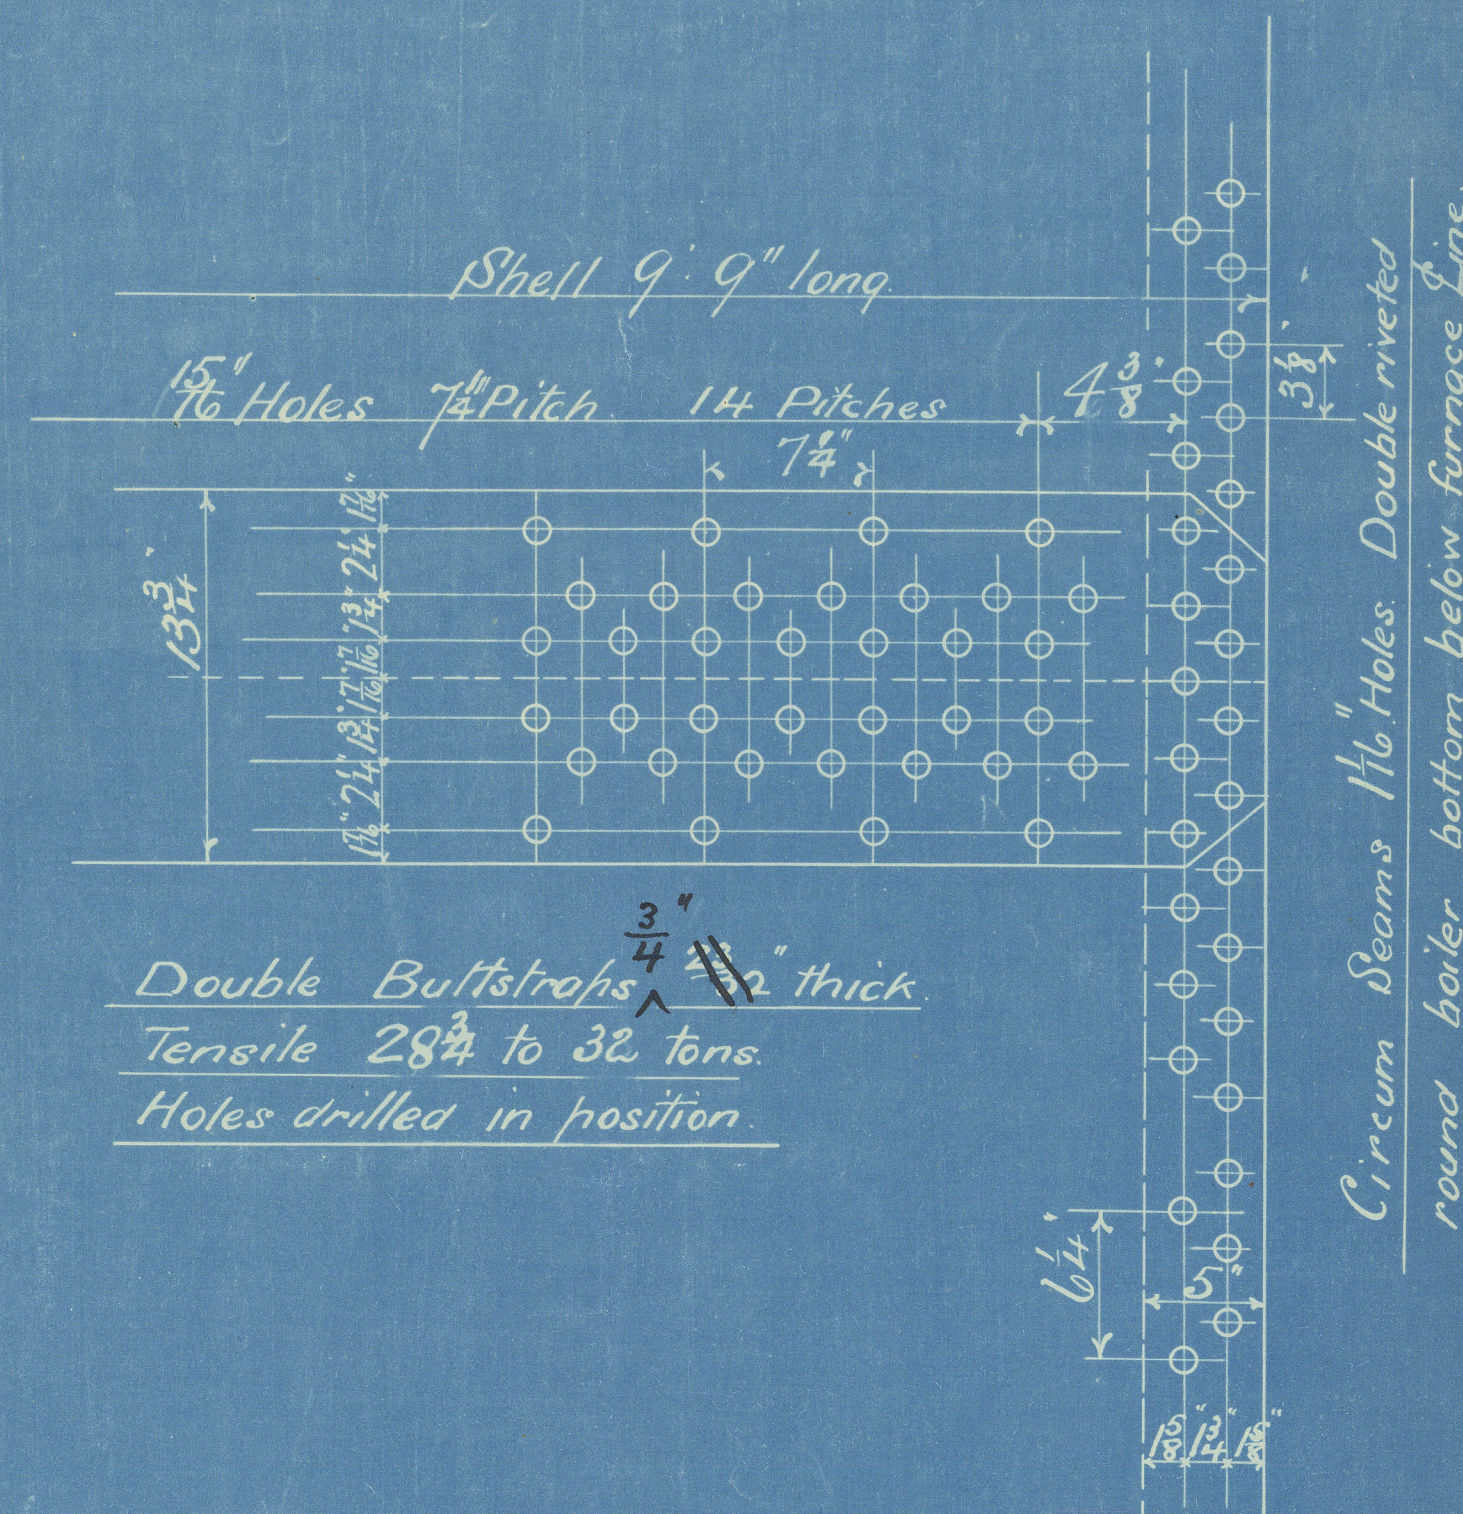

27/11/15

RILEY BROS (BOILERMAKERS) LTD.
STOCKTON ON TEES.

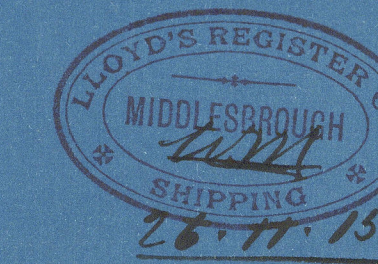

27/11/15

Donkey Boiler

Messrs Riley Bros Lim^d


Donkey Boiler No 4816
for

Messrs Short Bros


S.S. No. 391

Working Press 180 lb

R.F.A. "Oldbury"

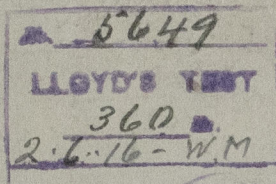

RPT. No 9369.

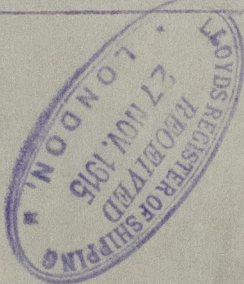

9. Birchleaf

SUNDERLAND RPT. No. 26886

W613-0049



© 2020

Lloyd's Register
Foundation