


— LENGTH B.P. 347'-0". BEAM M<sup>LD</sup> 47'-3". D.M. 27'-10½". —

— SCALE  $\frac{1}{8}$ " = 1 FOOT. —



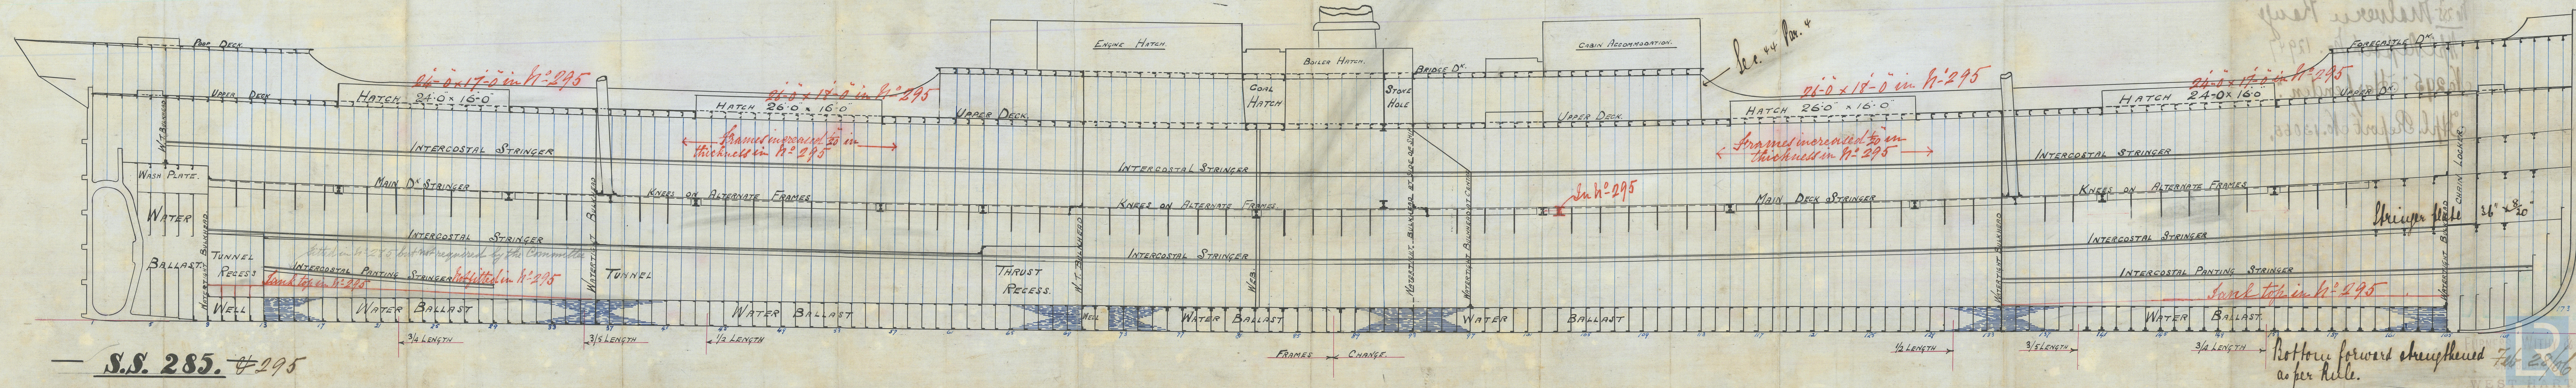

W613-0113

Amended Profile  
Turners, withy 160 hd.  
No.s 285 & 295

No. 285 "Malvern Range"

Hpl. Report No. 12947


No. 295 "Harpenden"

Hpl. Report No. 13065.

"285" "295"

shalt quirell

© 2020

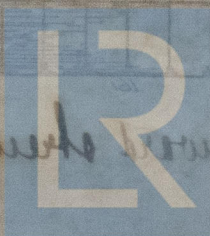

Lloyd's Register  
Foundation