


PROFILE  
S. S. № 409

SCALE  $\frac{1}{8} = \text{ONE FT.}$

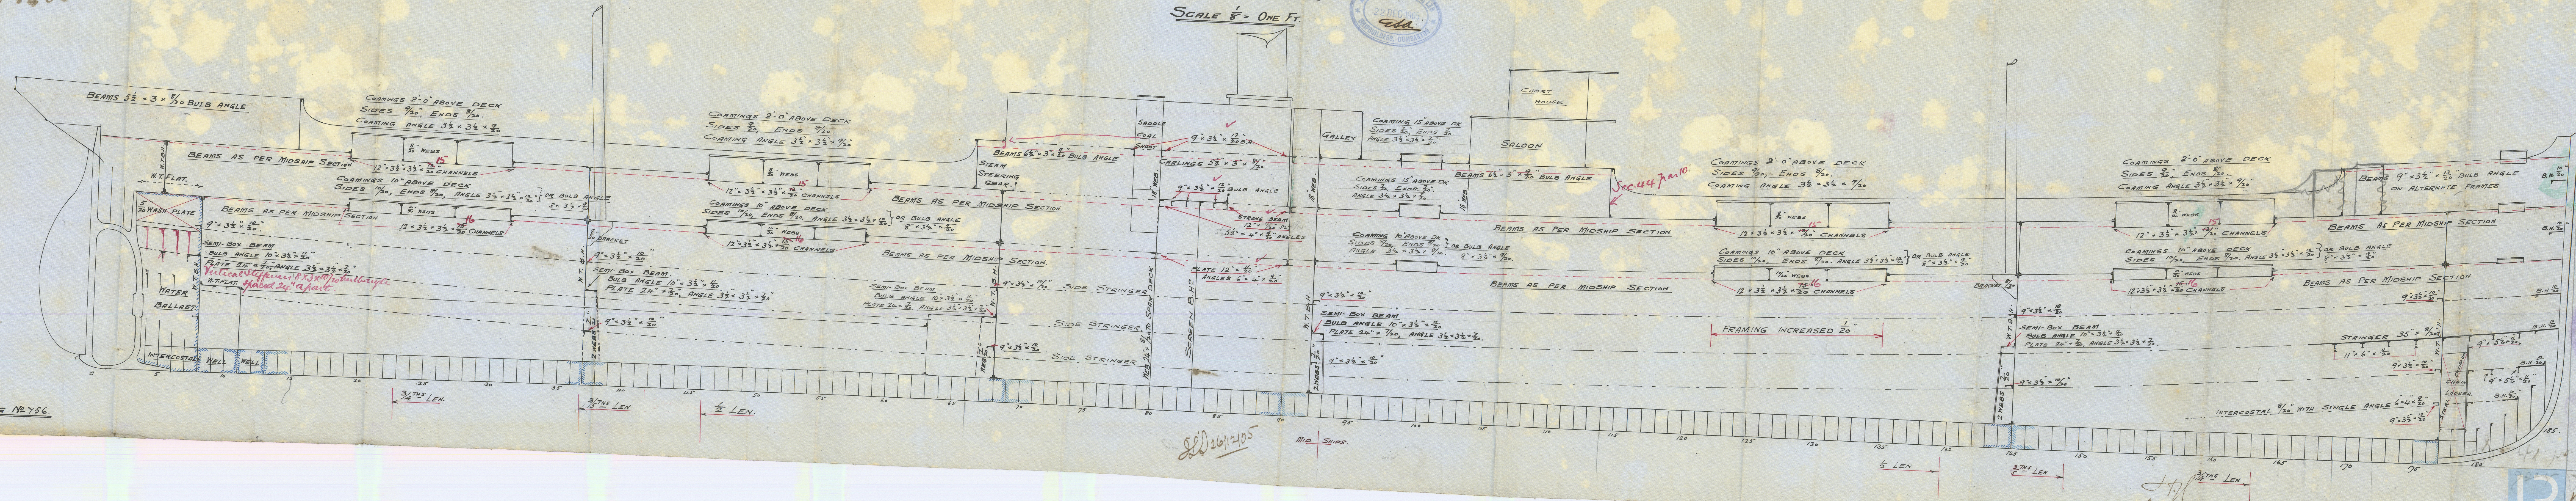

DRAWING No 456.

26/12/05

$\frac{3}{1A}$  THS LEN

W613-0159



Profile  
N<sup>o</sup>. 409

Sond Defton

Gls. rht. no. 24919-



RETAINED



© 2020

Lloyd's Register  
Foundation

W 613-0159