


29:5:06

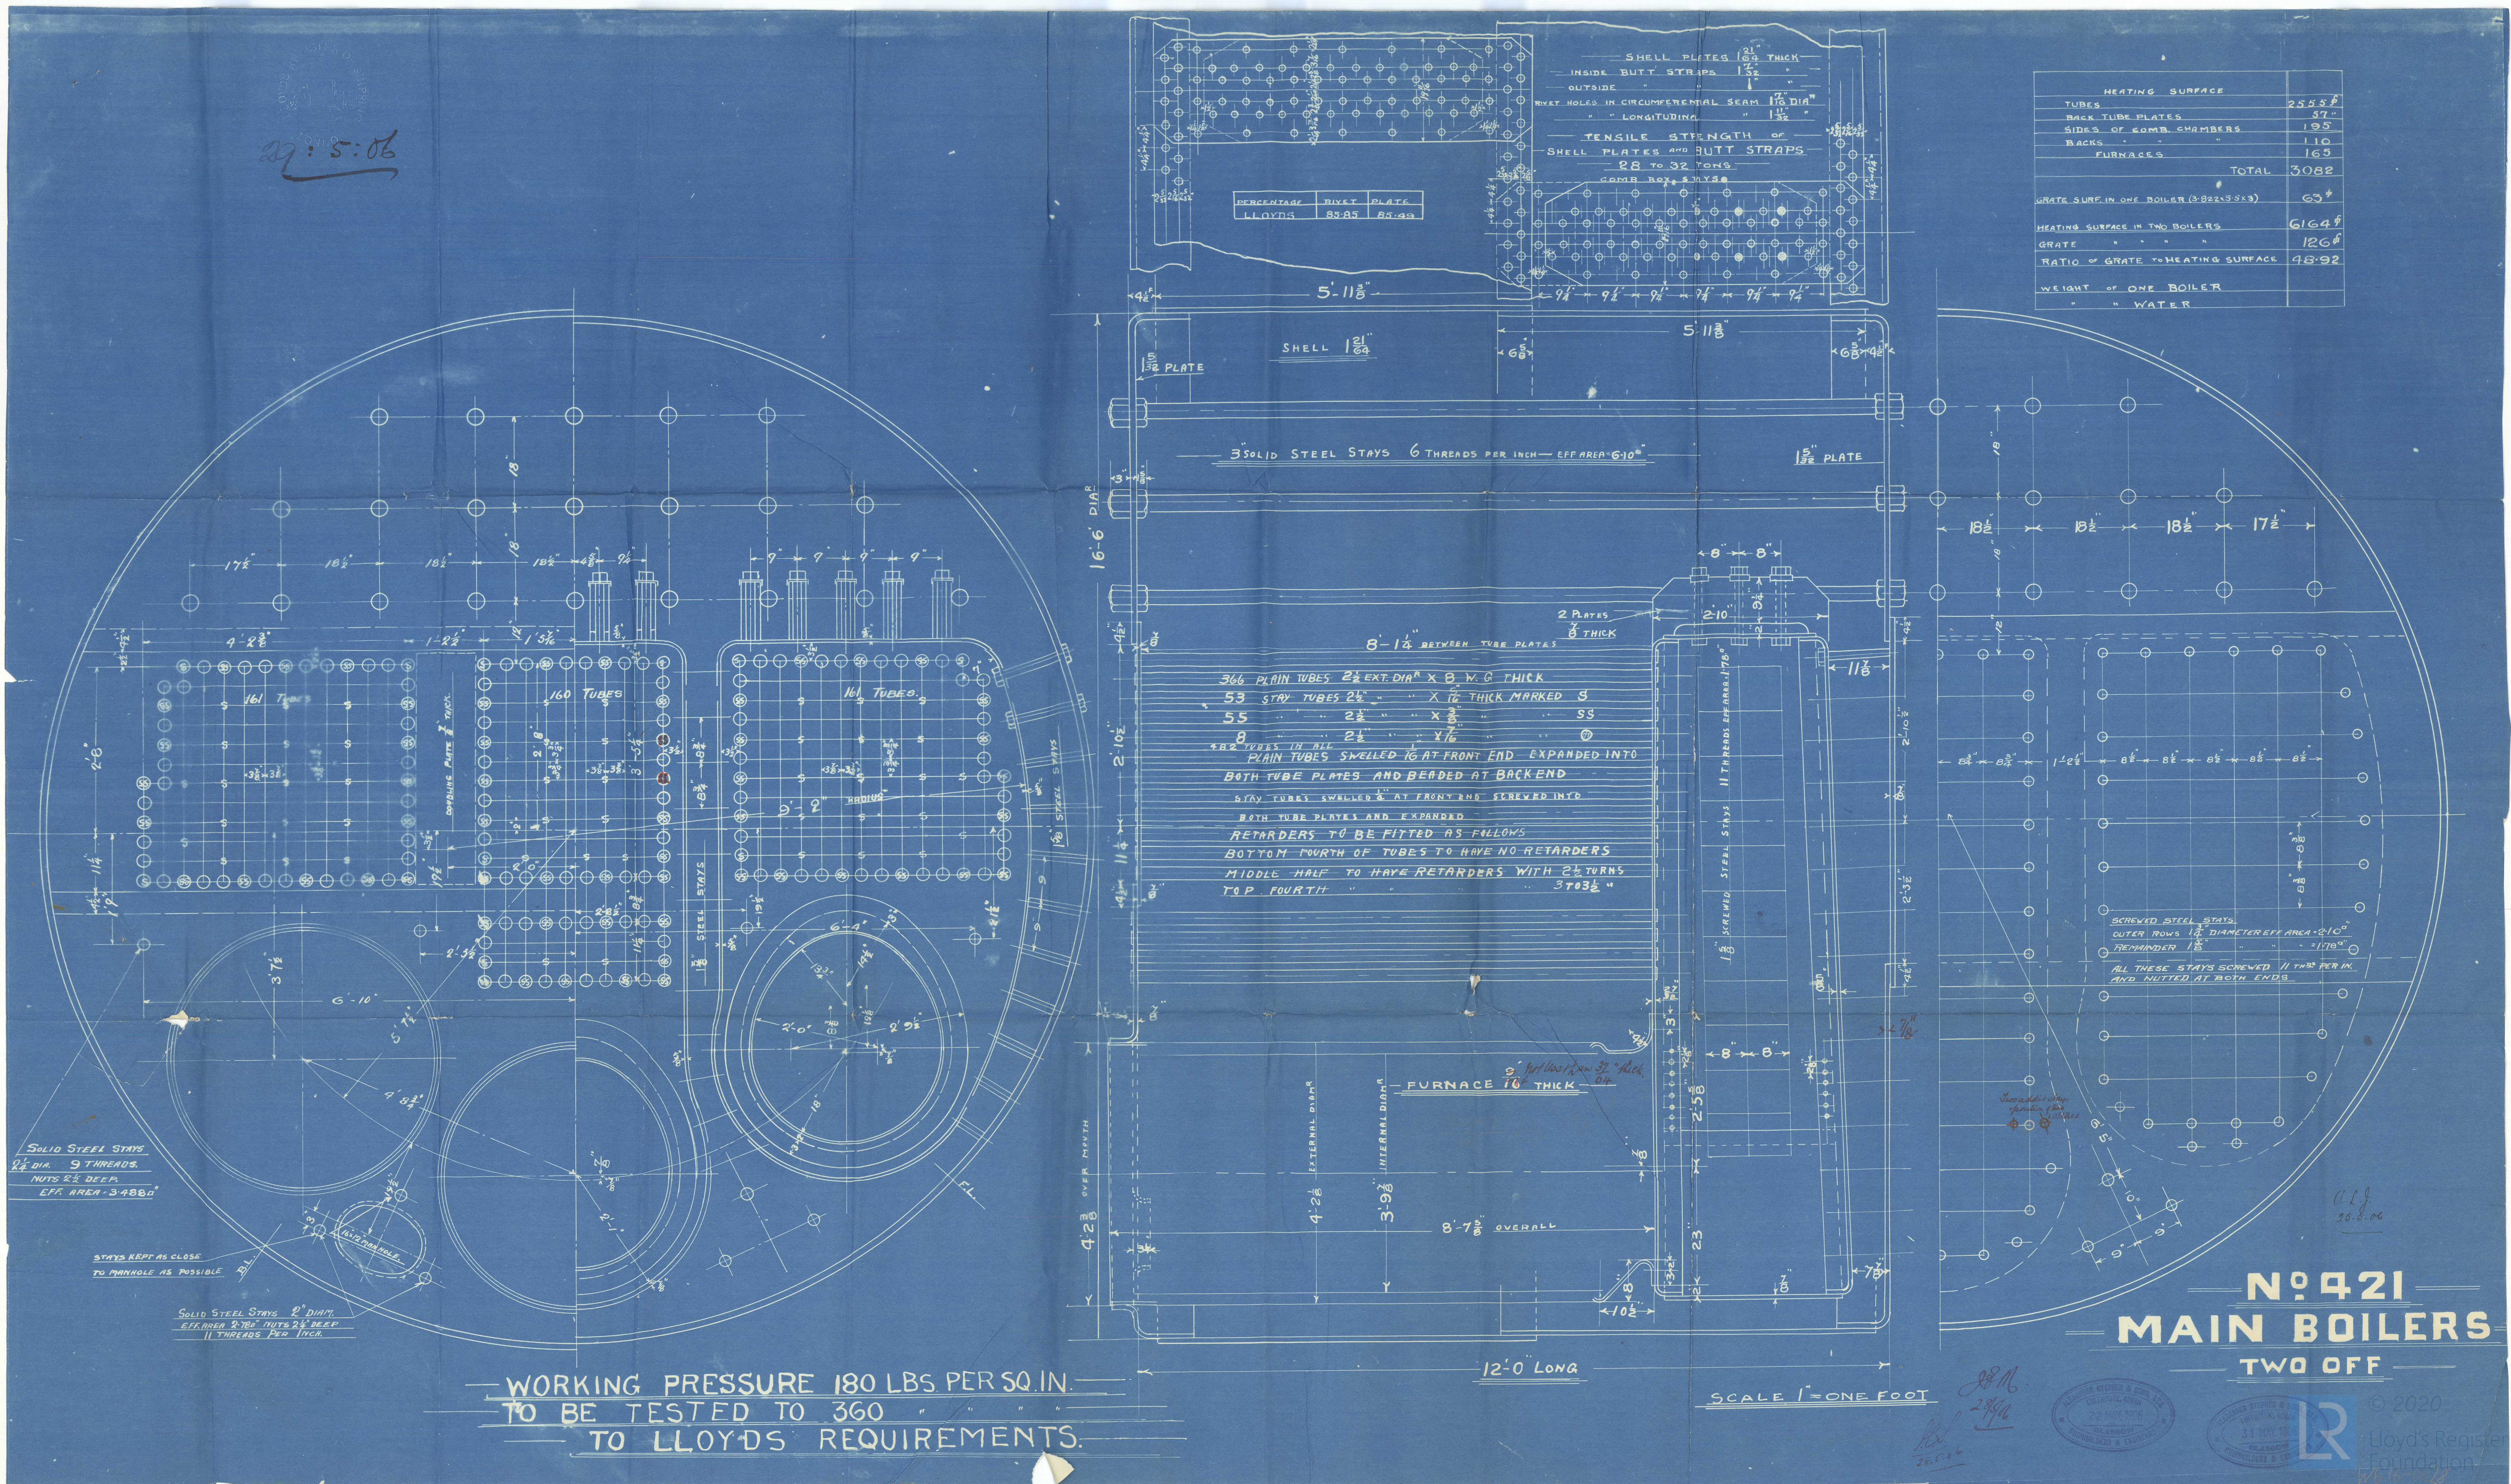

Nº 421
MAIN BOILERS
TWO OFF

WORKING PRESSURE 180 LBS. PER SQ. IN.
TO BE TESTED TO 360 " " " "
TO LLOYD'S REQUIREMENTS.

SCALE 1" = ONE FOOT


RETAIN

RETAIN

Alex. Stephen Dours

No 421

Main Boiler

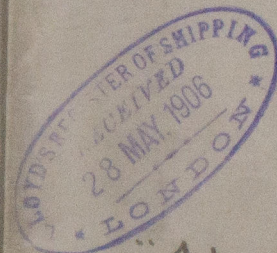

"Kayembe"
Gls. n^o. 25226



RETAIN

© 2020



Lloyd's Register
Foundation

W615-0228