

132214



Nº 2006 BOILERS (FOR MESSRS H & C GRAYSON LTD)

TWO BOILERS THUS

554 IRON TUBES 3/4" EXT DIA 8'-0" LONG x 1/2" W.G. (INCLUDING 166 STAY TUBES)

HEATING SURFACE OF TUBES 3650 SQ FEET

" " " FURNACES 850 " "

TOTAL 4500 " " (TWO BOILERS)


TOTAL AREA OF FIRE-GRATE (6'-0" BARS) 130 SQ FEET

WORKING PRESSURE 180 LBS PER SQ INCH

TEST " 360 " "

TO PASS LLOYDS SURVEY & REQUIREMENTS

ADDITIONAL TO THE SPECIFICATION
 WITH LLOYD'S SURVEY 2, 9th/18

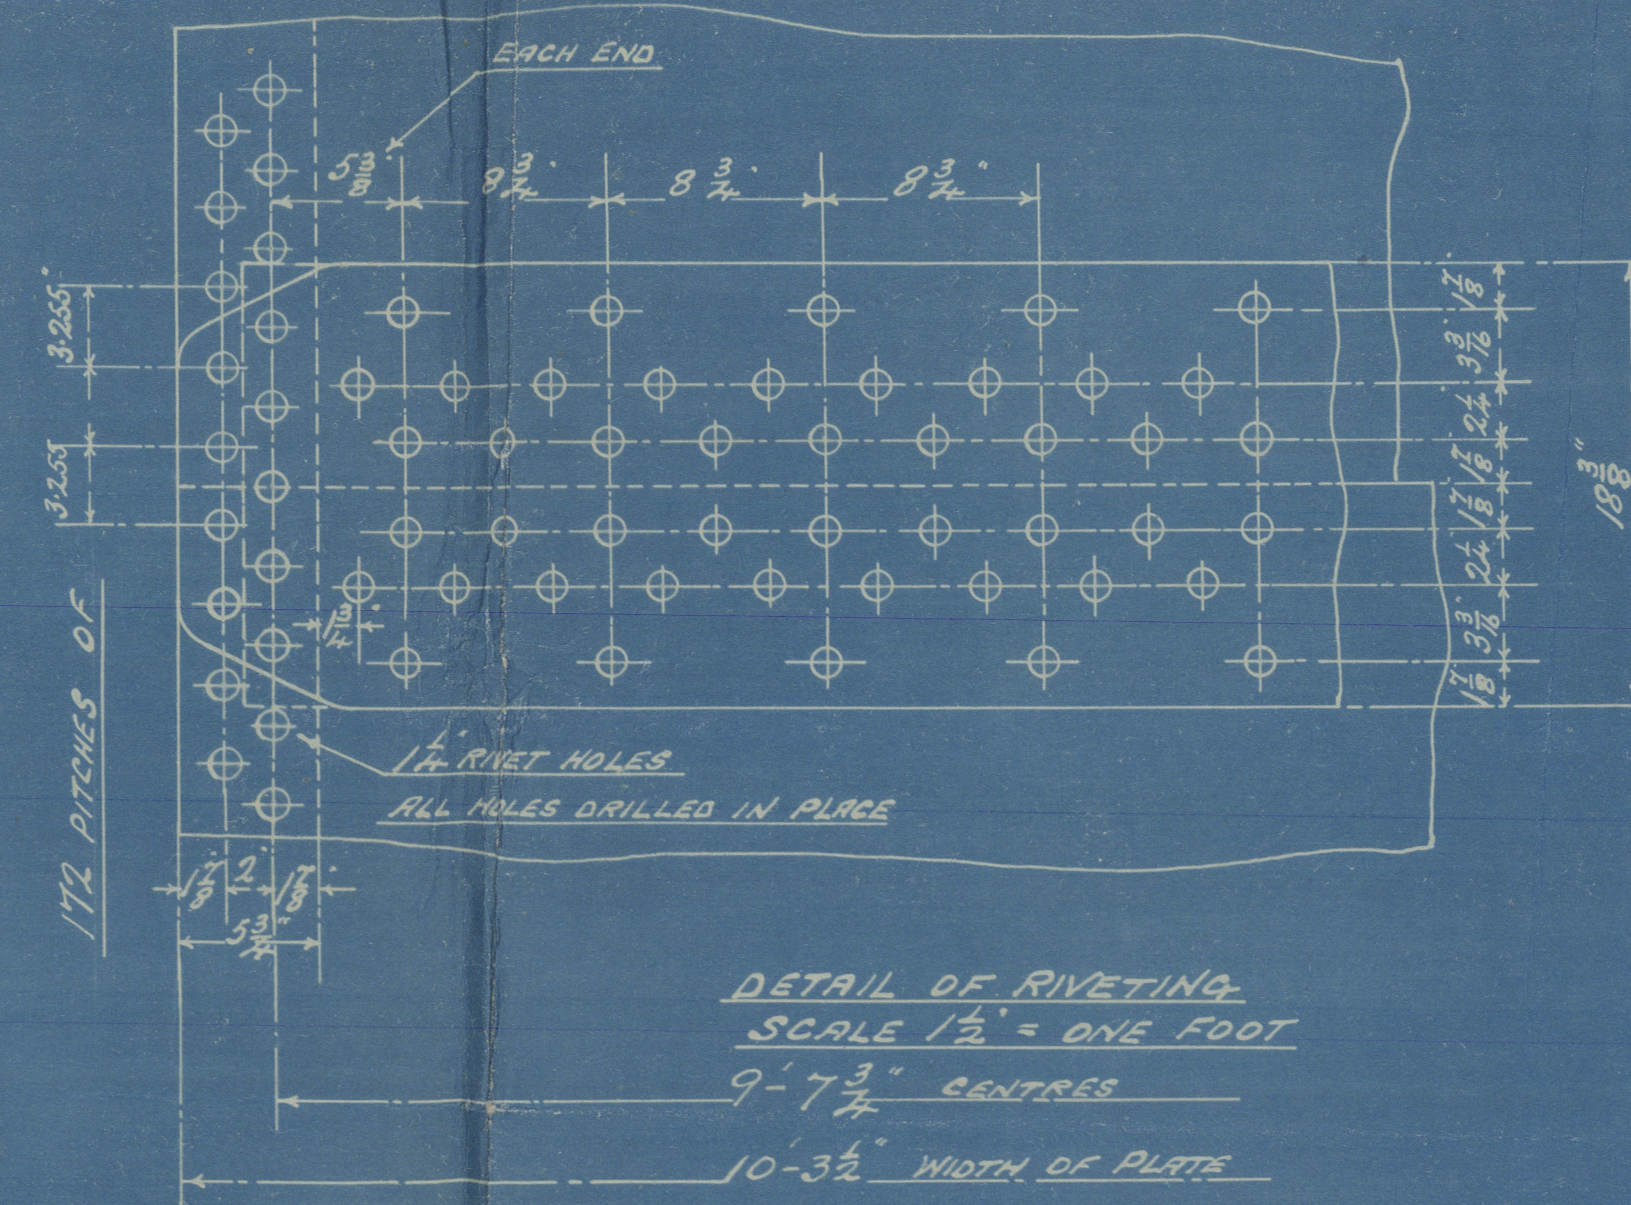

DIAMETER OF BOILER INSIDE 14'-9"

THICKNESS OF SHELL 1 1/8"

DIAMETER OF RIVET HOLES 1 1/8"

THICKNESS OF BUTT-STRAPS - INSIDE 1 3/8" OUTSIDE 1 1/2"

STRENGTH OF LONGIT. SEAMS




PLATE - TO LLOYDS REQUIREMENTS 85.71 %

RIVET - " 87.8 %

MINIMUM TENSILE STRENGTH OF SHELL AND BUTT-STRAPS 28 TONS

POSITION OF STAY	MARK	DIA 5"	EDGE DIST	THICK PER INCH
ACROSS TOP & SIDES	○	1 3/4"	2'-03" 12"	9
WIDE WATER SPACE	⊙	1 1/2"	2'-36" 13"	"
TOP CHAIN W.S.	⊙	2"	2'-71" 12"	"

ALL FIREBOX STAYS SCREWED THRU BOTH PLATES & NUTS FITTED AT EACH END, EXCEPT STAYS FROM WING CORRUG. BOX TO SHELL WHICH PROJECT 1/2" AND ARE DRILLED

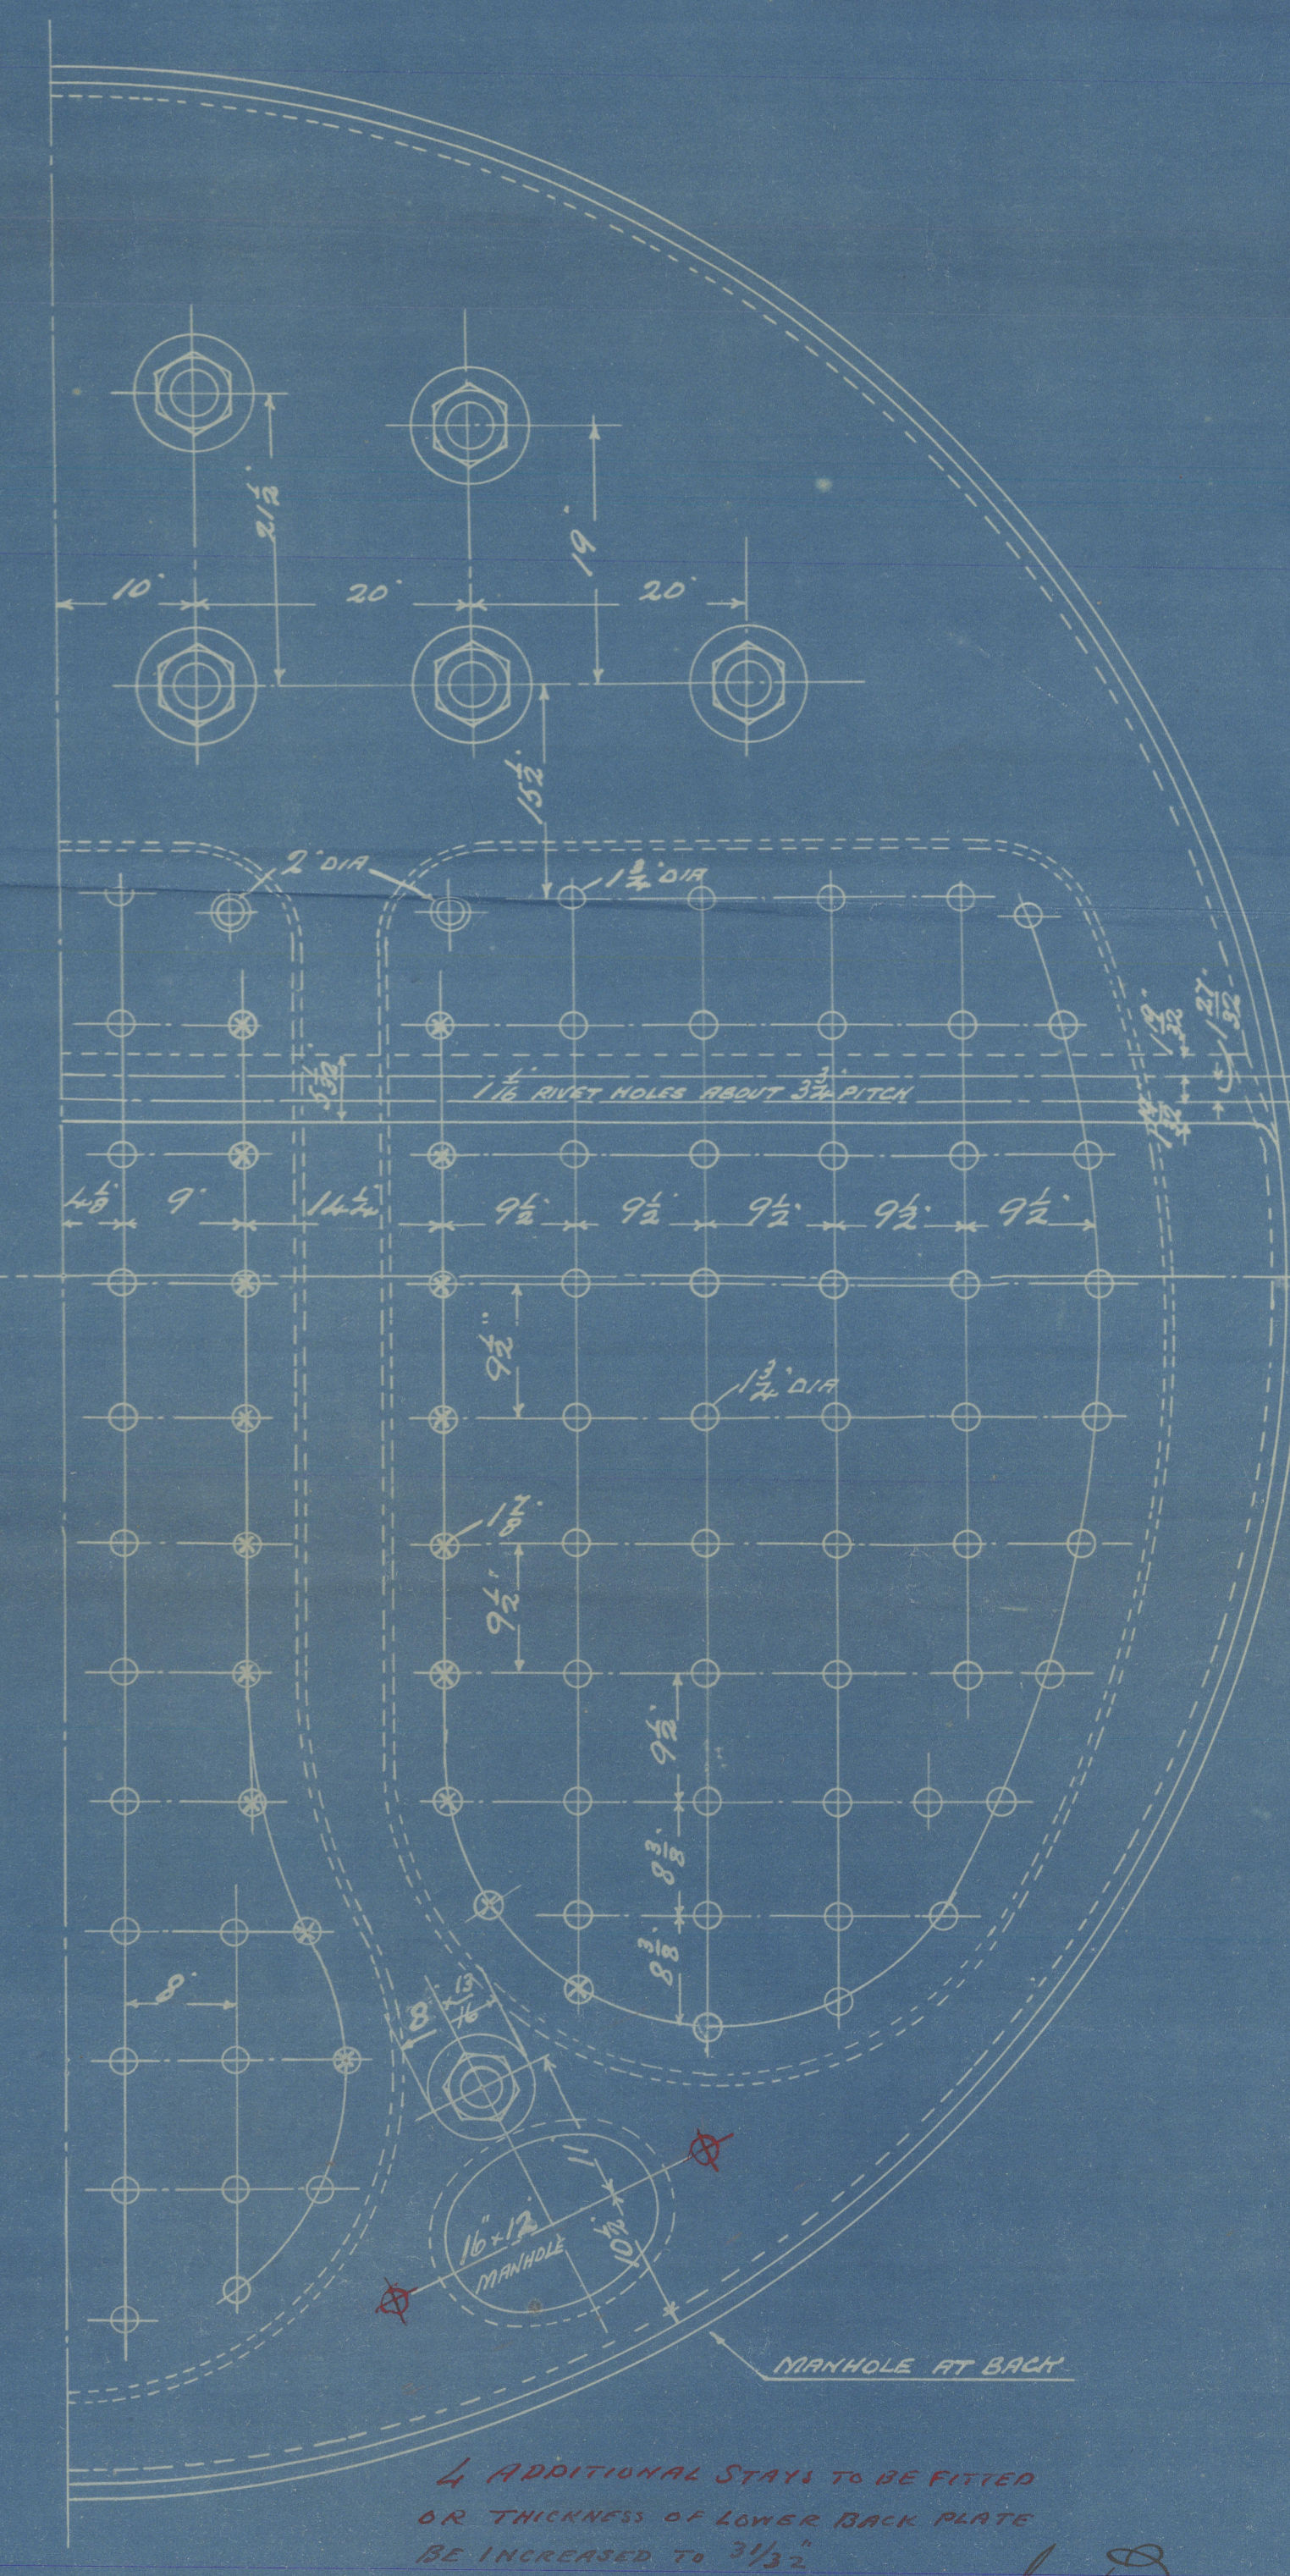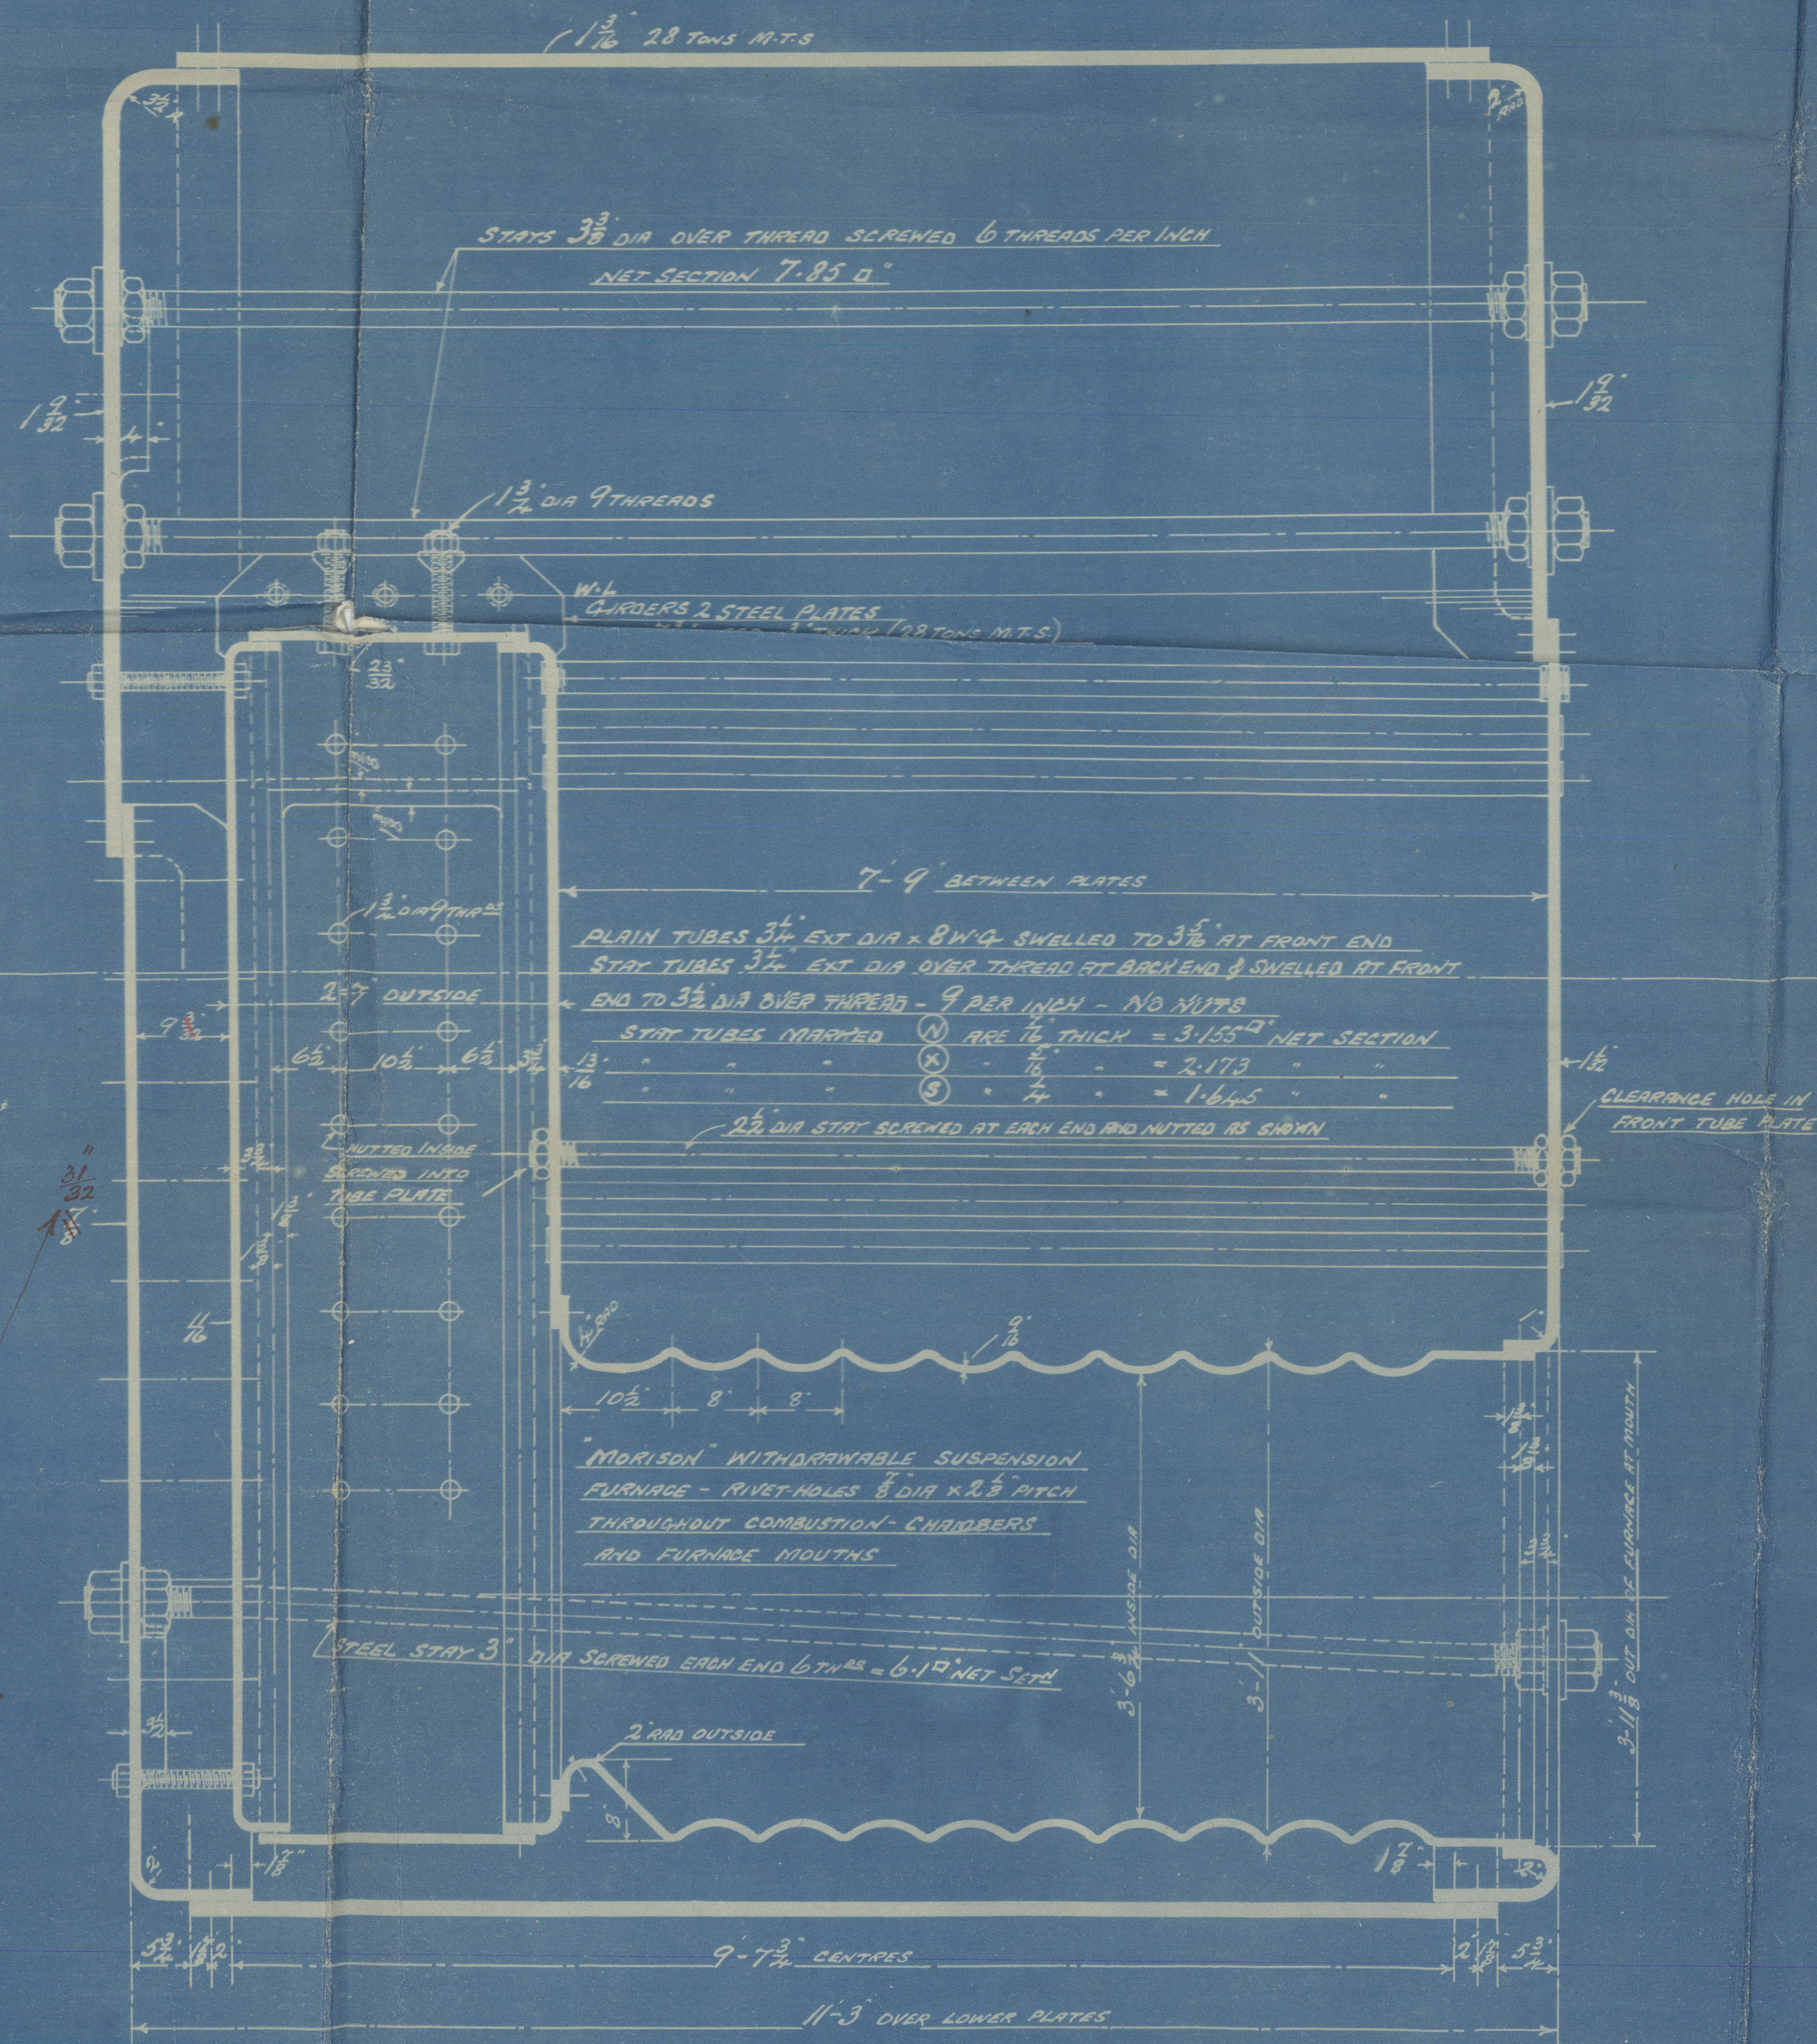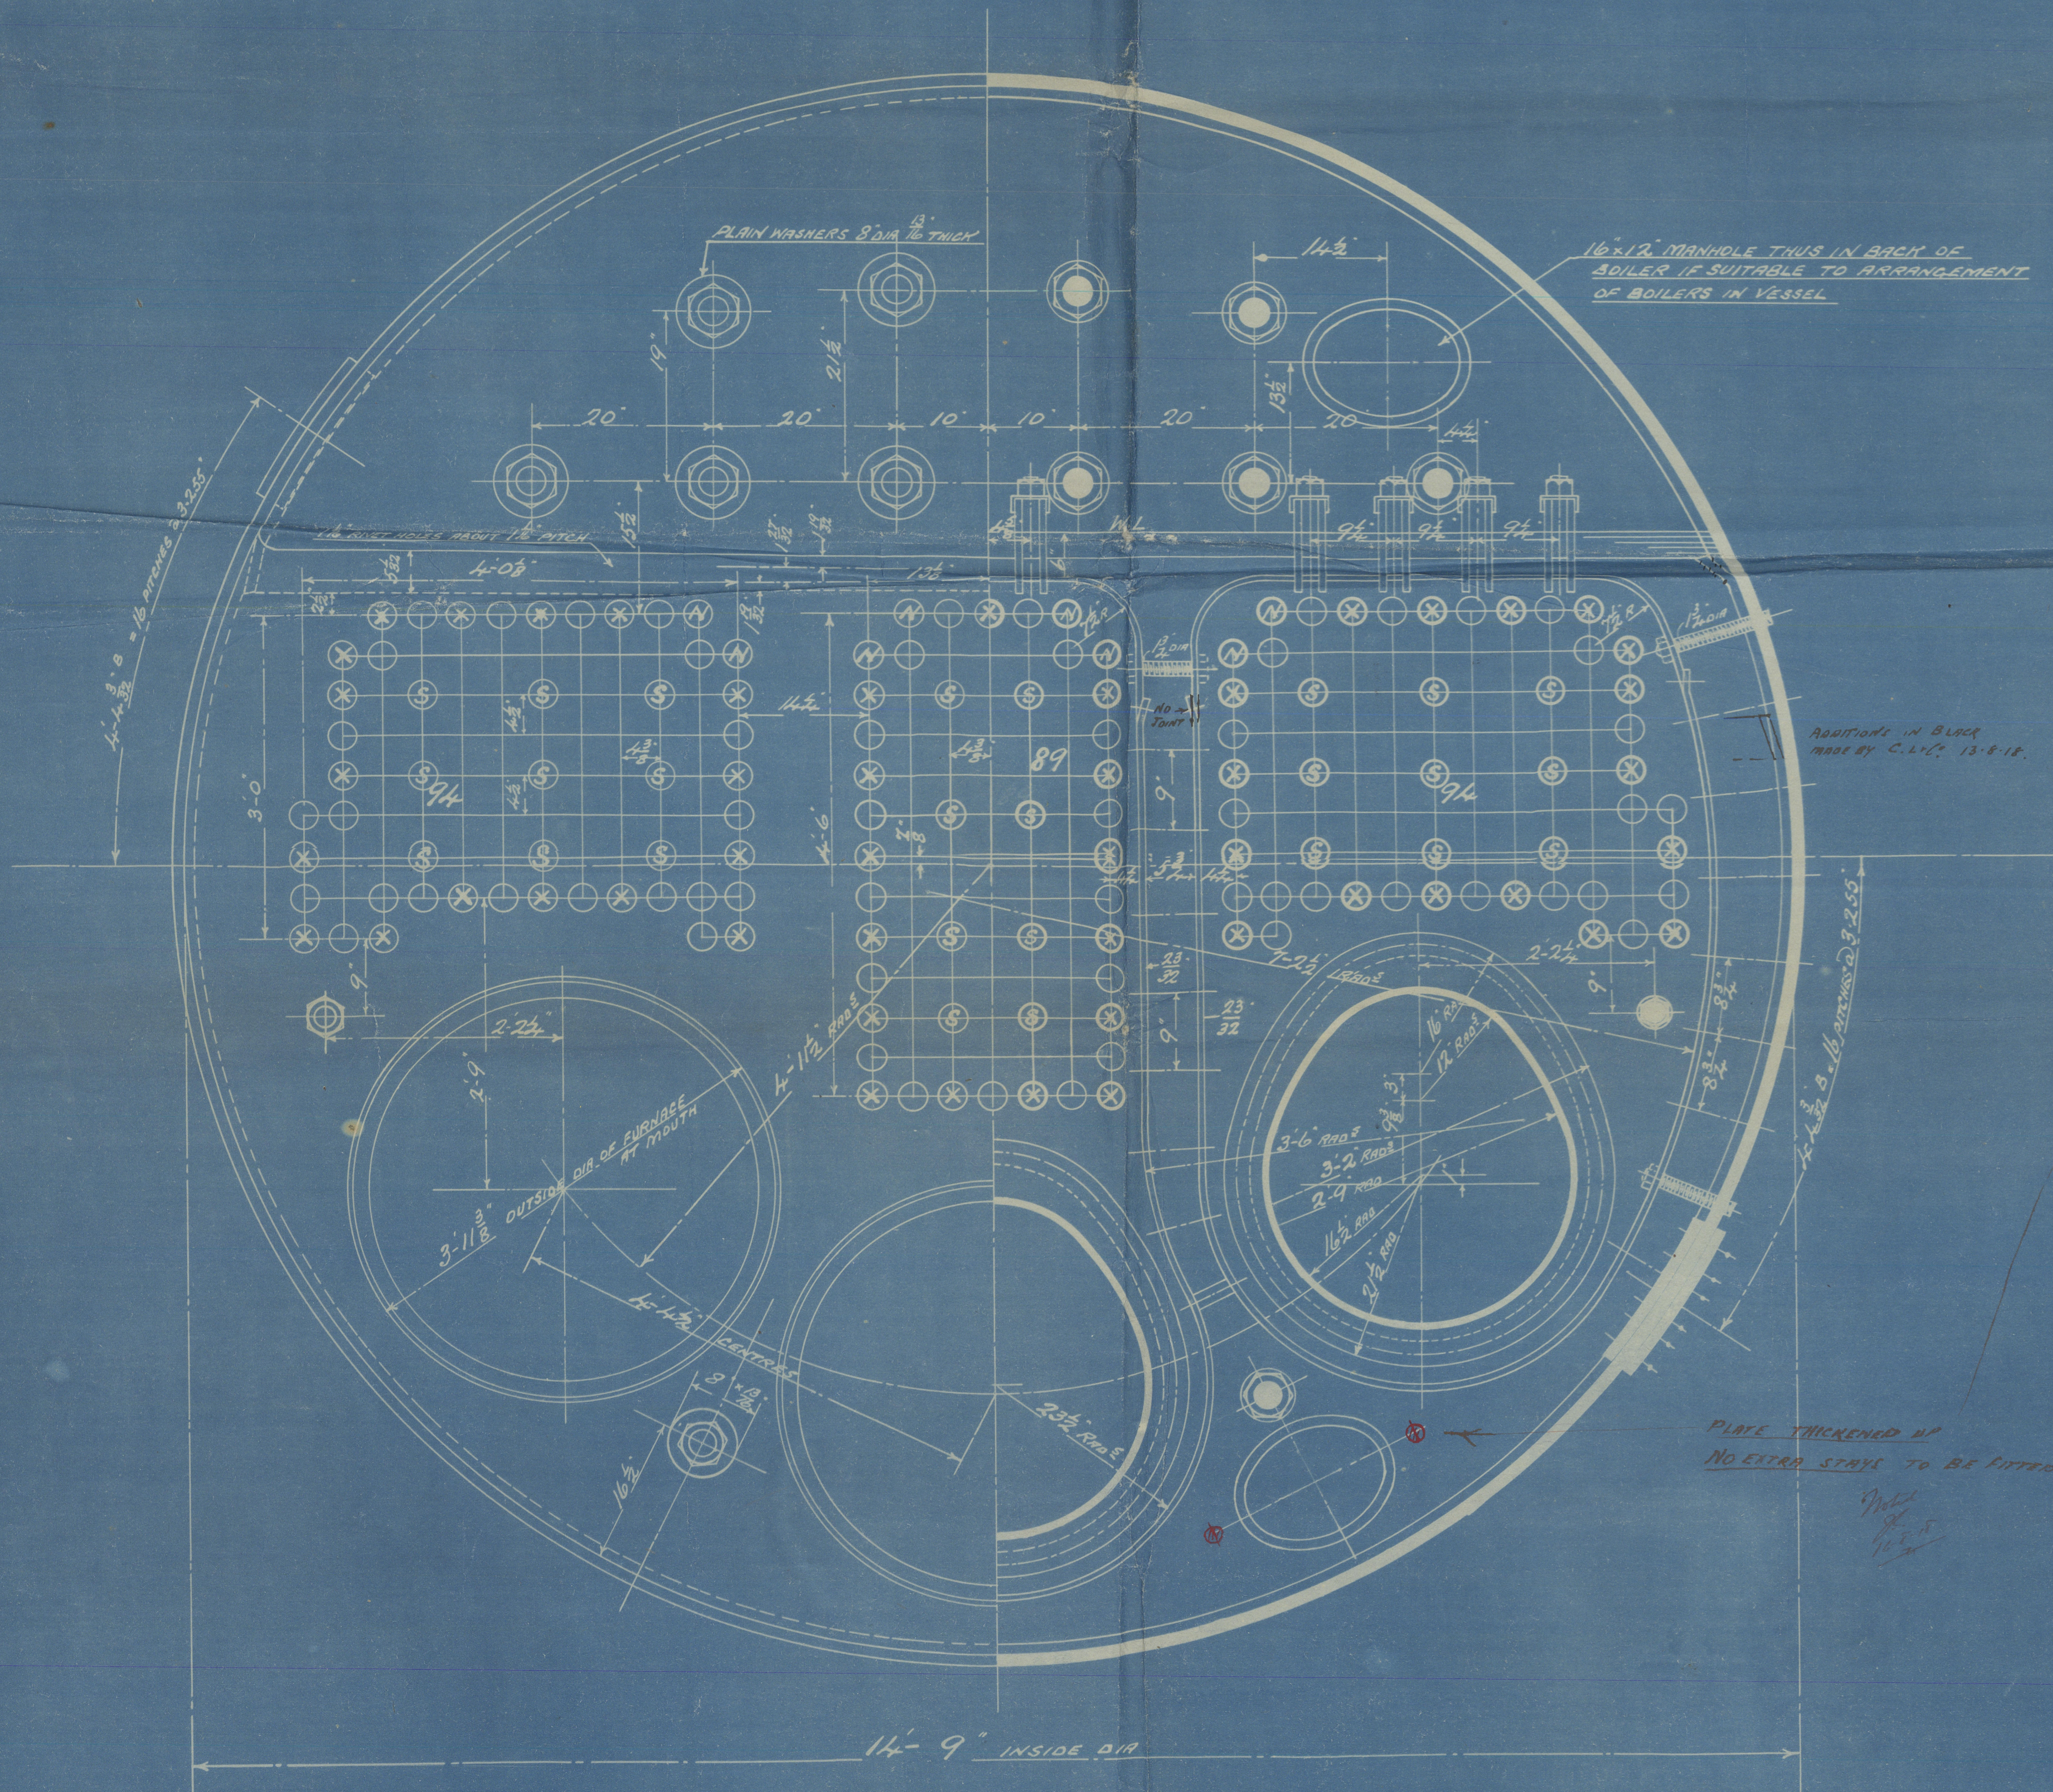

Scale 1" = One Foot

4 ADDITIONAL STAYS TO BE FITTED
 OR THICKNESS OF LOWER BACK PLATE
 BE INCREASED TO 3 1/8"

10.15
 10.18
 10.19
Cammell Band 7th 6

Bulter no 2006

In Seasons
S/S no 106

S. S. *War Yare*


LIVERPOOL.

Report No. *79060*

RETAIR



RETAIR

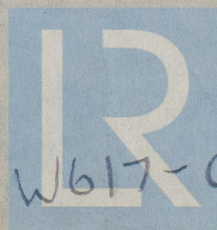

© 2020

W617-0013 Lloyd's Register
Foundation