


12.4.11


No. 799 Ship Shelter Deck Erections.

Scale $\frac{1}{8}$ " = 1 Foot.


Beams Plated over Accommodation

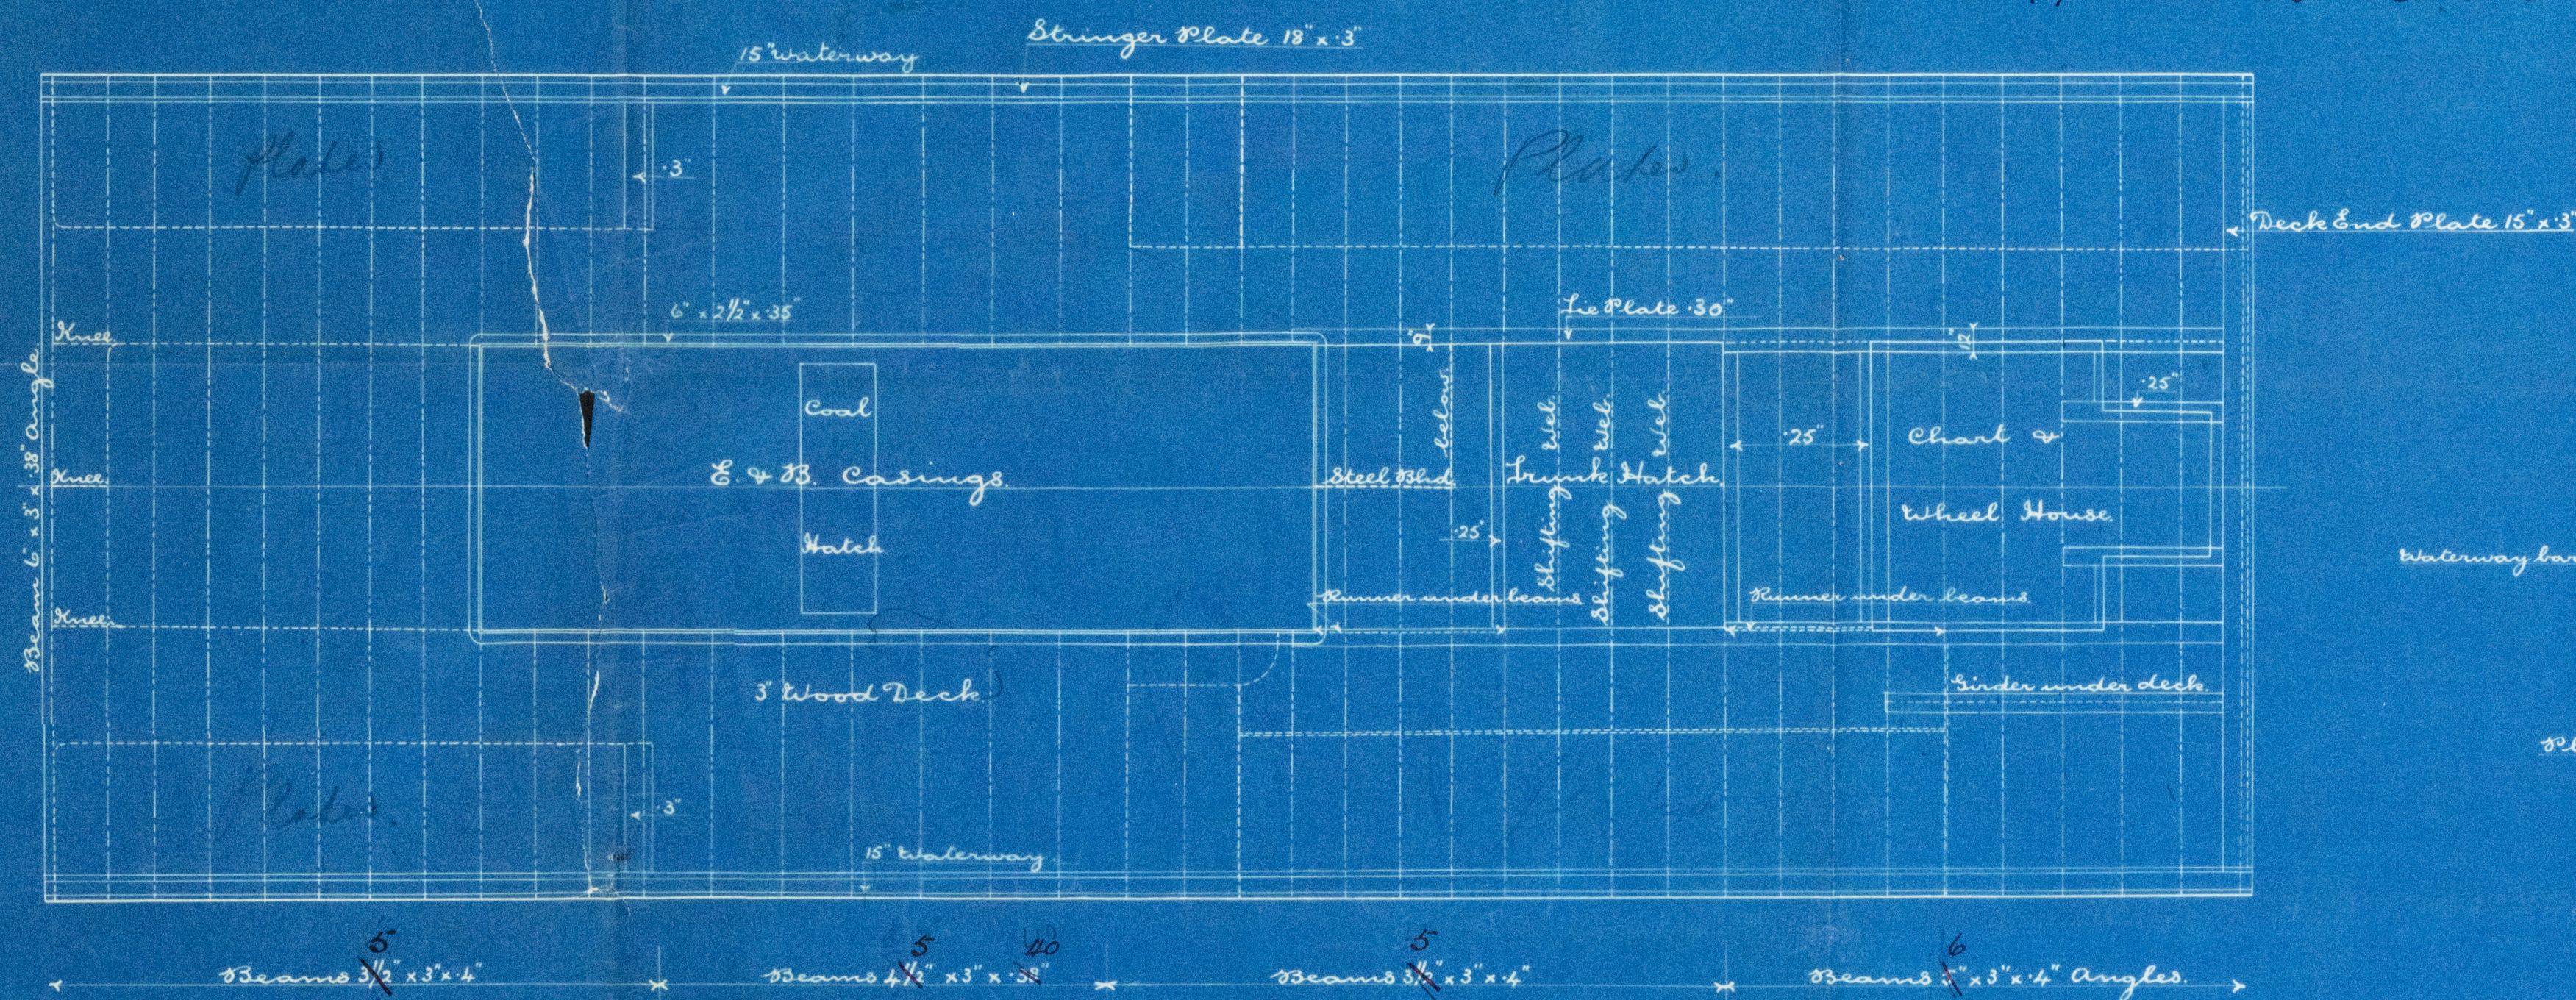

Plan on Boat Deck

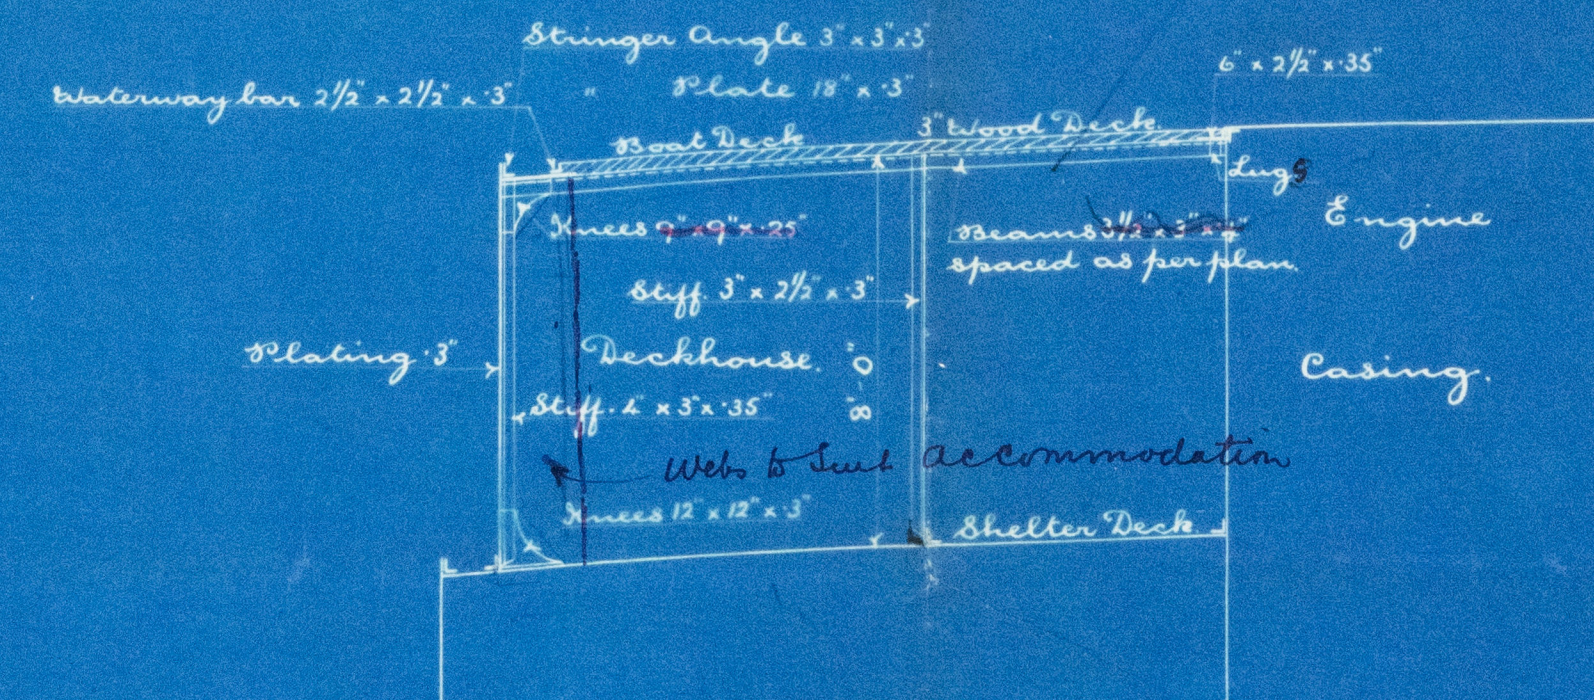

Section

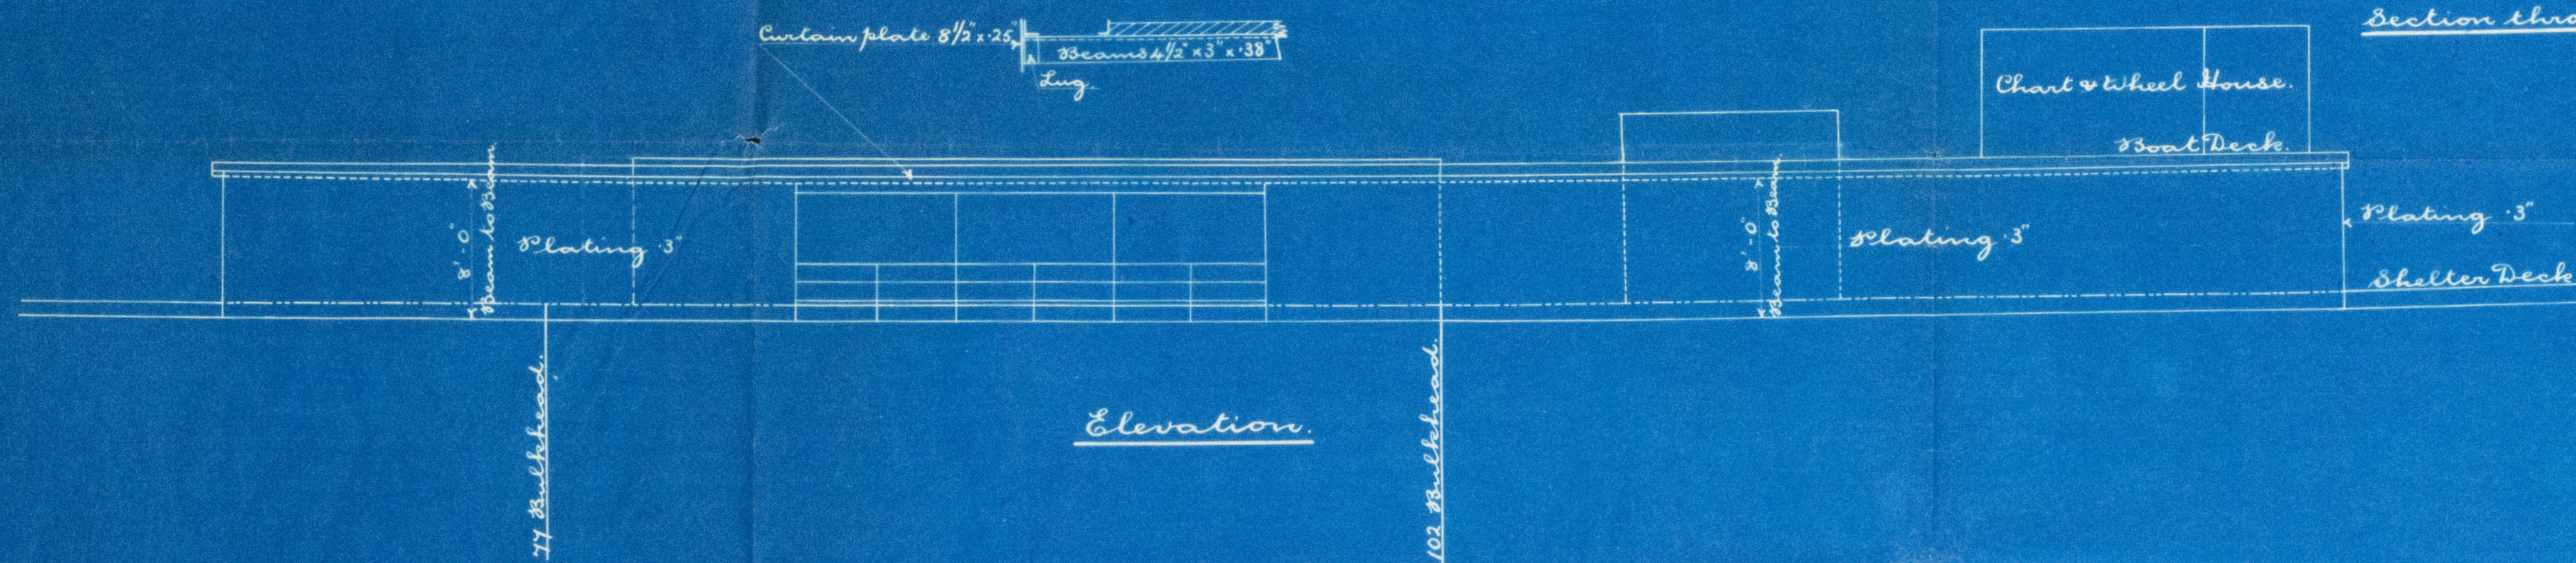

Elevation


Position of webs arranged to suit accommodation



Plan on Shelter Deck

Pillaring to be to the satisfaction of the Surveyor.

C.F.
12.4.11

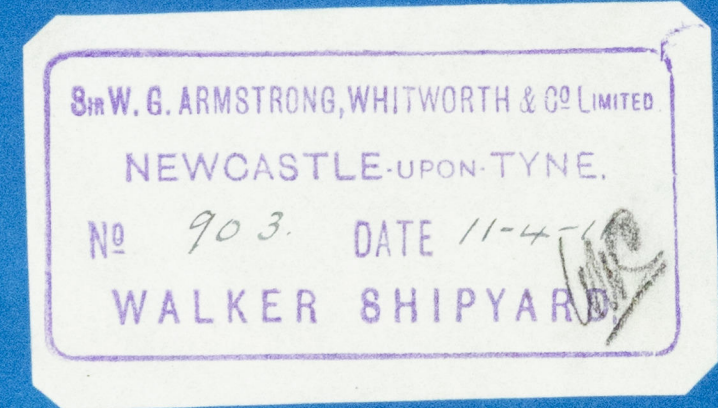

Lloyd's Register
DATE 11-4-11
WALKER SHIPYARD

RETAIN

RETAIN


Sir W. G. Armstrong
Whitworth & Co Ltd

799
Plan of erections on Sheller &c

S.S. "MOGILEFF"

NEWCASTLE - ON - TYNE.

REPORT NO 60765

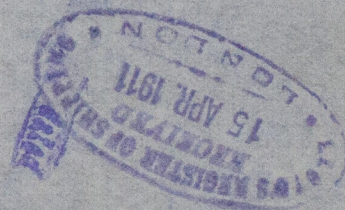

799



© 2021

Lloyd's Register
Foundation