


# S. S. ANGERMANALFVEN.


April 1921.

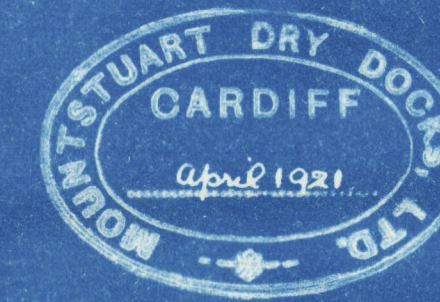

	BALE CAPACITY	GRAIN CAPACITY
HOLD UNDER MAIN DECK.	61750 CFT.	66650 C.F.T.
HOLD IN TWEEN DECKS	26250 "	29150 "
TOTAL	88000 "	95800 "

BUNKERS.	
BUNKER B&S STARD UNDER MAIN DECK FRAMES 22-33	41 TONS.
" " " " TWEEN DECKS " 11-33 & 15-33	107 "
COAL SHUTE	5 "
TOTAL	153 "
WATER BALLAST.	
FORE PEAK TANK.	26.5 TONS.
TANK N° 1	60 "
" N° 2	83 "
" N° 3	104 "
MID TANK	33.5 "
TANK N° 4	36 "
AFTER PEAK TANK.	11 "
TOTAL	360 "

*Amended Profile*

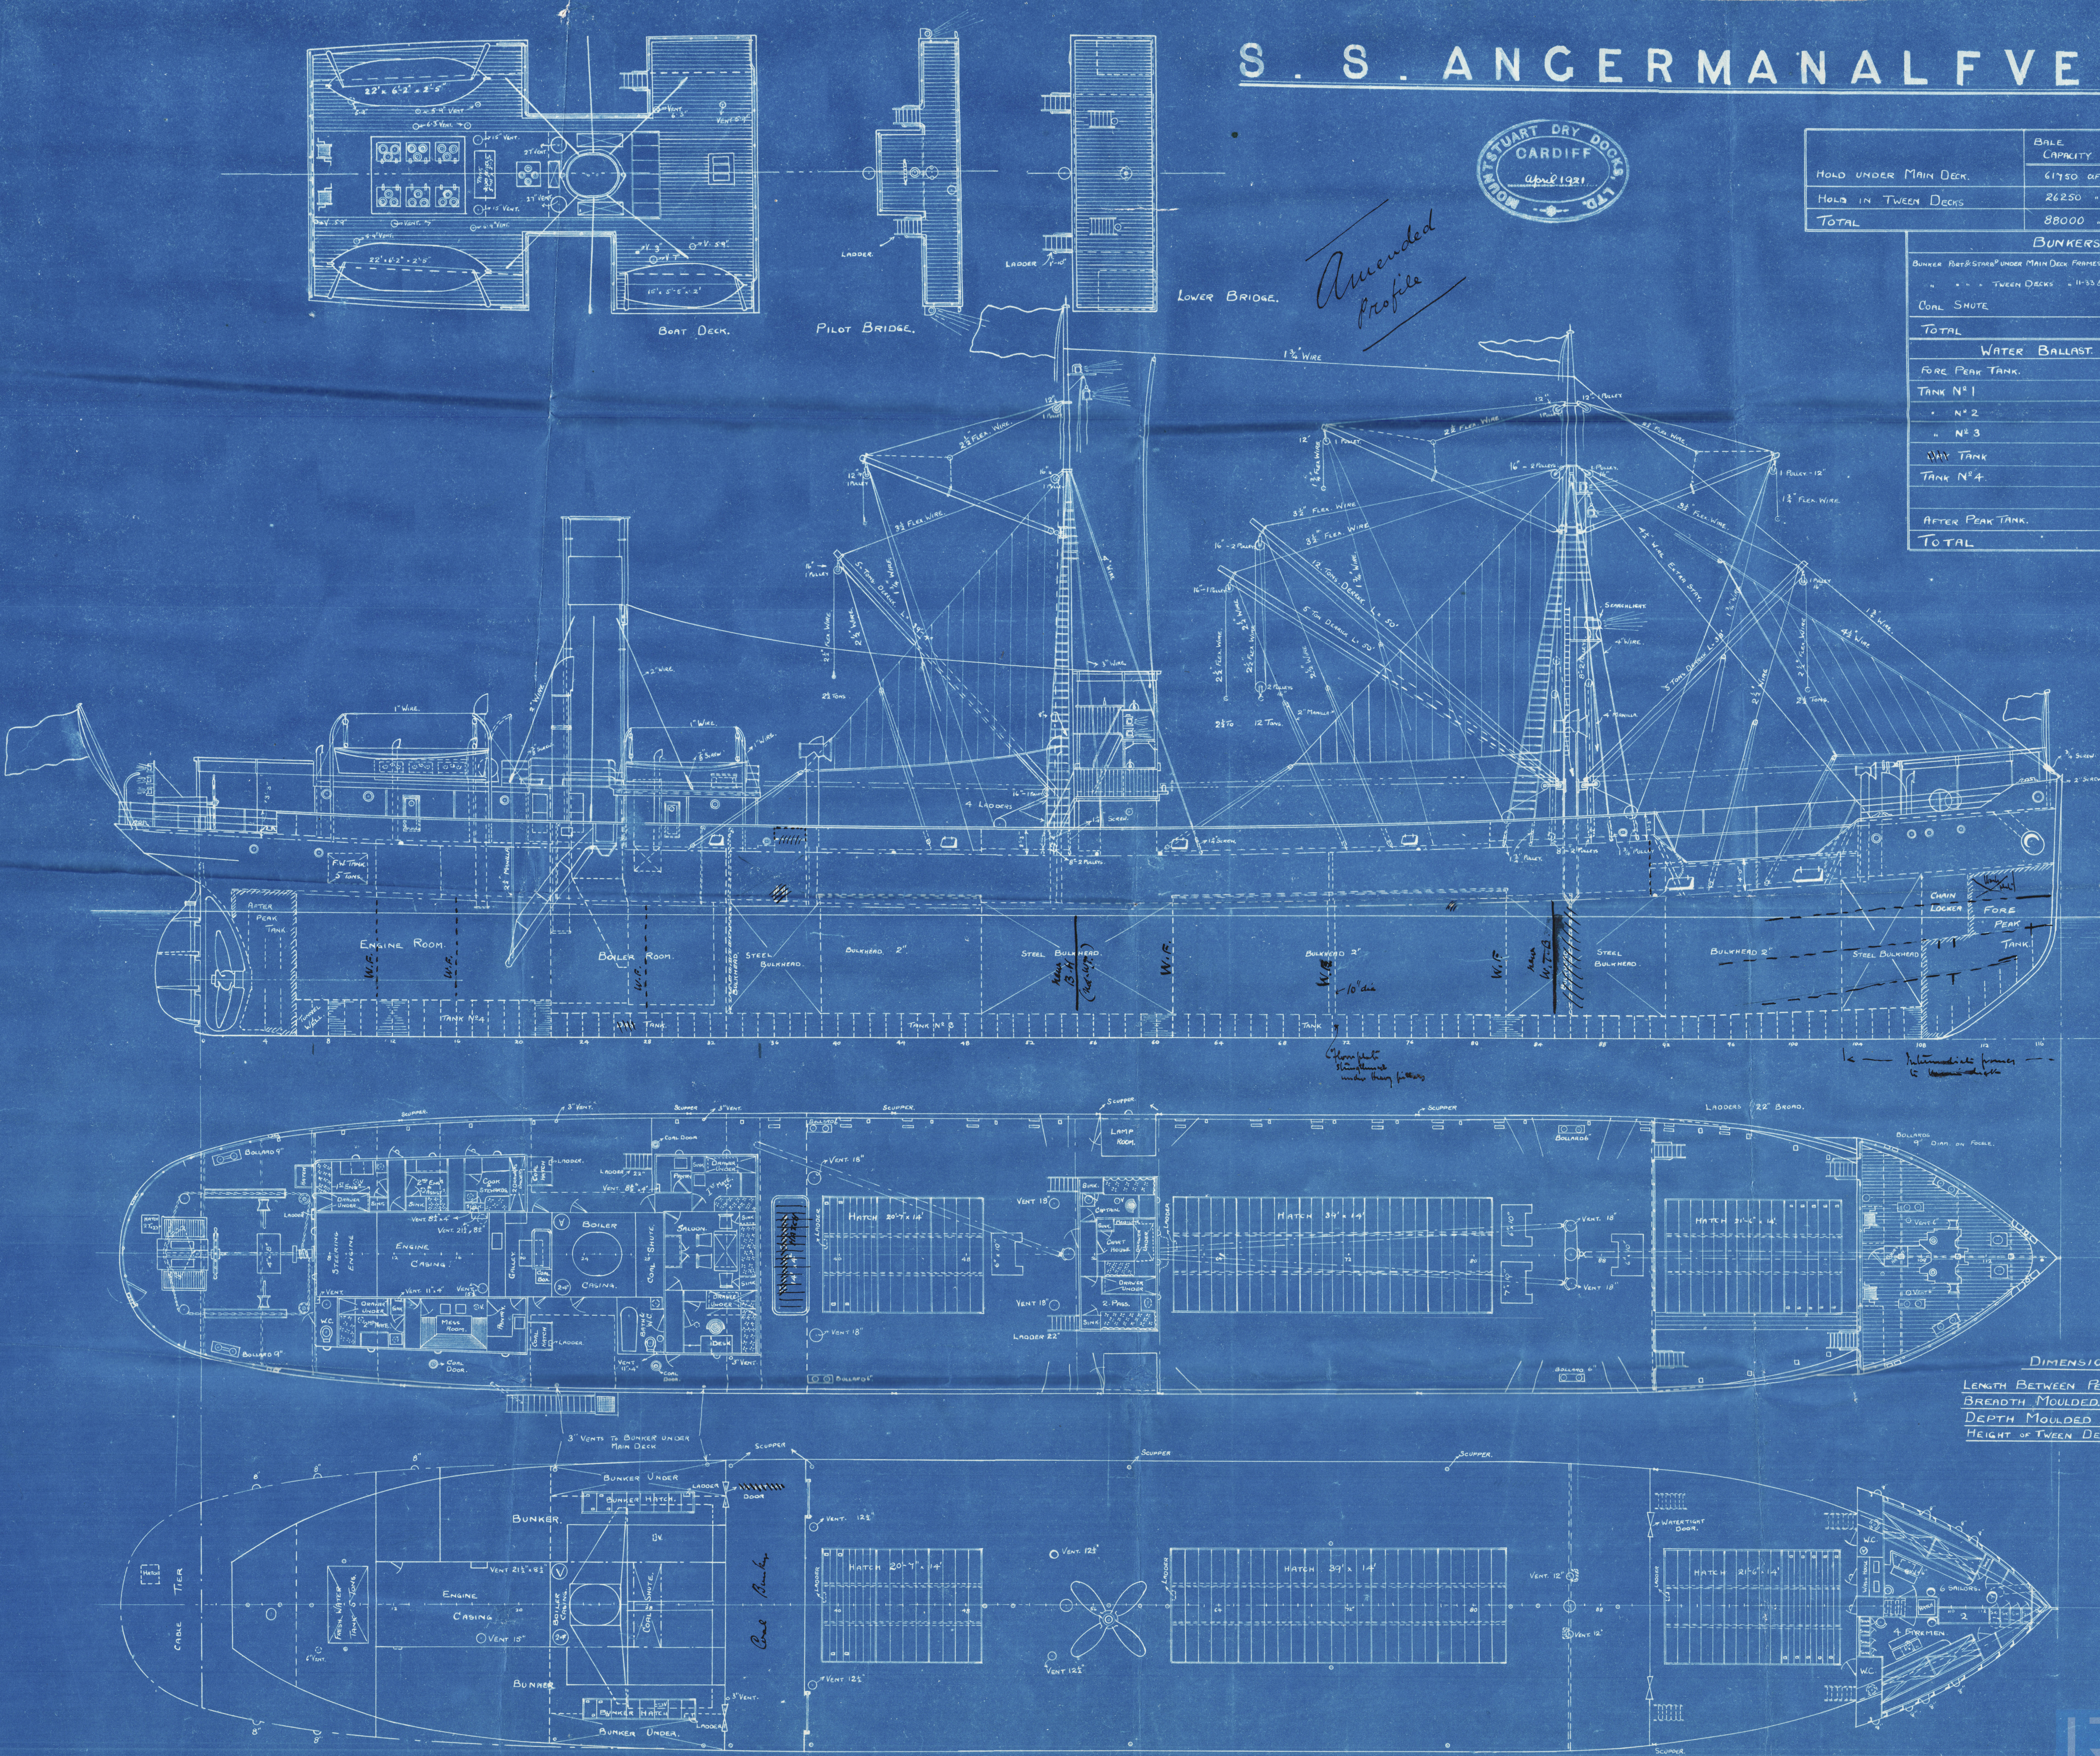

DIMENSIONS.	
LENGTH BETWEEN PERP <sup>s</sup>	230'-0"
BREADTH MOULDED	35'-10"
DEPTH MOULDED TO UPPER DECK	15'-10"
HEIGHT OF TWEEN DECKS	7'-0"

619-0187




BAYCHIMO

<sup>ex</sup>  
Augomenalfrun

CARDIFF / Post. No. 42724

General aragt.

RETAIR

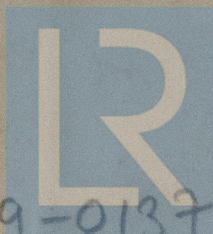

© 2020

Lloyd's Register  
Foundation

W619-0137