

# MIDSHIP SECTION.


SCALE 1/2" = ONE FOOT

NOS 384-385

DIMENSIONS - 424.75 x 56.0 MLD x 30.7 1/2 D.MLD

DECK PLATING 40 UNDER WOOD SHEATHING. 46 CLEAR OF WOOD SHEATHING TO 42 AT ENDS INCREASED AT OPENINGS AS PER DECK PLAN. BUTTS DOUBLE FOR 1/2 L. SINGLE AT ENDS. SEAMS ALL SINGLE.

SKETCH SHOWING BEAM KNEE CONNECTION IN WAY OF DOOR FRAME

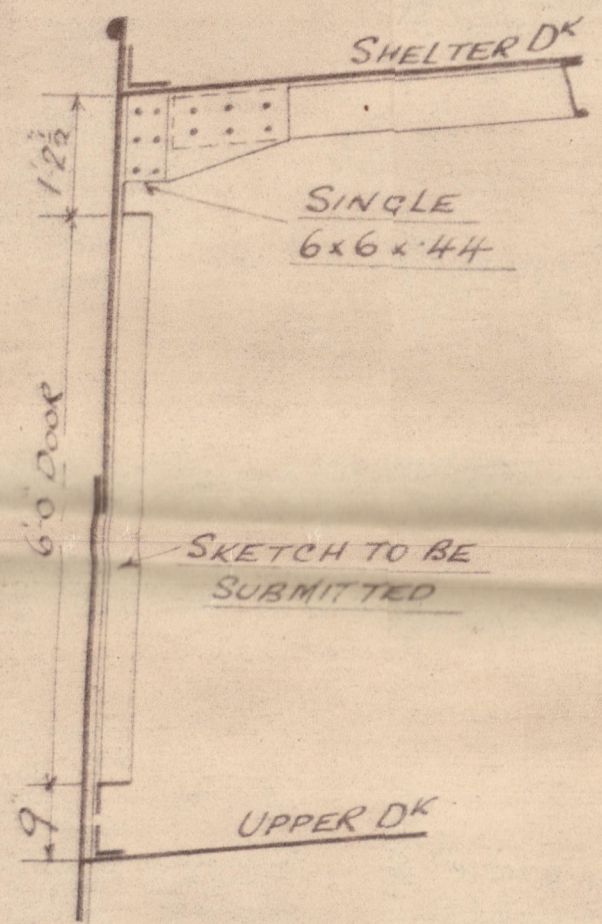

N. 65 1/2 x 72 to 46  
BUTTS QUAD OVERLAPS WITH 1" RIVETS & 1/4" OVERLAPS FOR 1/2 LENGTH TO TREBLE AT ENDS. INCREASED .02 FOR SIDELIGHTS. TO 72 TO 46.

M. 63 1/4 x 66 to 46  
BUTTS QUAD OVERLAPS WITH 1/8 RIVETING & 1/2" OVERLAPS TO TREBLE AT ENDS.

L. 63 1/4 x 64 to 46

BUTTS TREBLE OVERLAPS

K. 63 1/4 x 64 to 46

BUTTS TREBLE OVERLAPS.

J. 63 1/4 x 64 to 46

BUTTS TREBLE OVERLAPS.

H. 63 1/4 x 64 to 46

BUTTS TREBLE OVERLAPS.


G. 63 1/4 x 66 to 46

BUTTS TREBLE OVERLAPS.

F. 62 x 66 to 48

BUTTS TREBLE OVERLAPS.

CONNECTION OF OUTSIDE BRACKETS TO MARGIN PLATE TO BE BY SINGLE 6x6x50 TO 48 WITH 12 1/8 RIVETS EACH WAY THROUGHOUT. GUSSETS FROM COLLISION BULKHEAD TO ENGINE ROOM BULKHEAD SPACED EQUAL TO RULE.

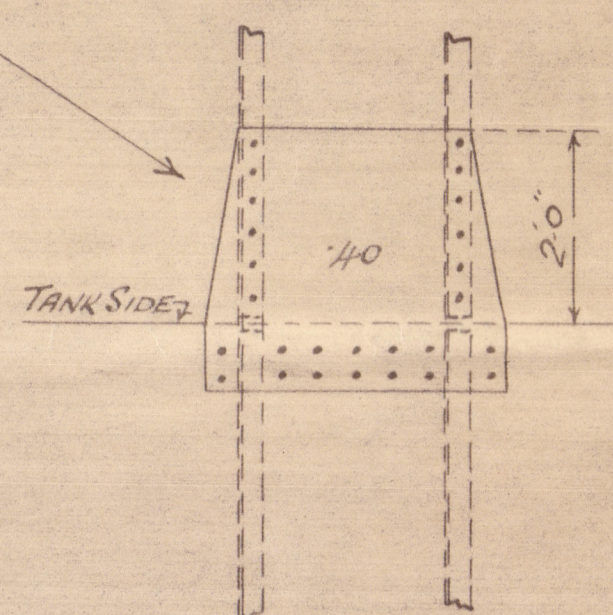

STRINGER 57 x 56 to 36 x 44  
BUTTS TREBLE OVERLAPS  
STRINGER ANGLE 5x5x62 TO 3 1/2 x 3 1/2 x 44

STRINGER 57 x 48 to 36 x 44  
BUTTS TREBLE OVERLAPS  
STRINGER ANGLE 3 1/2 x 3 1/2 x 48 TO 44  
INSIDE BAR KEPT 2" INSIDE FRAMES

STRINGER 58 x 44 to 36 x 44  
BUTTS TREBLE OVERLAPS  
STRINGER ANGLE 3 1/2 x 3 1/2 x 48 TO 44  
INSIDE BAR KEPT 2" INSIDE FRAMES

SIDE STRINGER

FACE BAR - 7 x 3 1/2 x 50 OR  
PLATE - 44  
SHELL LUGS - 3 1/2 x 3 1/2 x 44  
FRAME LUGS - 4 x 3 1/2 x 44

MARGIN PLATE RULE 35 x 48 & 58 IN BOILER SPACE  
BUTTS TREBLE OVERLAPS  
MARGIN ANGLE 4 x 4 x 48

HEIGHT OF BRACKETS MAINTAINED FORWARD

KNEES 40 TO 36

16x12

16x12

RIVETING OF BEAMS TO PLATING 7 DIAS APART UNDER 55.0  
THROUGH BEAMS 7 x 3 1/2 x 40 B.A. 26" APART WHERE SUPPORTED BY 3 ROWS OF PILLARS  
HALF " 7 x 3 1/2 x 40 " " " IN WAY OF HATCHES  
" " 8 x 3 1/2 x 44 " " " IN WAY OF MACHINERY SPACE  
STRONG " 9 x 3 1/2 x 66 ACROSS ENGINE SPACE, SPACED AS PER PROFILE WITH KNEES 28 x 54

RIVETING OF BEAMS TO PLATING 7 DIAS APART UNDER 56.0  
THROUGH BEAMS 7 x 3 1/2 x 40 B.A. 26" APART WHERE SUPPORTED BY 3 ROWS OF PILLARS  
HALF " 7 x 3 1/2 x 40 " " " IN WAY OF HATCHES  
" " 8 x 3 1/2 x 44 " " " IN MACHINERY SPACE  
STRONG BEAMS ACROSS ENGINE SPACE AS PER PROFILE.

RIVETING OF BEAMS TO PLATING 7 DIAS APART 56.0  
THROUGH BEAMS CLEAR OF PEAKS 8 x 3 1/2 x 42 B.A. 26" APART SUPPORTED BY 3 ROWS OF PILLARS  
" " IN PEAKS 7 x 3 1/2 x 40 B.A. 24" KNEES 24 x 46  
HALF BEAMS IN WAY OF ENGINE CASING 8 1/2 x 3 1/2 x 48 B.A. 26" APART  
STRONG BEAMS ACROSS ENGINE CASING AS PER PROFILE

FRAMES IN HOLDS & ENGINE ROOM 10 x 3 1/2 x 52 B.A. 26" APART. RIVETS 7 DIAS (EXCEPT DEEP TANK WHERE 5 1/2 DIA 15)  
FRAMES IN PEAKS 7 1/2 x 3 1/2 x 44 B.A. 24" APART. RIVETS 5 1/2 DIAS

SCREW FRAME = PROPELLER POST 10 1/2 x 8  
STEM BAR = 10 1/2 x 2 3/4  
RUDDER PLAN TO BE SUBMITTED

TANK TOP IN HOLDS 40 TO 36  
" " " ENGINE SPACE 50  
" " BUTTS DOUBLE FOR 1/2 L. SINGLE AT ENDS

CEILING LAID THROUGHOUT HOLDS  
NO MANHOLE IN WAY OF PILLARS.

FLOORS 40 TO 36

22x16
























SHELTER DECK  
3 1/2 x 3 1/2 x 44

PILLARS 2 1/8 DIA 52" APART

UPPER DECK  
3 1/2 x 3 1/2 x 44  
116 BARS

PILLARS 2 1/4 DIA 52" APART

MAIN DECK  
3 1/2 x 3 1/2 x 46

NUMBERS.

|                  |                       |
|------------------|-----------------------|
| BEAM MOULDED     | 56.0                  |
| DEPTH MOULDED    | 30.625                |
| 86.625           | TRANSVERSE NO         |
| LENGTH           | 424.75                |
| 36790            | LONGITUDINAL NO       |
| DEPTHS TO LENGTH | 10.45 TO SHELTER DECK |
| DEPTH MOULDED    | 30.625                |
| DOUBLE BOTTOM    | 3.666                 |
| TWEEN DECKS      | 9.0 12.666            |
| d                | 17.969                |

PILLARS 4 1/4 DIA 52" APART. INCREASED AT ENDS PER RULE  
ARRANGEMENT OF WIDE SPACED QUARTER PILLARS & GIRDERS AS PER SEPARATE PLAN.

EQUIPMENT AS PER RULE

CENTRE PLATE RULE 44 x 52 TO 48  
60 x 50 TO 40  
BUTTS TREBLE OVERLAPS WHERE OVER 48  
REMAINDER DOUBLE

3 1/2 x 3 1/2 x 52 TO 48 (NO STRAP ANGLES)  
CENTRE KEELSON 44 x 52 TO 42  
BUTTS TREBLE OVERLAPS  
LUGS 6x6x50 FOR 1/2 L. & WITH 11 RIVETS.  
3 1/2 x 3 1/2 x 40 AT ENDS WITH 7 RIVETS.  
4 1/2 x 4 1/2 x 60 TO 56 (NO STRAP ANGLES)

KEEL 48 x 106 TO 74  
BUTTS DOUBLE STRAPS  
TREBLE RIVETED WITH 1/8 RIVETING & 2 1/2 STRAPS

44 x 56

3 1/2 x 3 1/2 x 62

LUGS 6x6x60

44 x 60

4 1/2 x 4 1/2 x 60

SHORT BROTHERS LTD  
SHIPBUILDERS.

SUNDERLAND 2020  
Lloyd's Register  
Foundation

SECTION IN WAY OF BOILER WELL.

W679-0215



Messrs Short Bros

384

Middle Section (As Shet)

P.D. "Moonish Prince"

Lo. Regt No. 26112

RETAIN

RETAIN



W 619-0215

© 2020

Lloyd's Register  
Foundation