

MESSRS SHORT BROS. S.S. N^o 384

SCALE 1 INCH TO A FOOT.

TO PASS "LLOYDS" & "BOARD OF TRADE" SURVEY, FOR A WORKING PRESSURE OF 220. LBS. PER SQ. INCH.


FITTED WITH MESSRS J. HOWDEN'S SYSTEM OF FORCED DRAUGHT.

23/5/13



" CRATE " " " " " = 188.5 " " 5-6 BARS

ALL HOLES DRILLED IN PLACE AFTER BENDING.

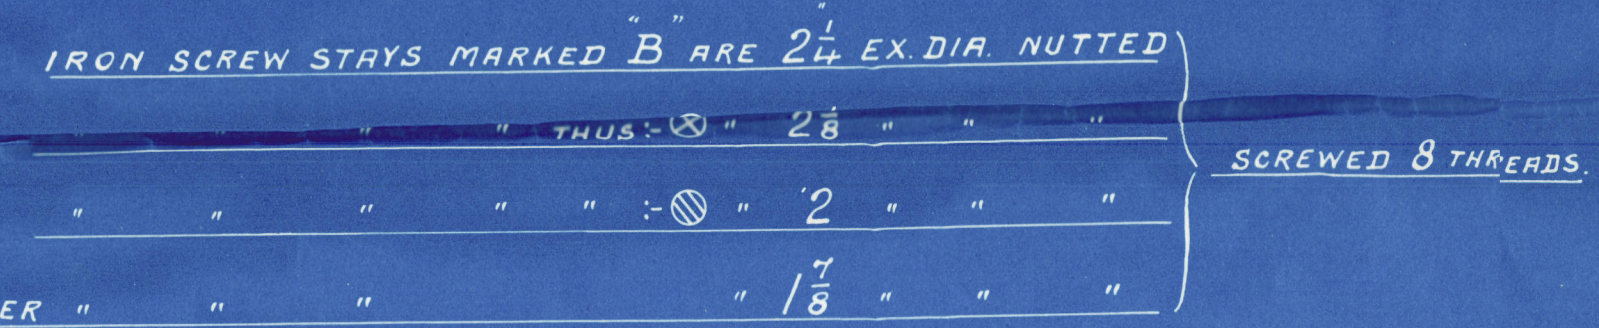


23. 5. 13

93.5.13.



3 Main Boilers
Messrs Blair & Co Ltd
No 1792
for
Messrs Short Bros Ltd
S.S. No 384
Working Press 220 lbs
S.S. Moorish Prince

RETA

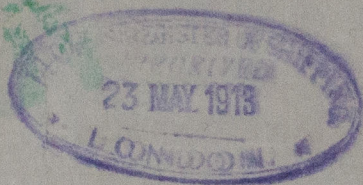

No. 5267
LLOYD'S TEST
440 lbs.
2.4.14 - W.M

Wab. 8394

RETA

W619-0216



© 2020

Lloyd's Register
Foundation

Lloyd's
Register



© 2020

Lloyd's Register
Foundation

From **BLAIR & CO., Ltd.,**
STOCKTON-on-TEES.

For Enclosure to

Messrs Lloyds Engineer Surveyors
Middlesbro

W619-0216^{2/2}