


SCALE $\frac{1}{8}" = 1 \text{ FOOT}$

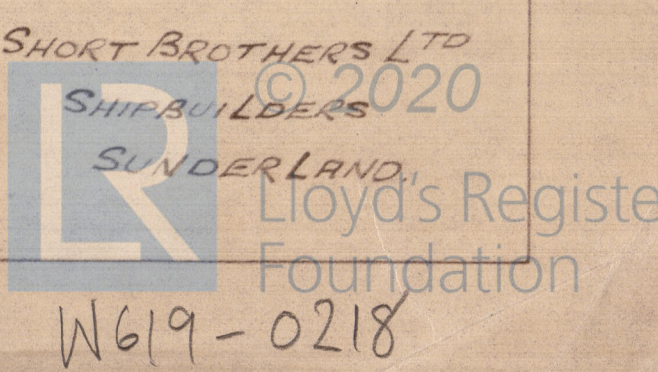

SUNDERLAND

Messrs SHOPT BROS

Profile (as built)

No. 384

S.S. Moorish Prince

Des. Report No 26112

REMAIN

REMAIN




© 2020

Lloyd's Register
Foundation