



17.12.04


PROFILE No 90. SCALE 1/8 INCH = 1 FOOT.

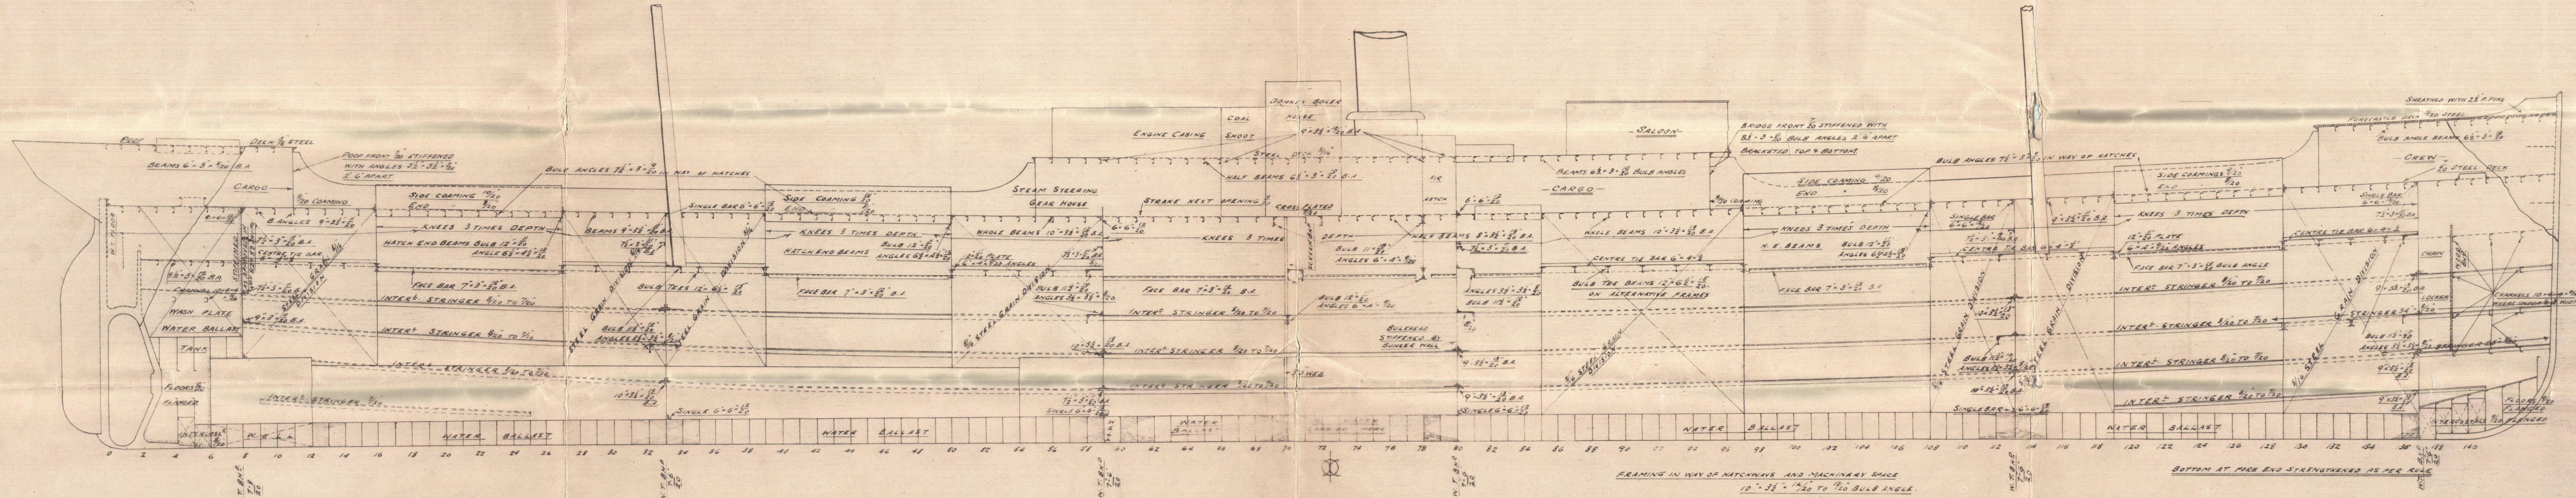

17.12.04

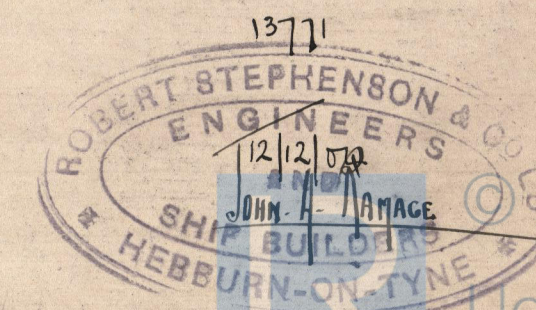

Returned 21.12.04
Lloyd's Register
Foundation
W621-0046

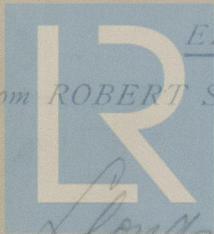

ENCLOSURE

© 2020

From ROBERT STEPHENSON & Co., Ltd.,

for Lloyd's Register
Foundation

Lloyds Surveyors.




44
360

W621-0046½

R Stephenson & Co Ltd
S/s No 90

Profile

S/s "TEESBRIDGE"

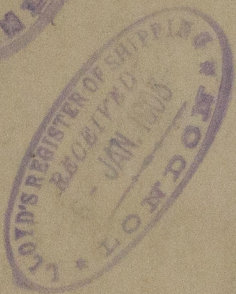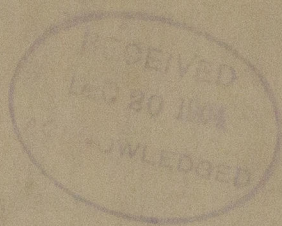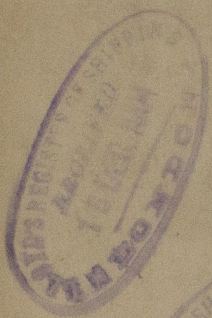

S.S. 'Teesbridge'

Newcastle Report

No 102444



REMAIN



© 2020

Lloyd's Register
Foundation