





28.12.04  
15: 7: 05  
20: 7: 05

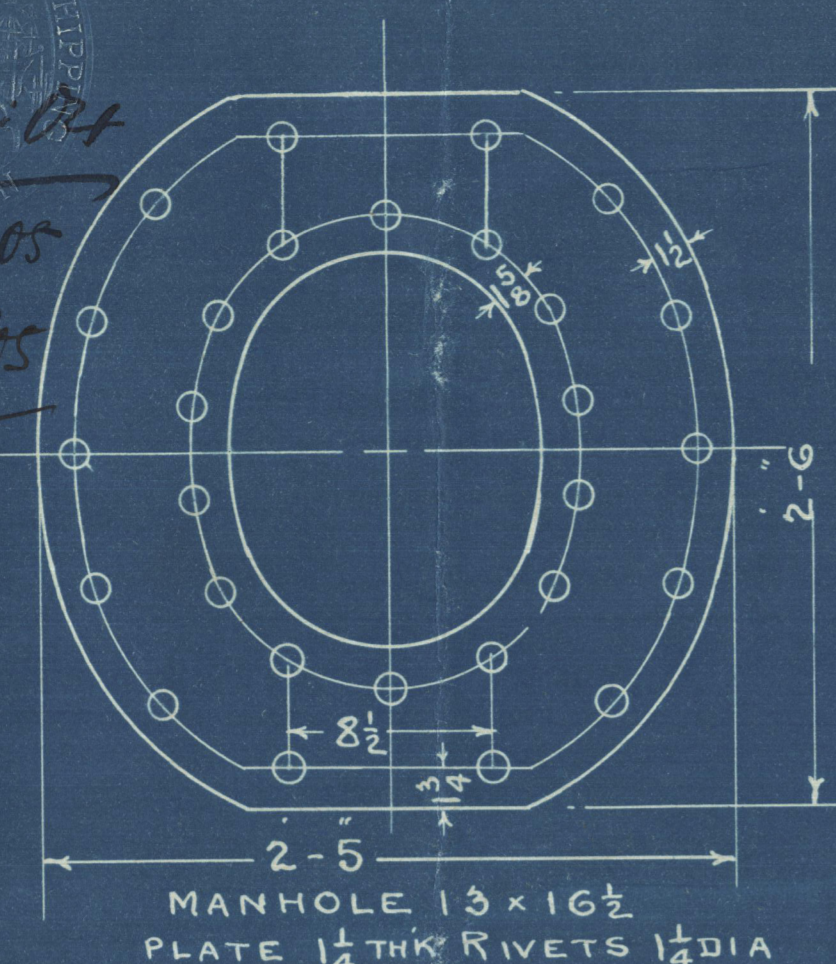

TO BE FITTED TO MESSRS R. STEPHENSON & CO'S SS N° 90.  
TO PASS LLOYDS SURVEY FOR A WORKS PRESS OF 180 LBS PER IN<sup>2</sup>  
TO BE TESTED IN THE PRESENCE OF LLOYDS & OWNER SURVEYORS.

*Tensile of Shell Plates = 28.5 tons per sq inch*  
*Main Stay = 27.0 " 32.0 "*

SCALE 1 IN = 1 FOOT.

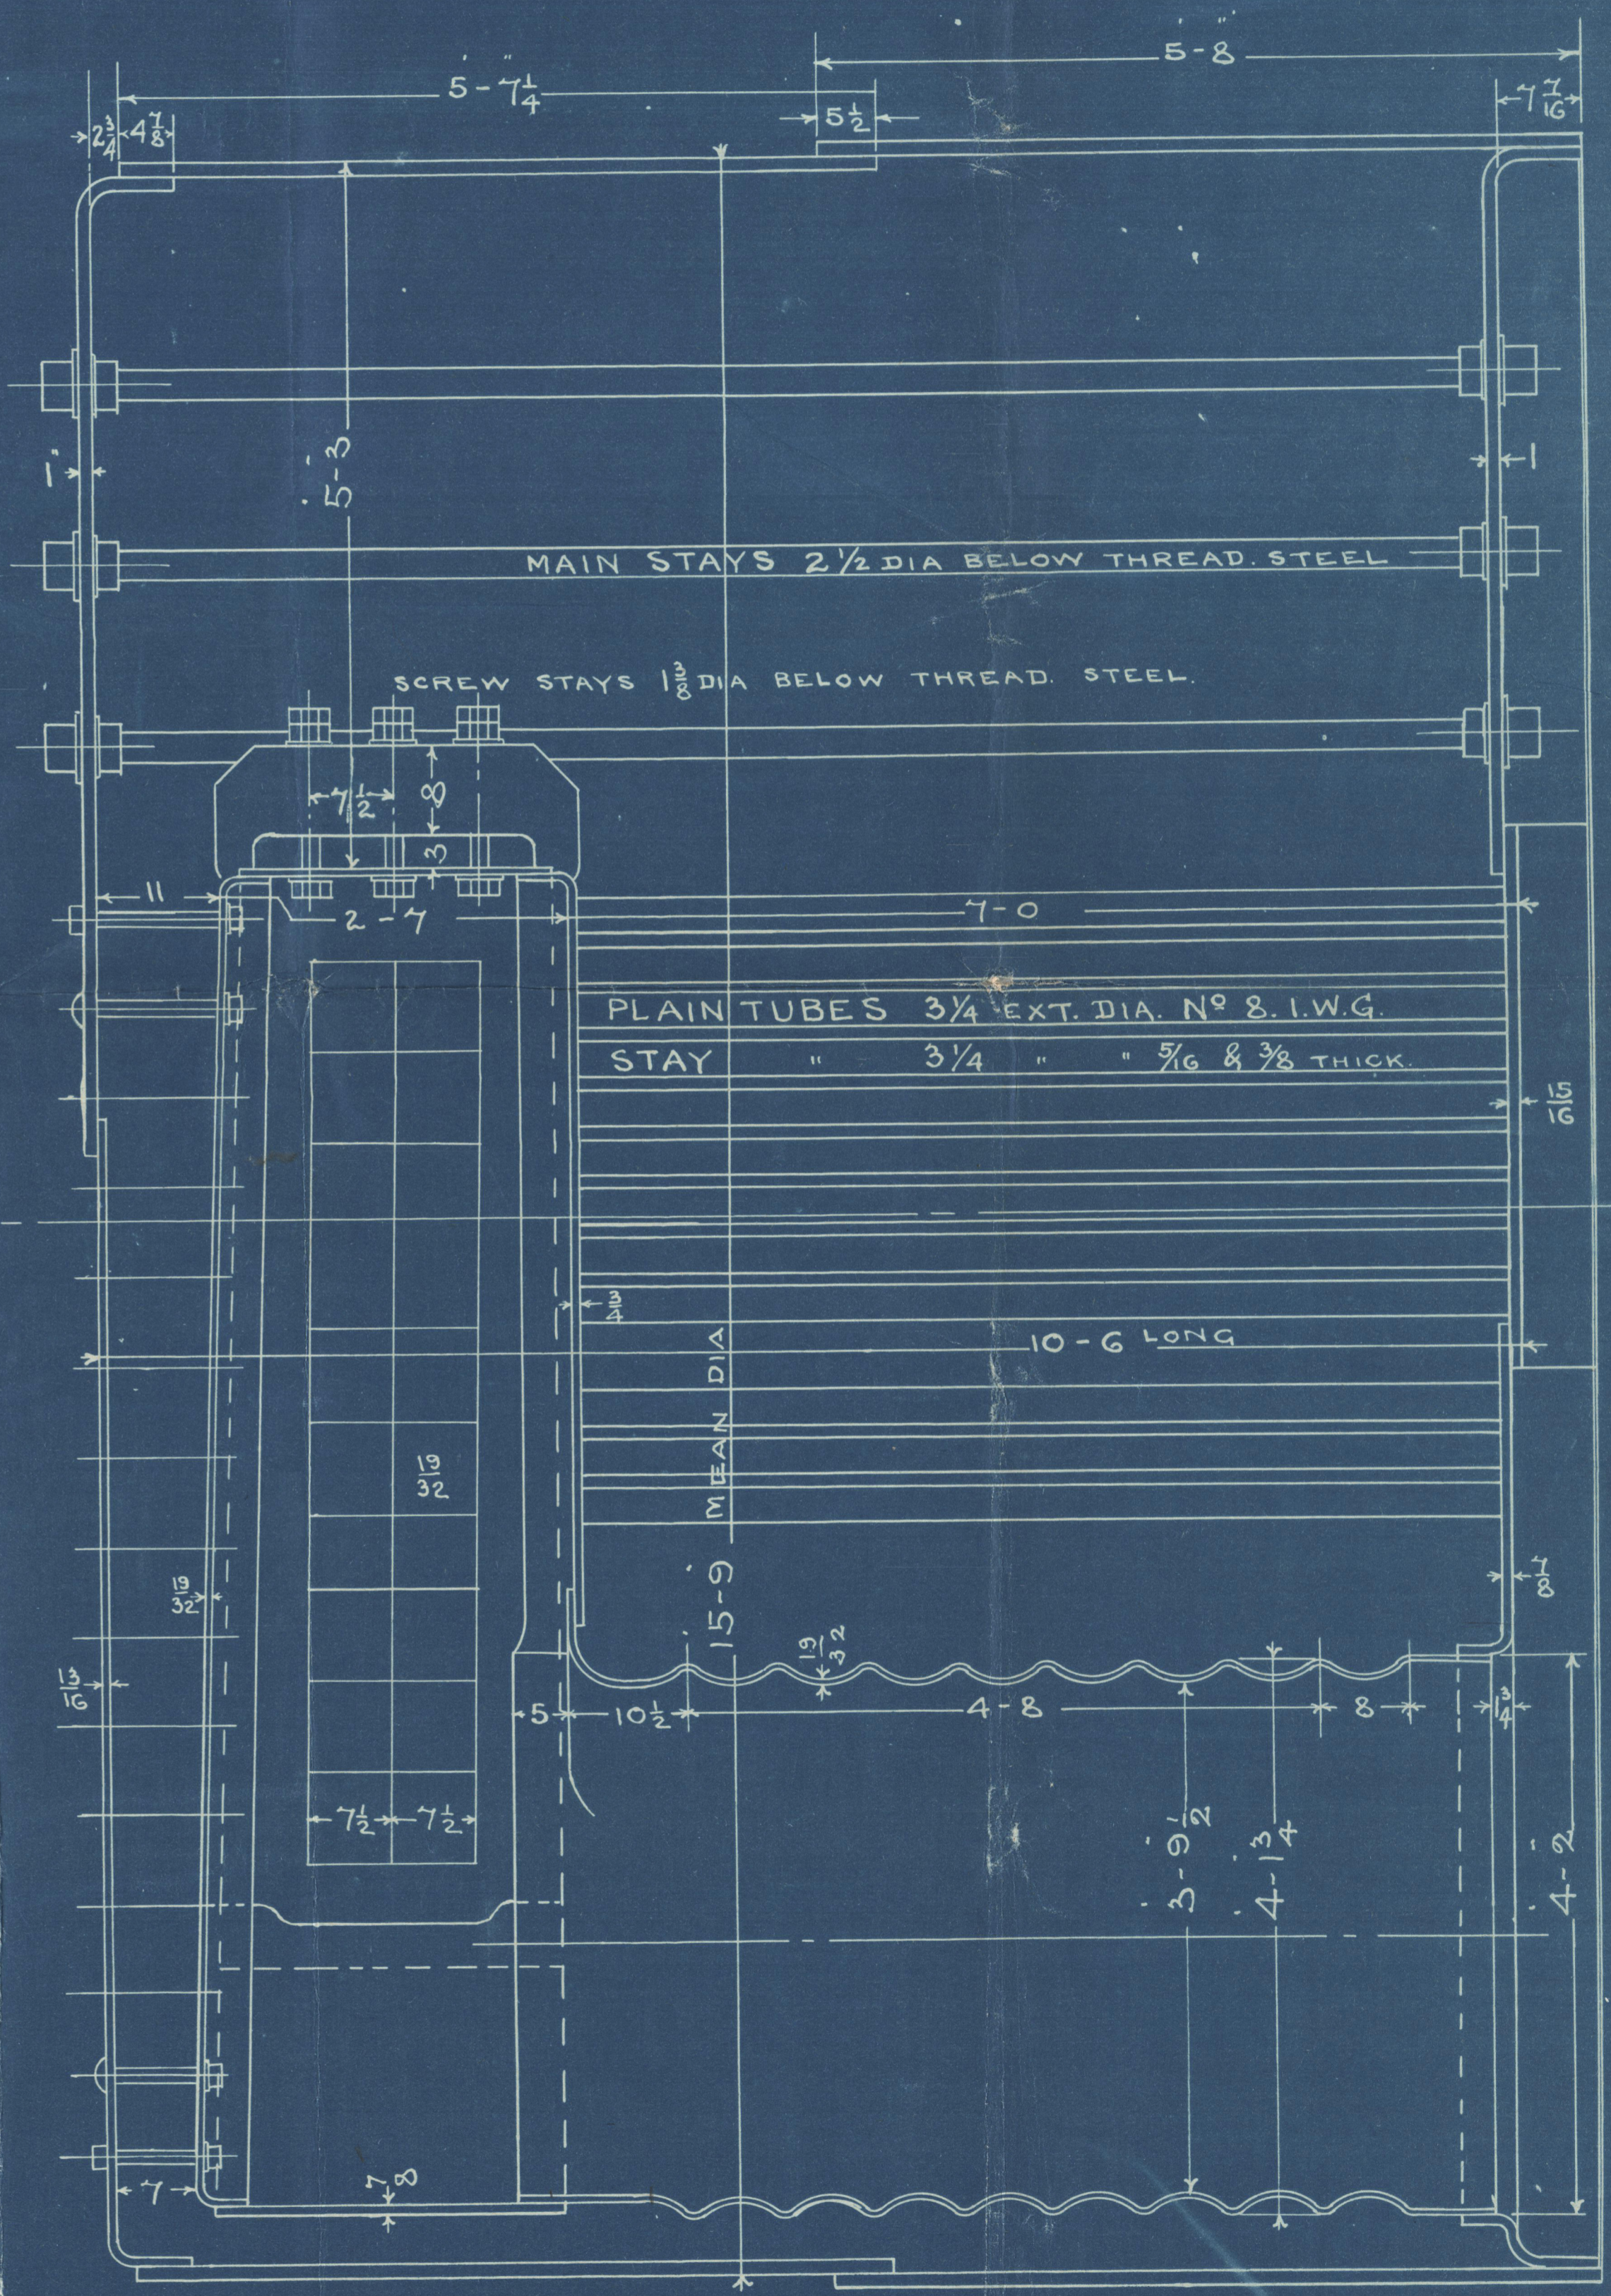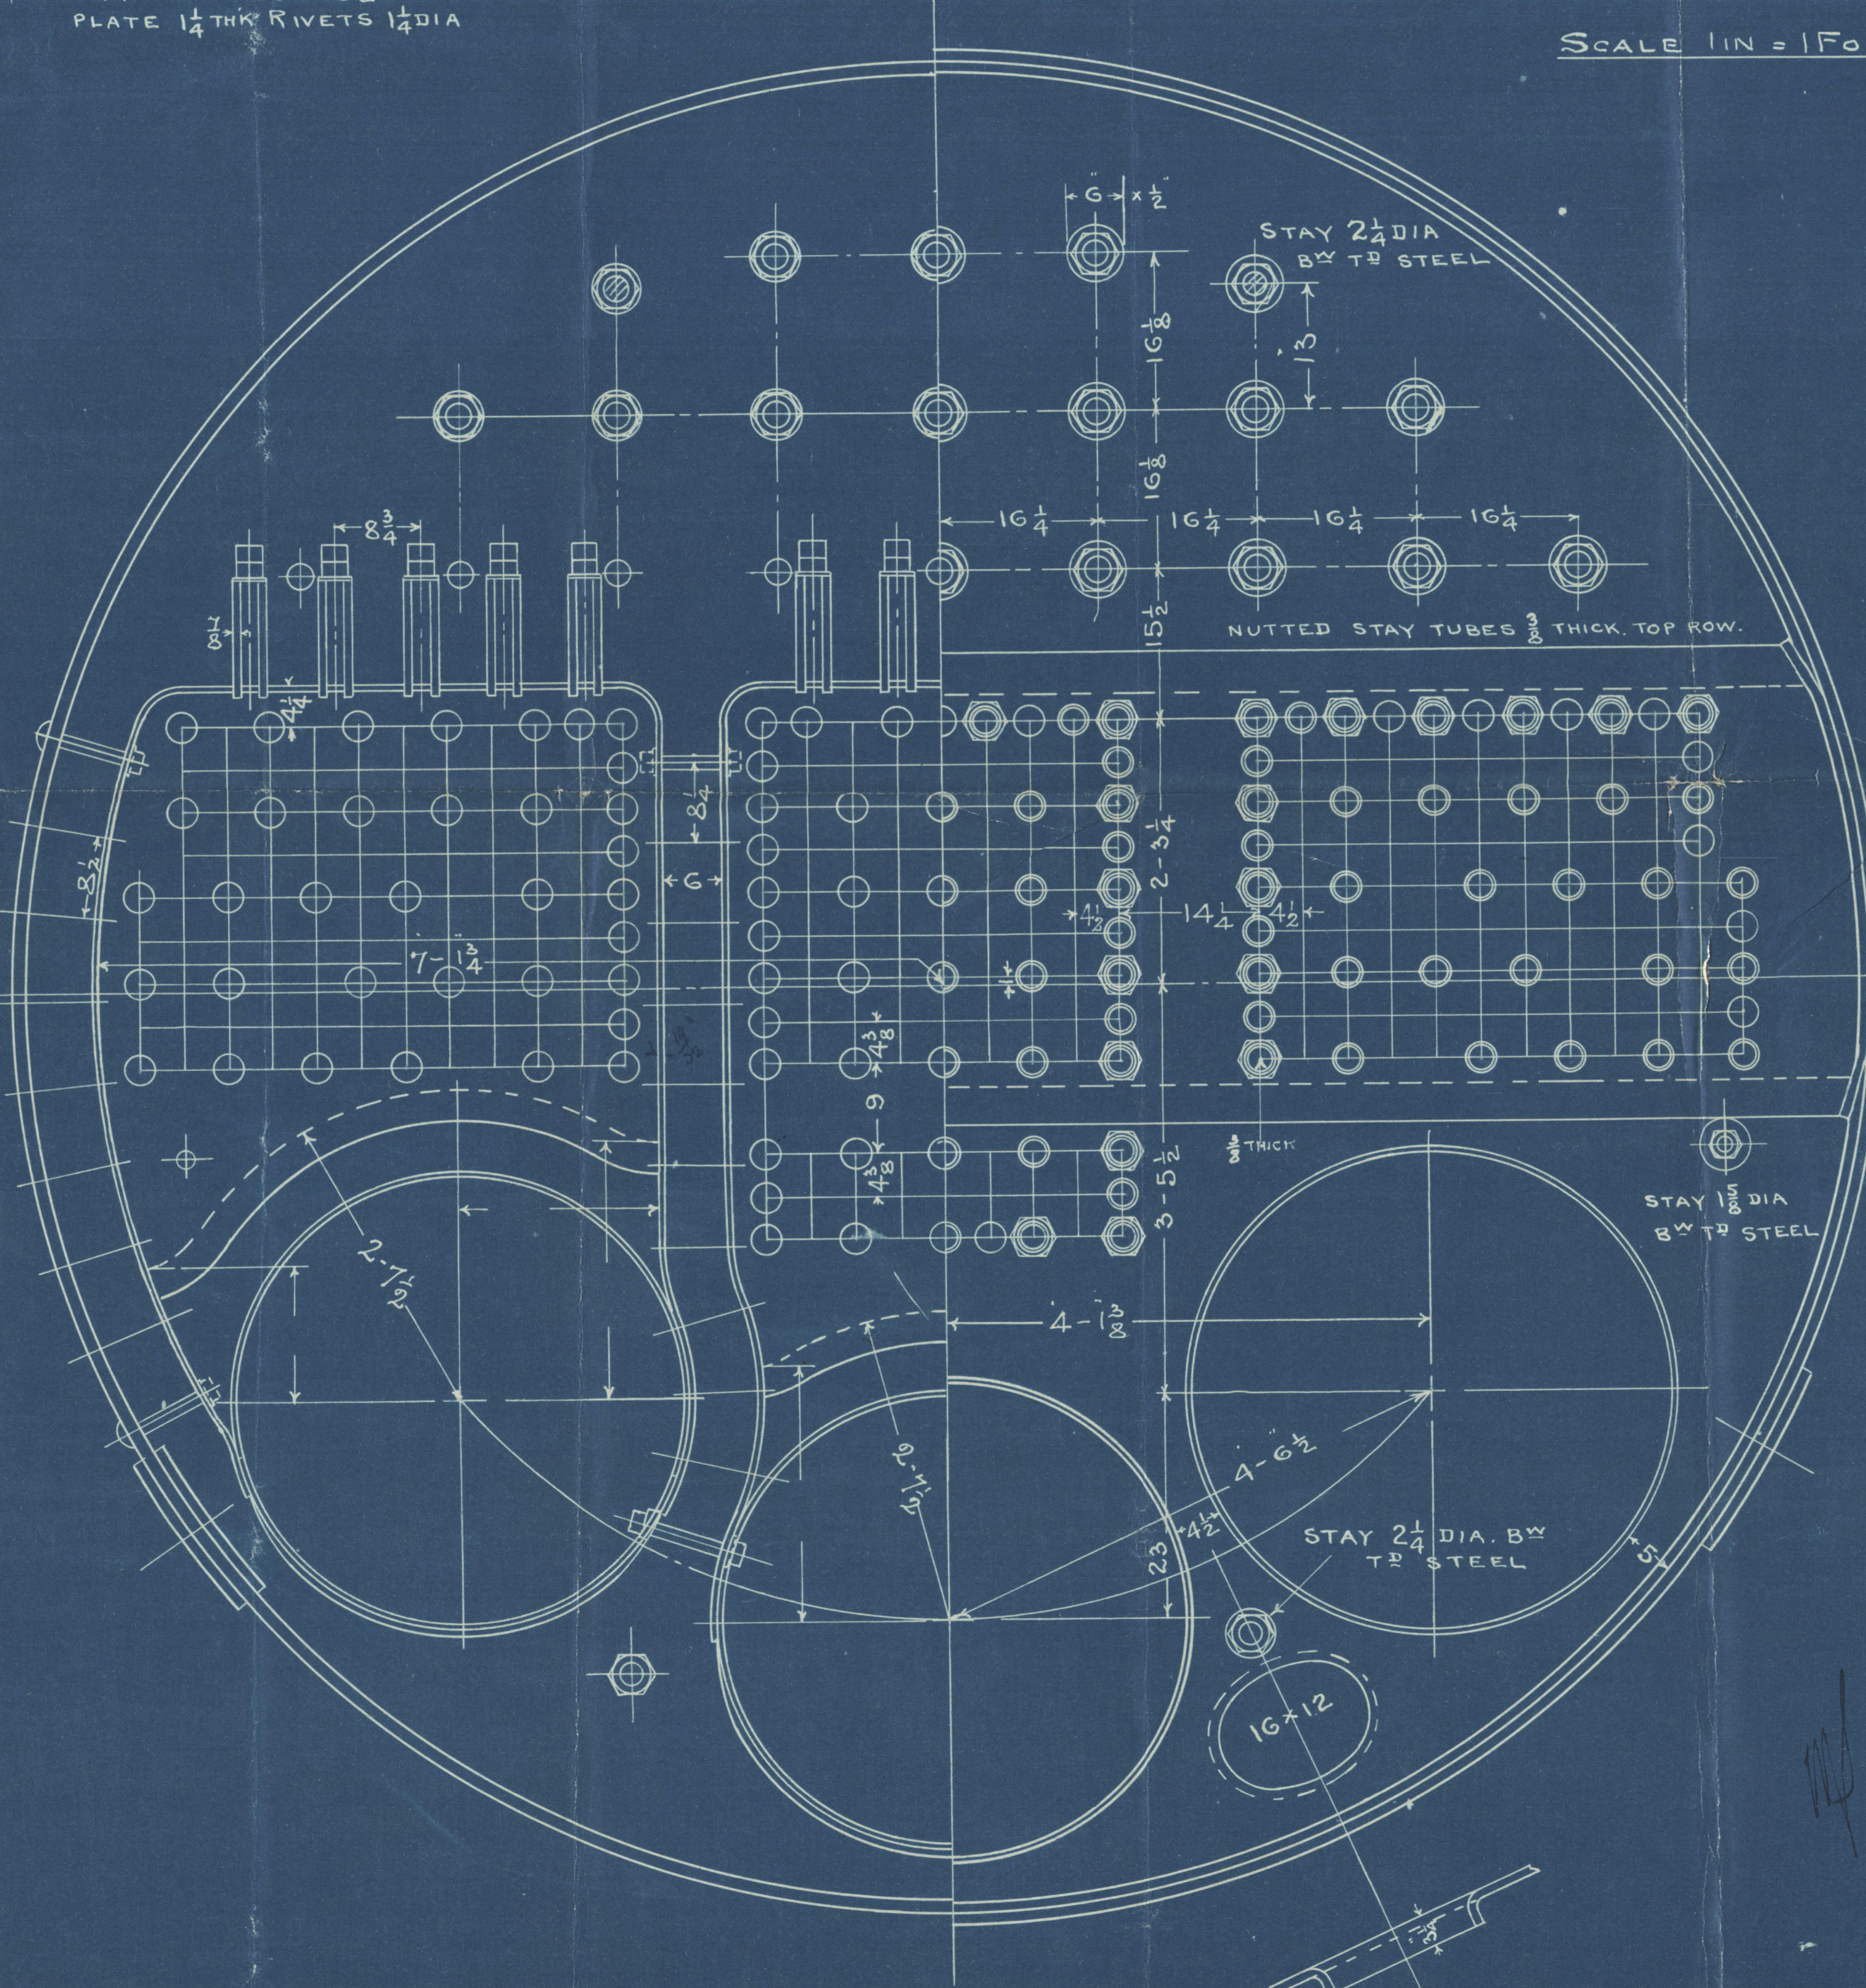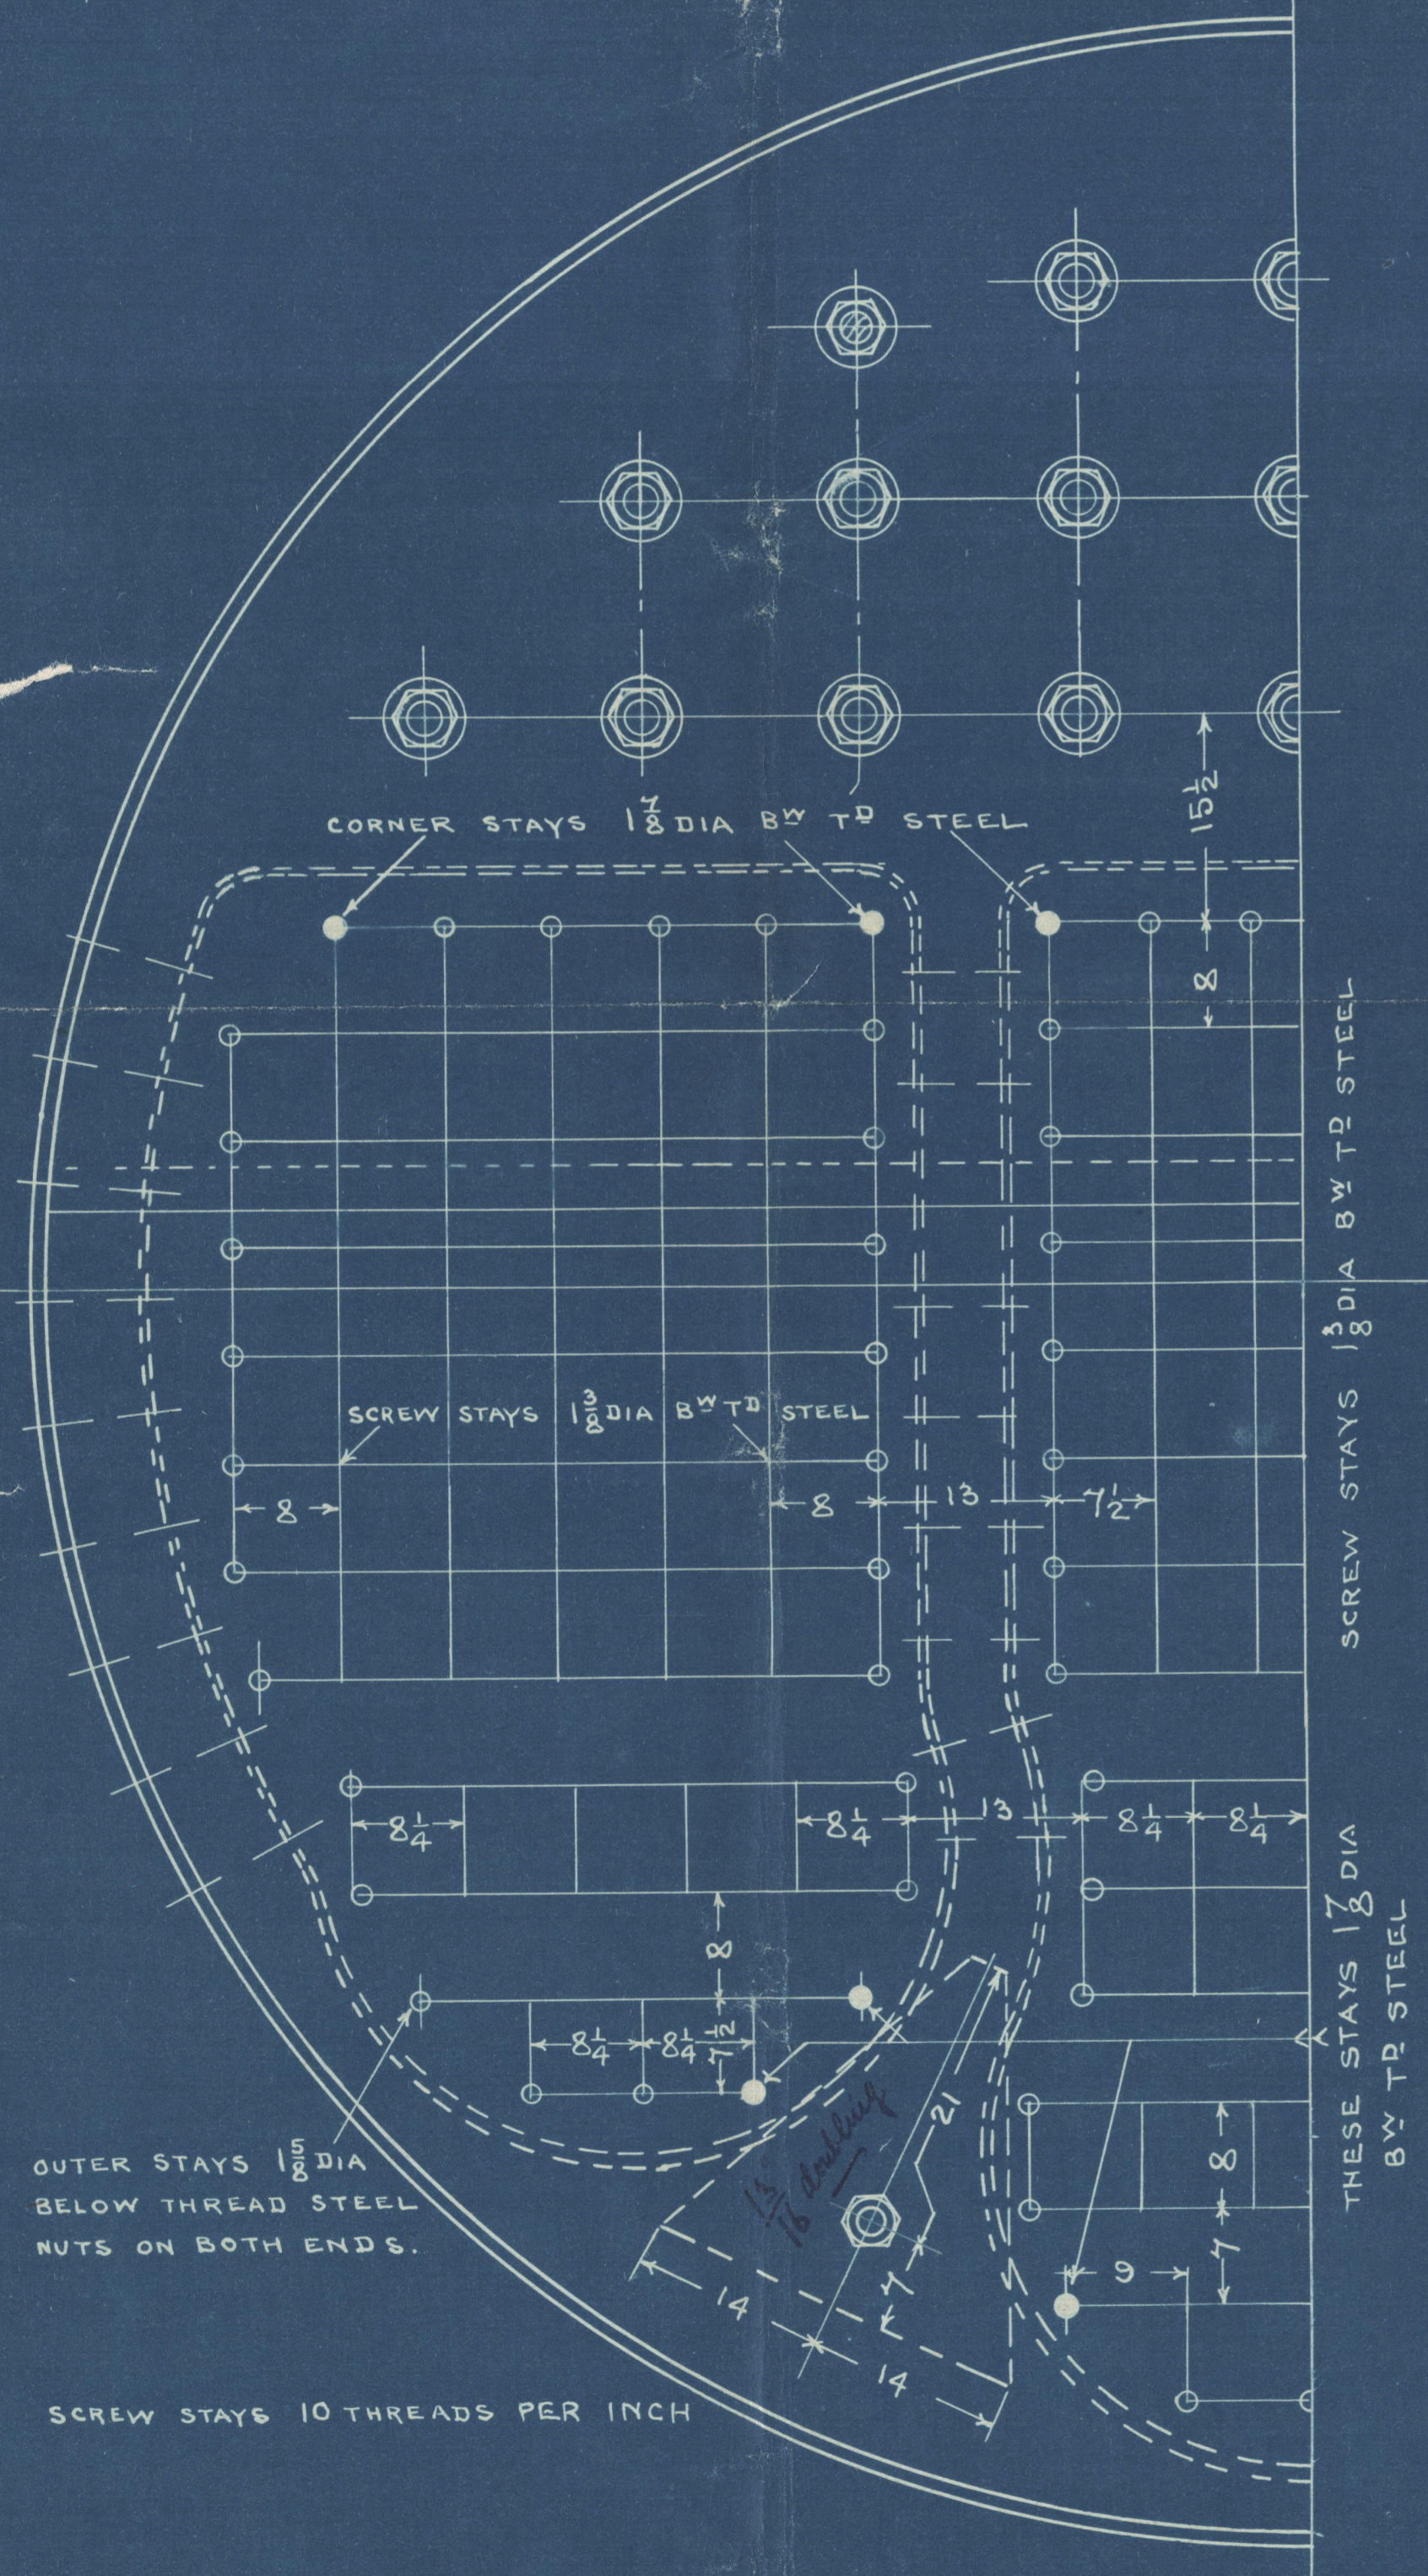

RICHARDSONS, WESTGARTH & CO. LIMITED, HARTLEPOOL.	
NO. OF DRAWING - -	B 1198
NO. OF TRADING - -	21138
WHERE SENT - -	Lloyds
EXAMINED BY - -	W. H. B.
DATE - - - -	23 <sup>rd</sup> Dec. 1904

**BOILERS N° 1198**

28.12.04  
25.12.04  
R

Main Boilers

P. Stephenson & Co




No. 90 Vessel

Richardson Besant & Co  
(Hartlepool)

No. 1198 N.P. 1856

"Seesbridge"

Spec. Rpt. No. 12677.  
New Report No. 19241.

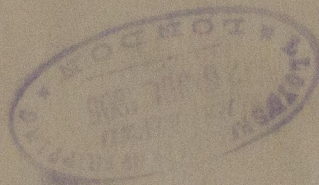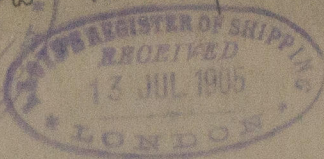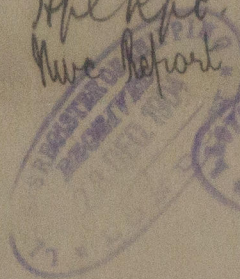

W621-0047



© 2020

Lloyd's Register  
Foundation