
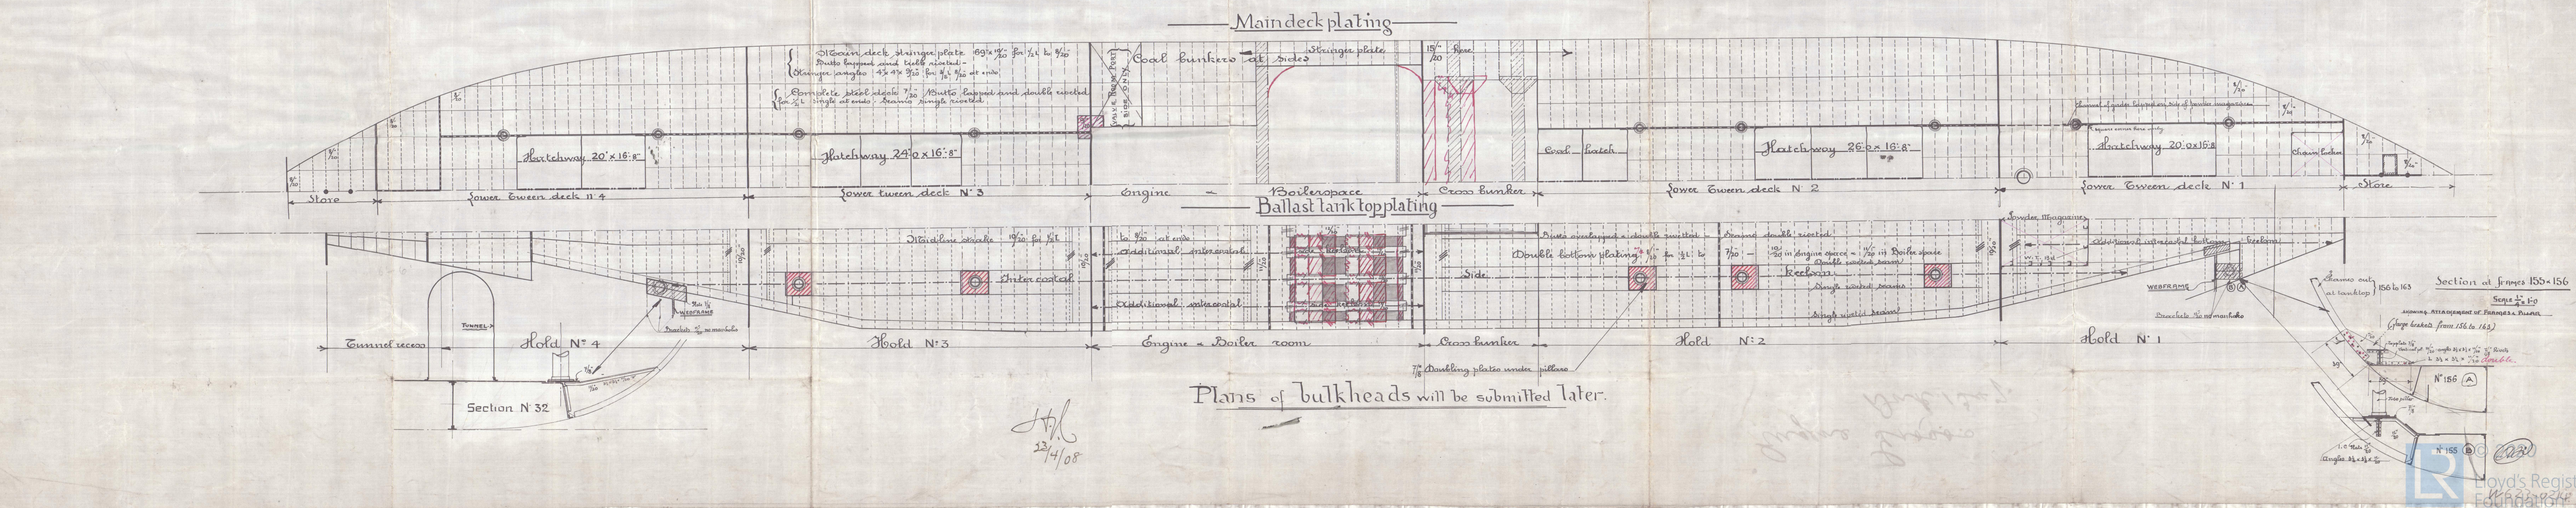
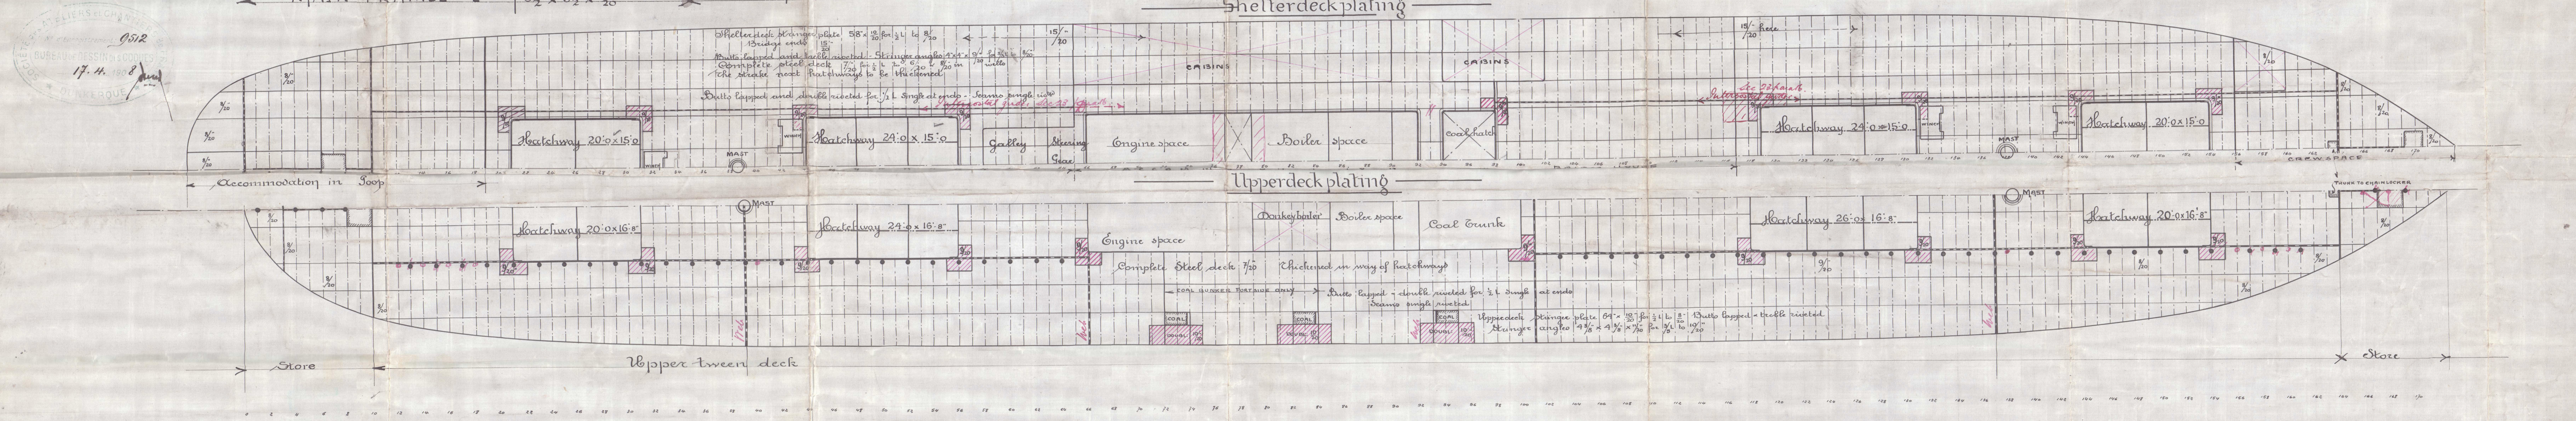


DESSIN N° 4344


-N° 56-

LONGITUDINAL SECTION

SCALE 1/100

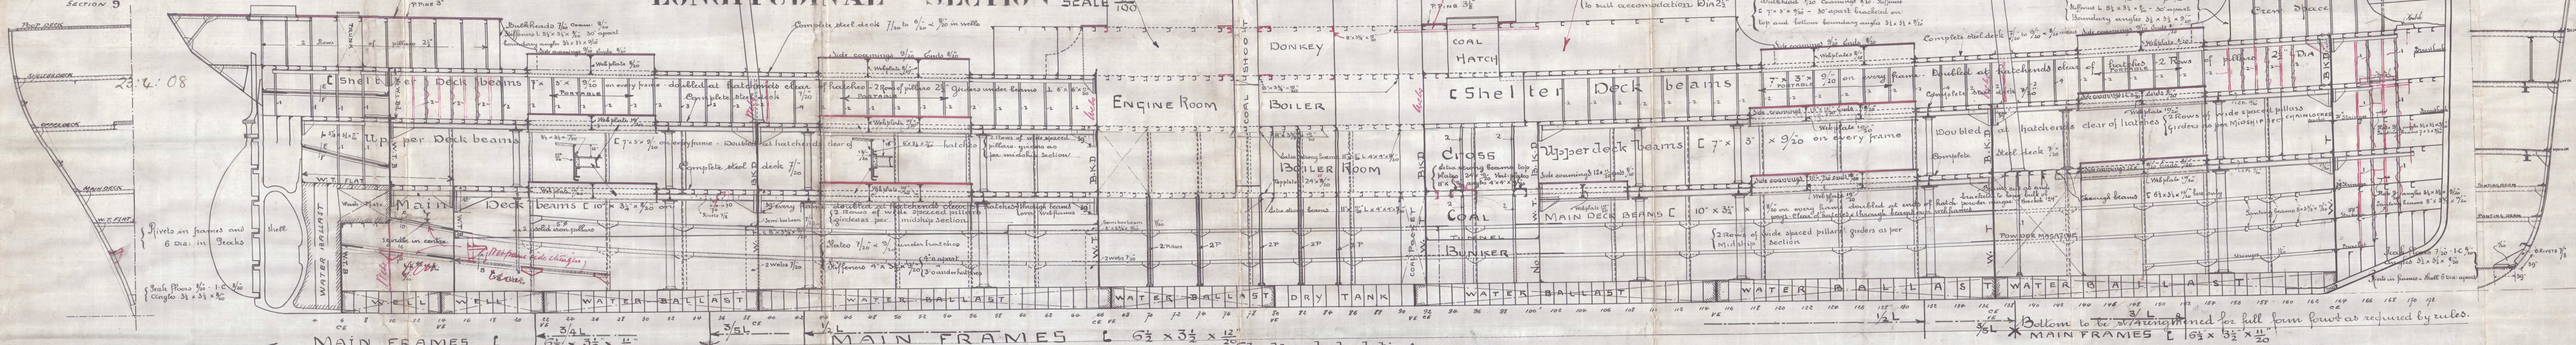

Plans of bulkheads will be submitted later.

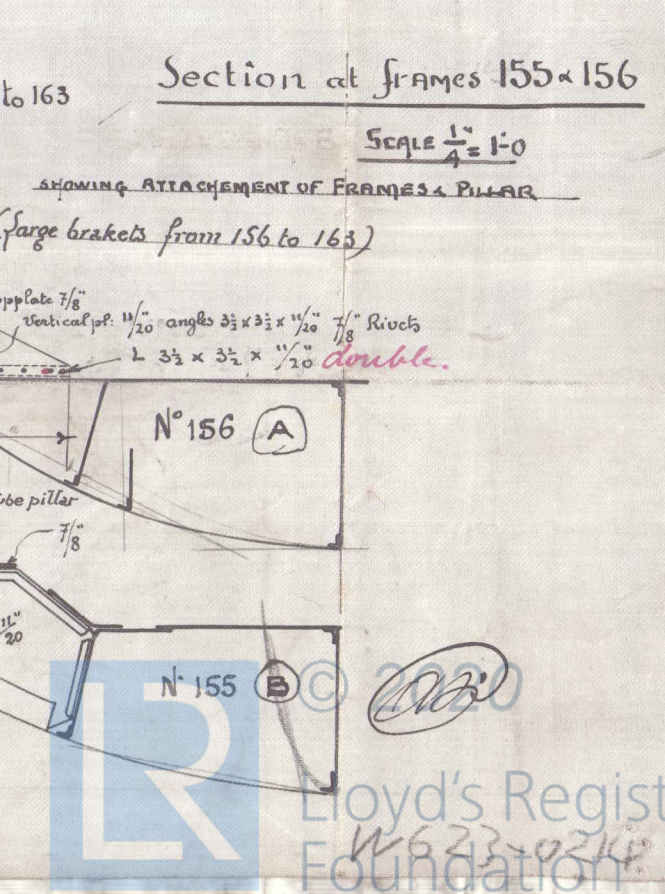

Eugene Gross
Dnk 1347.


W623-0214



© 2020

Lloyd's Register
Foundation

Longitude

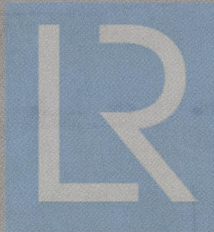

© 2020

Lloyd's Register
Foundation

W623:0244