



28.7.13


# MIDSHIP SECTION STEEL SCREW TRAWLER

## N° 578

DIMS 135'0" BP x 23'6" EX x 13'6" MLD  
SCALE 1/2 INCH

TO CLASS 100A1 STEAM TRAWLER  
DECK PLATED OVER IN WAY OF MACHINERY  
E & B CASING AS PREVIOUSLY APPROVED

PLAN No. 3178  
FOR ENCLOSURE TO  
*Messrs. Lloyd's Register of Shipping*  
FROM  
COCHRANE & SONS, LTD.  
SHIPBUILDERS, SELBY.  
Dated 24/7/13. *JSW*

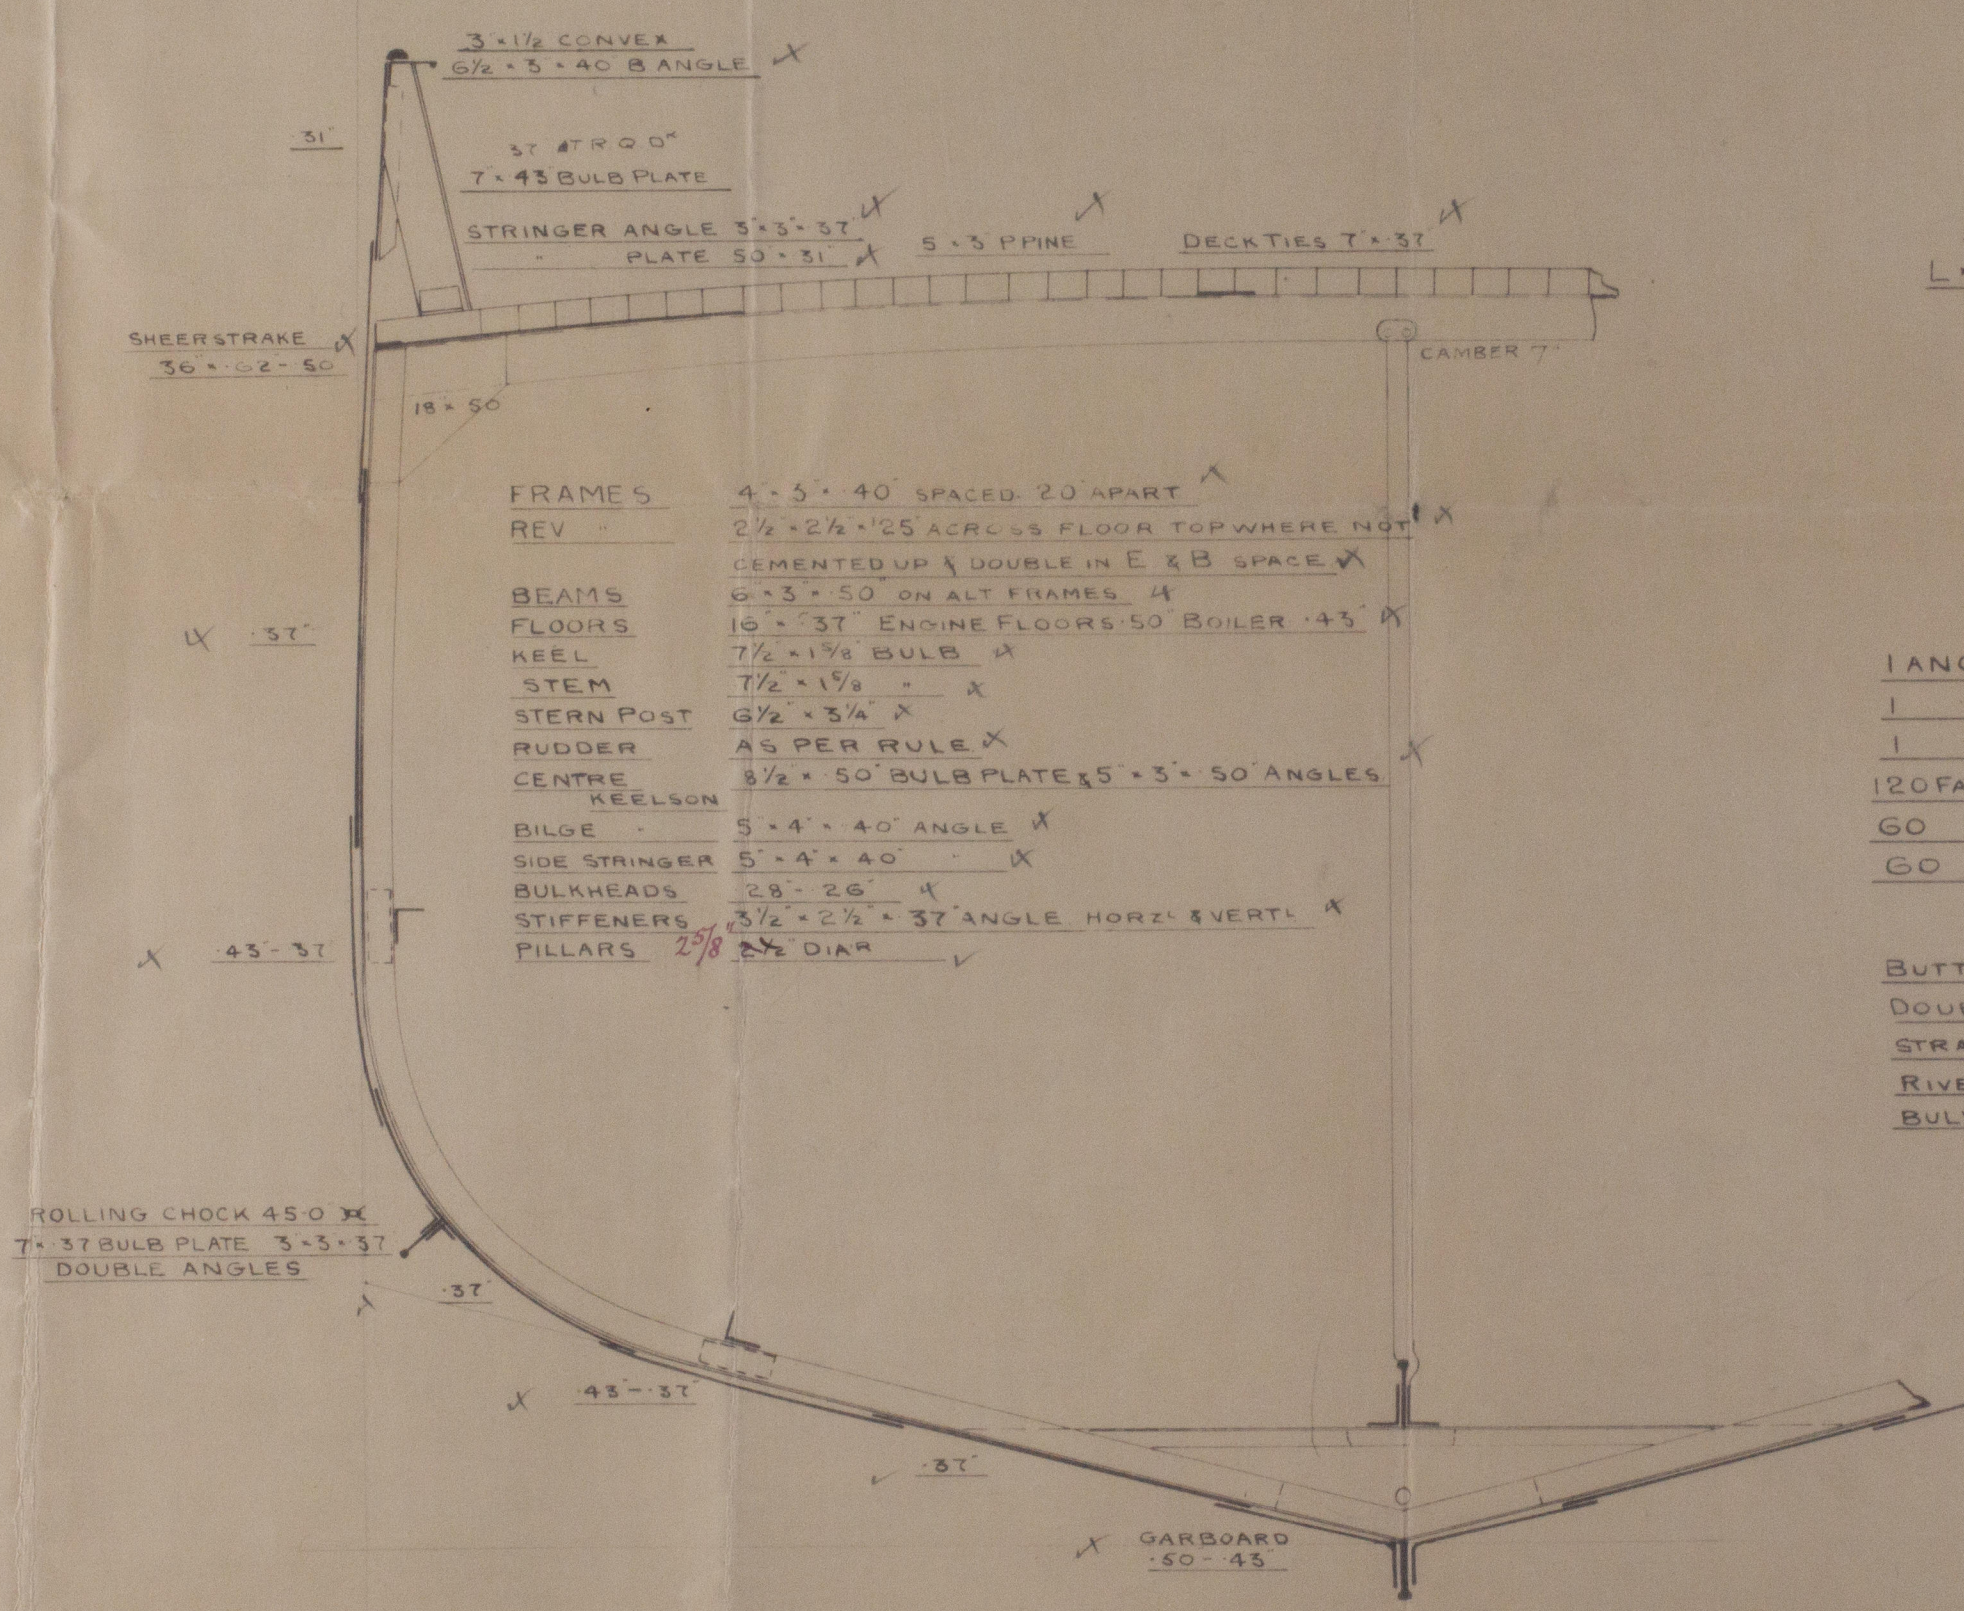

### NUMERALS

B+D --- 36.87  
L x (B+D) --- 4977.45

### PROPORTIONS

L --- 10.00  
B --- 5.78

### EQUIPMENT

1 ANCHOR	6 CWTs EX STOCK	X
1	5 1/2	X
1	3	X
120 FATHOMS	1 1/2" STUD LINK CABLE	X
60	6" HAWSER	X
60	5" WARP	X

### RIVETING

BUTTS OF SHELL PLATING OVERLAPPED & DOUBLE RIVETED, EXCEPT GARBOARD & SHEER STRAKE WHICH ARE TO BE STRAPPED & DOUBLE RIVETED. LANDINGS DOUBLE RIVETED. BULWARKS STRAPPED & SINGLE RIVETED

*JSW*  
28.7.13



COCHRANE & SONS



Nº 578

MIDSHIP SECTION




*Hoffa*

*Hull Dept No: 27041.*

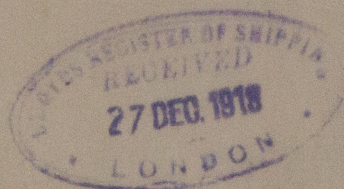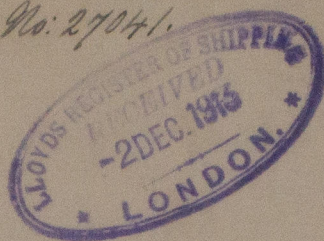

W  
H  
U  
L  
L  
N  
O  
T  
E

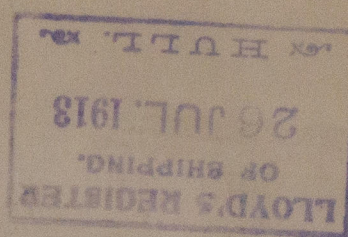

W625 - 0053.1



© 2021

Lloyd's Register  
Foundation