



— Scale $\frac{1}{8}$ " = 1 Foot. —

1850
 1851
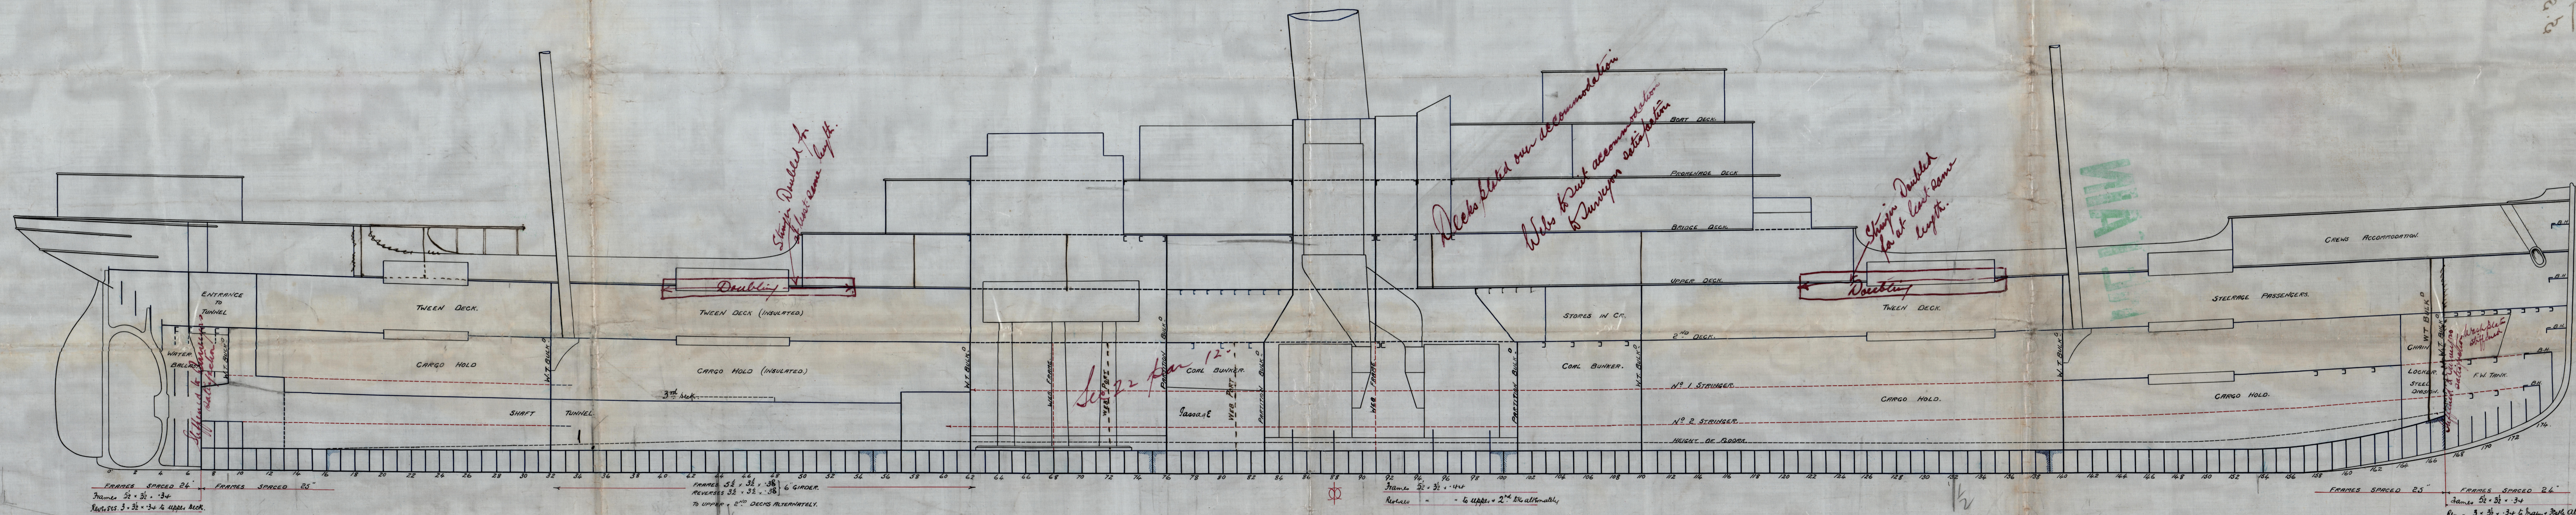

Detail Deck plans & in submitted

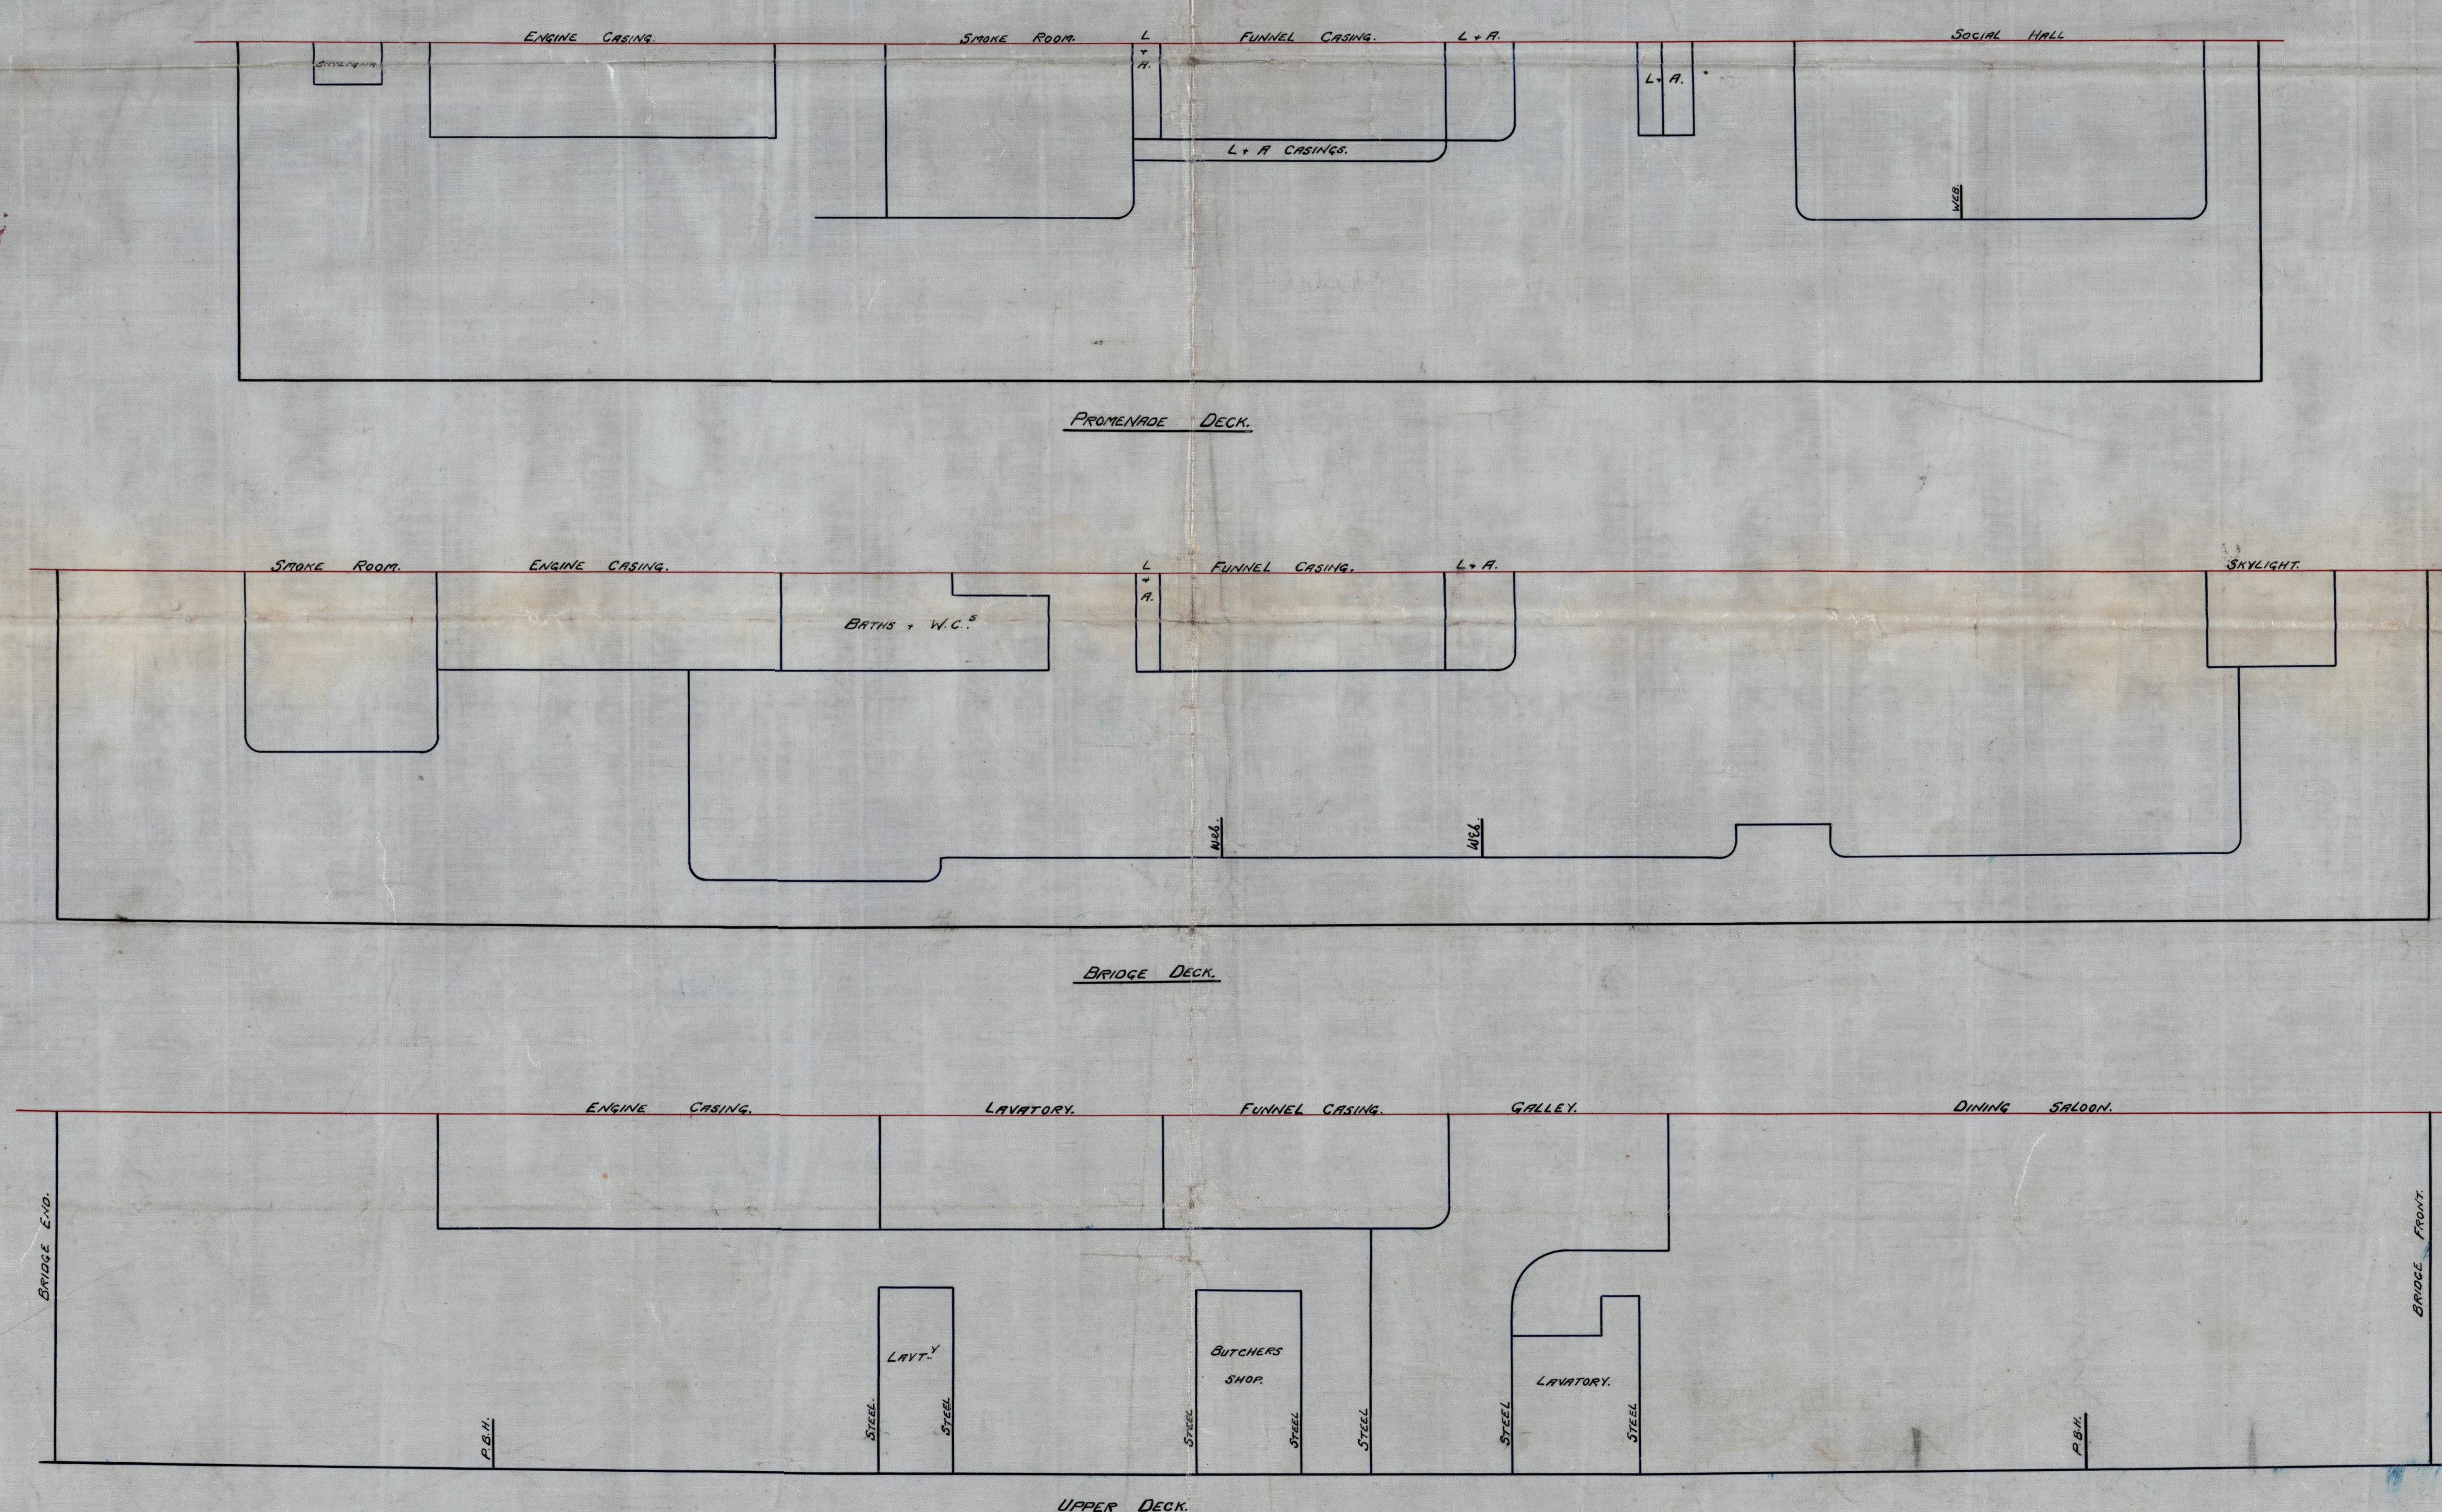

C. 7.
11/11/09.



Warkman Clark & Co. Ltd

Proposed, St. 36 y ft.

Nº 292

Profile + Deck Plans (outline)

S.S. "ST ALBANS"

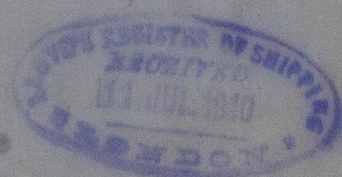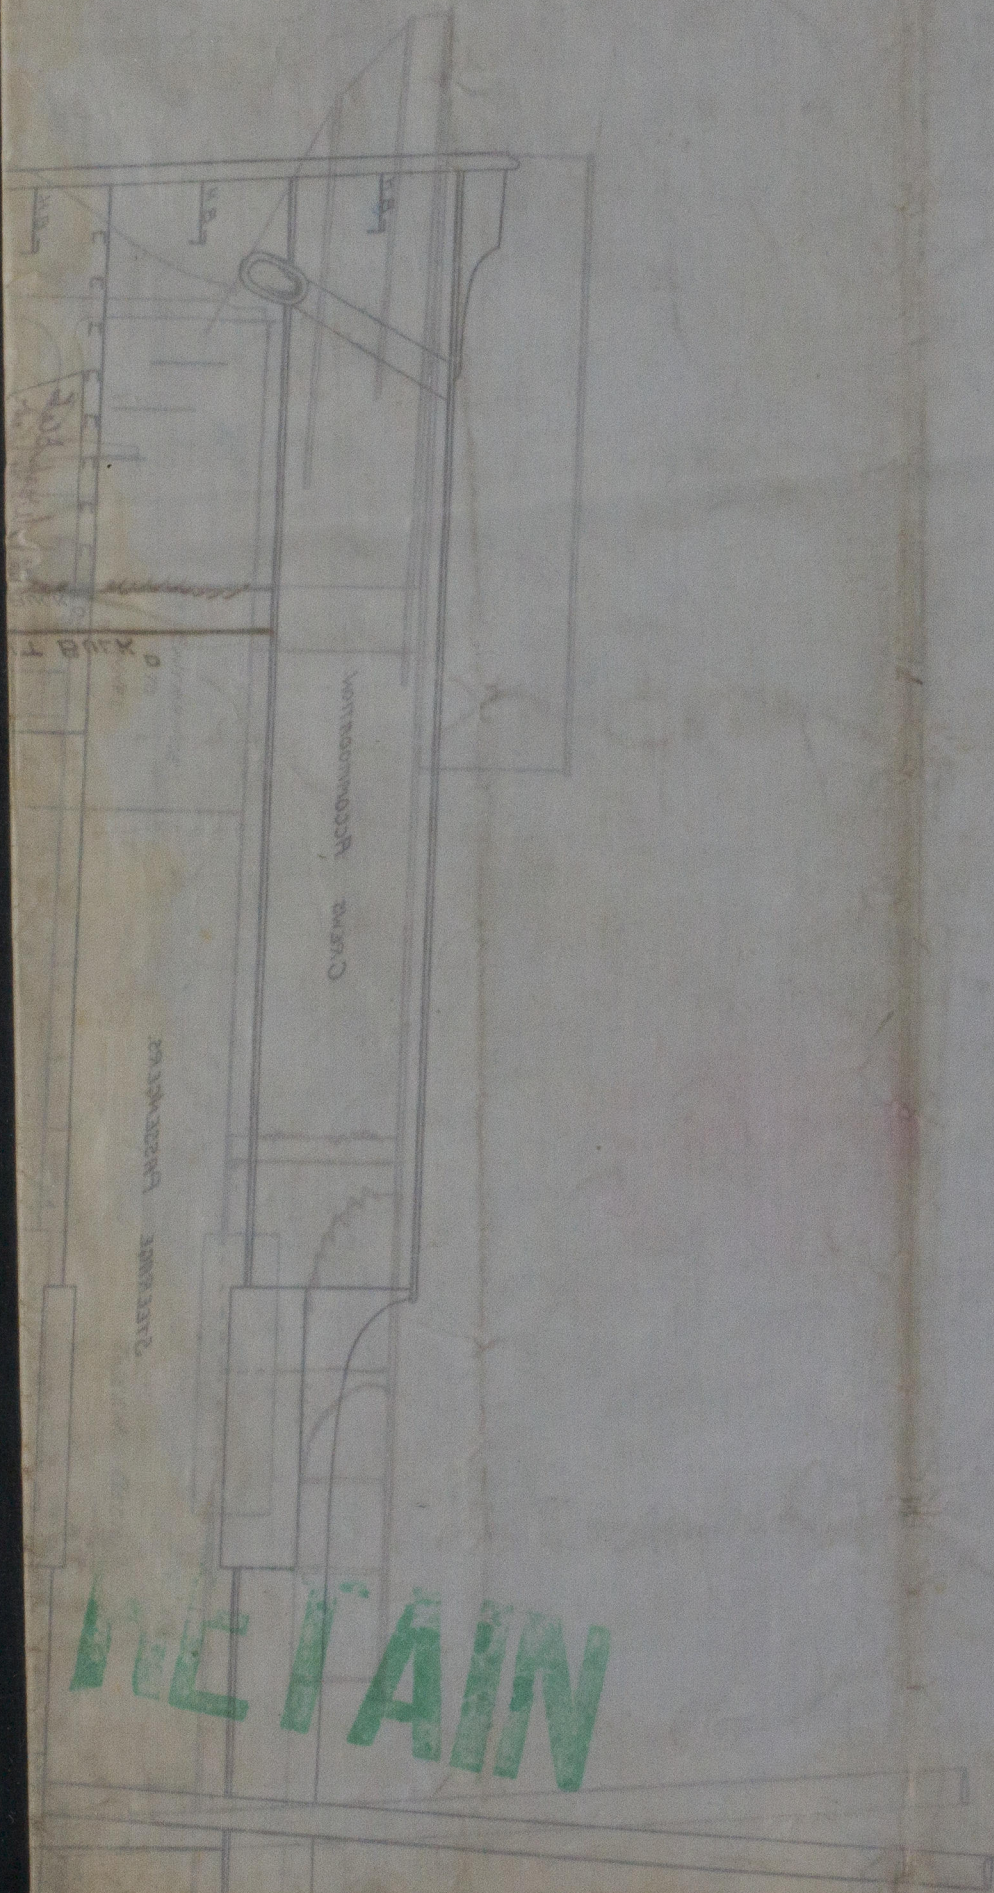

RETAIN



© 2021

Lloyd's Register
W025 Foundation