


W63-0070

Cilus Nos 1 + 2

St. Michael's

Fly to arrangement. Bulrheads

Web at 29 Bulrhead

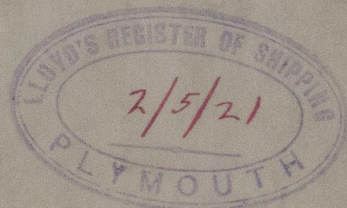


R. L. A. Oleander

Cardiff Report

No. 43,660.

Plymouth
2/5/21.

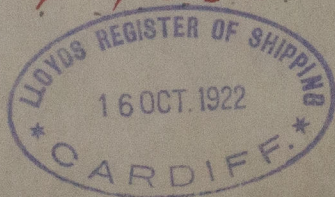

© 2020

Lloyd's Register
Foundation

60954.

OILERS. Nos 1 & 2