


W63 - 0071

Arrangement of 2nd Deck
- Plating -

Consequent upon rearrangement of
hoisted space

Oilers Nos 1 & 2

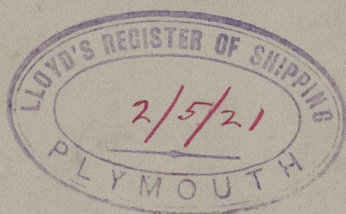

R. F. A. Olander.

Cardiff Report

No. 43660

Plymouth



© 2020




DEVONPORT
M. O. D. 60952
DATE 13/9/80

"OILERS" Nos 1 & 2

PLAN ARRANGEMENT OF 2ND DECK PLATING. (CONSEQUENT ON REARRANGEMENT OF BOILER ROOM)

PREPARED IN ACCORDANCE WITH D/52/4/20 28.5.20 (8866)


SCALE 1/4" = ONE FOOT

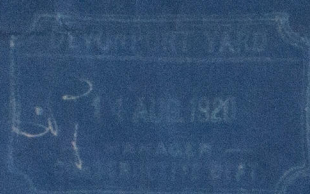

RED

COPIES WITH
LLOYD'S LETTER
28.5.20

Eng's Survey
28.5.20

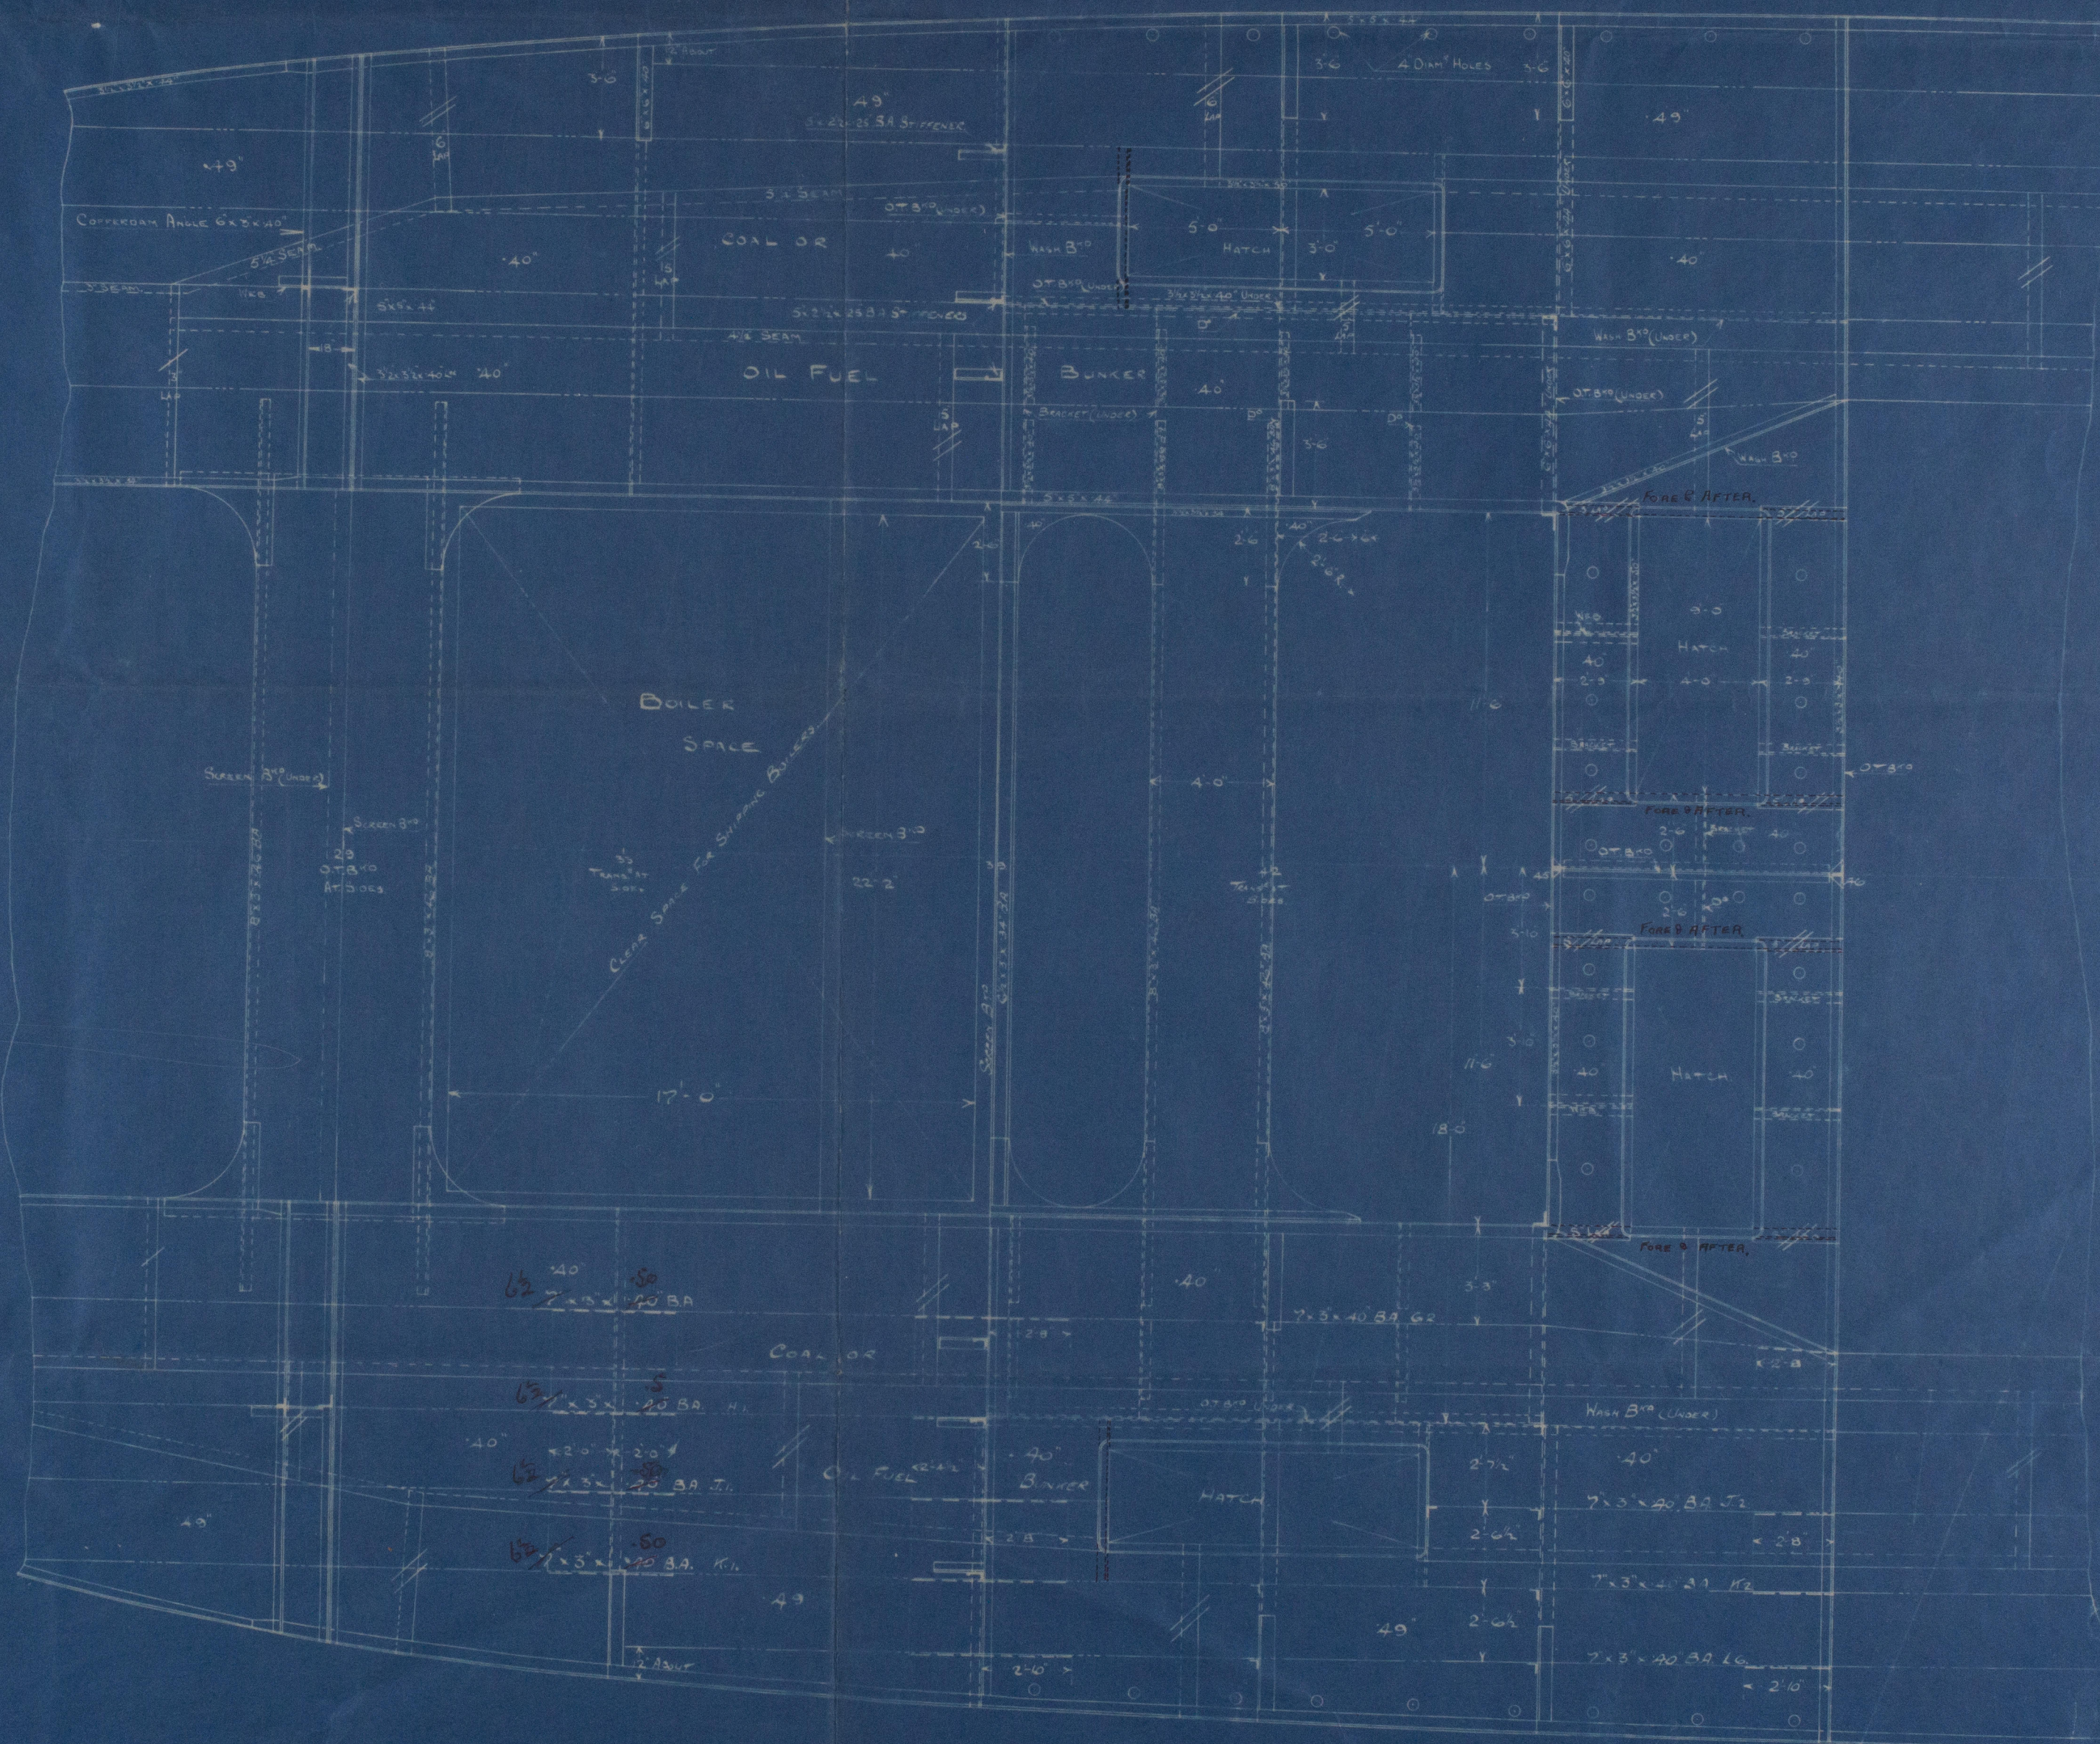

Rep James
Rep.



Lloyd's Register
Foundation

W63-0011