


W63-0072

Cilios nos 1+2

Nos 42 + 45 Transverse Frames

Consequent on rearrangement
of Boiler Rooms

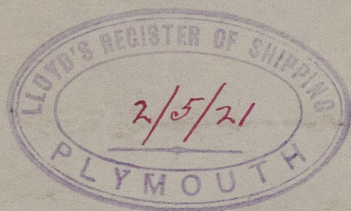


R. F. A. Olander

Cardiff Report

No. 43.660

J. Plymouth
2/6/21.

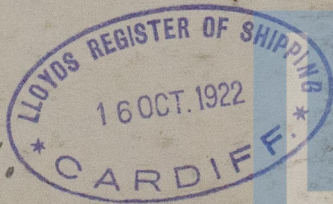

© 2020

Lloyd's Register
Foundation

prints to Lloyd's Survey
 2 " " " " Sites
 1 " " " " Bishop

"OILERS" 1 & 2.

Nos 42 & 45 TRANSVERSE FRAMES. (CONSEQUENT ON REARRANGEMENT OF BOILER ROOM.)

PREPARED IN ACCORDANCE WITH D.15214/20. 28.5.20 (8866)



SCALE 1/4" = 1 FOOT.

DEVONPORT
 M. O. D. 60942
 DATE 31.7.20.

DEVONPORT YARD
 31 JUL 1921
 MANAGER
 CONSTRUCTION STY.

MODIFIED IN RED
 TO ACCORDANCE WITH
 LLOYD'S LETTER
 DATED 14.8.20
 L.N.

APPROVED
 LLOYD'S SURVEY
 14.8.20

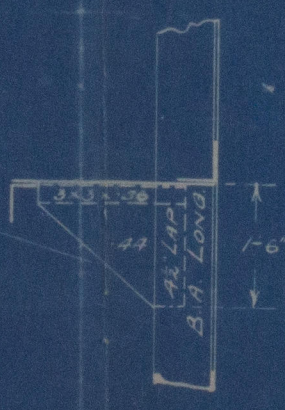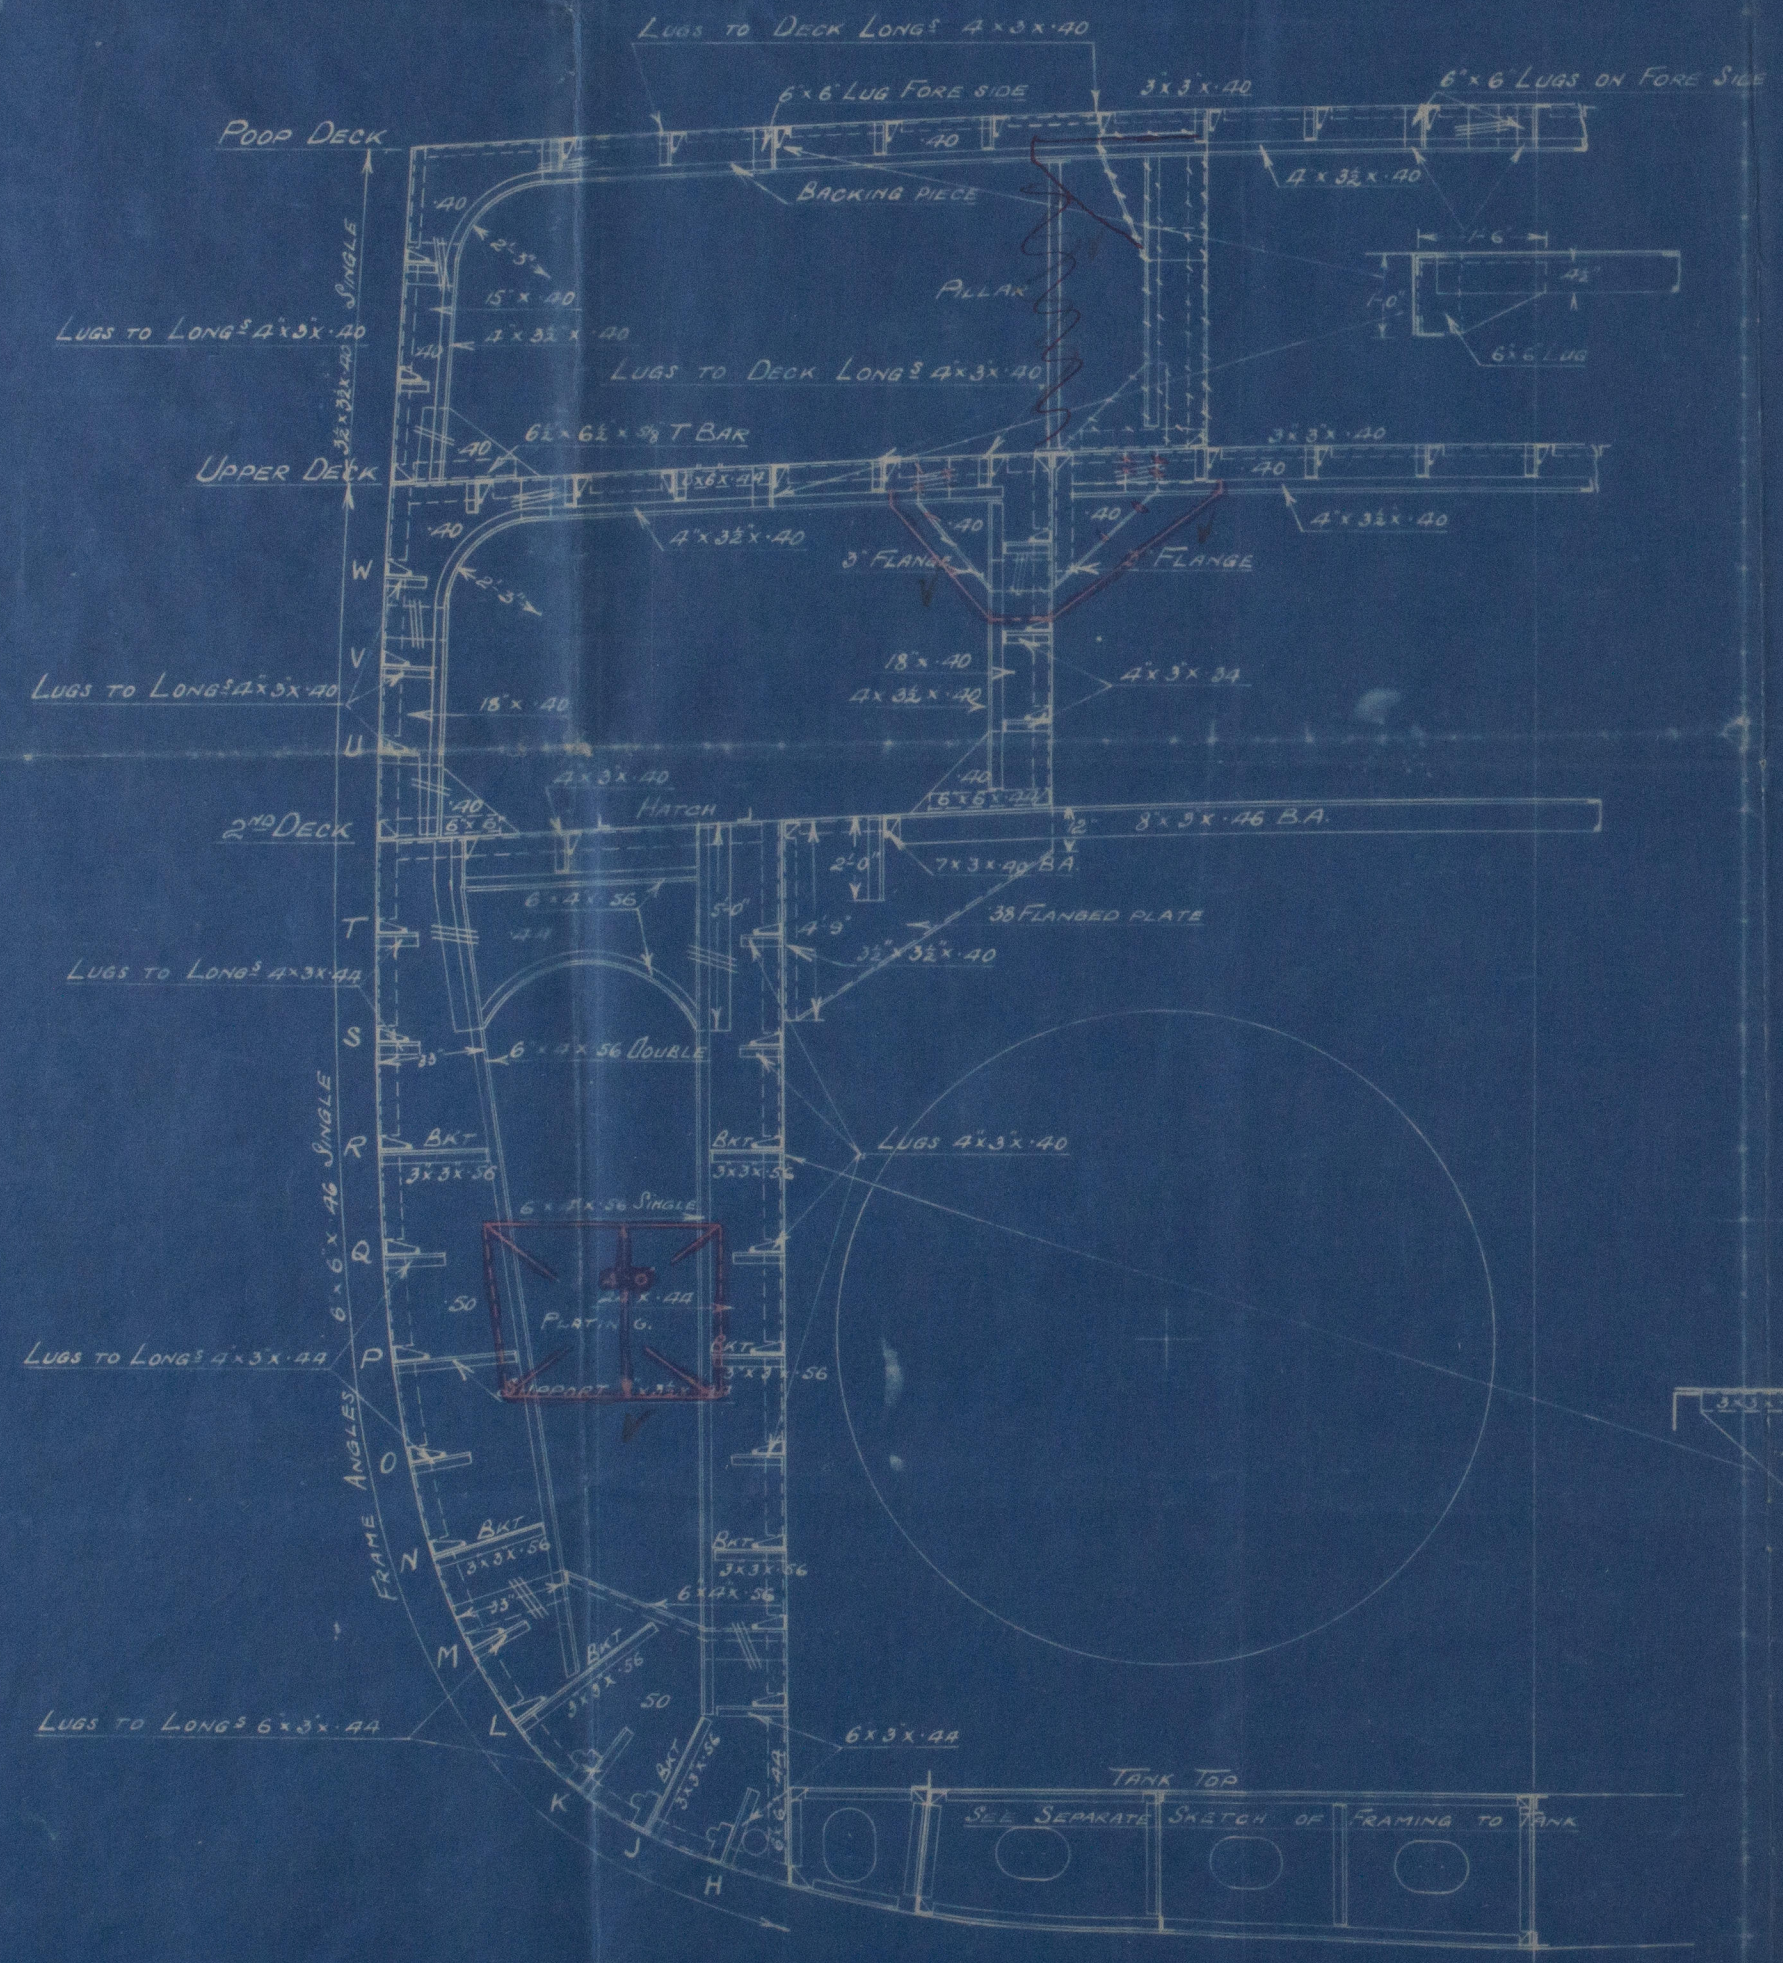

Nº 45 TRANSVERSE FRAME. LOOKING FORWARD.



W63-0072

