

R.F.A. OLEANDER.

PROPOSED ARR^{GT} OF BUTTS TO NEW PLATING ON 2ND DECK.

SCALE $\frac{1}{4}" = 1 \text{ FOOT}$.

& as modified in led

30.3.21

UPPER DECK

 $5 \times 5 \times .50$


NEW PLATING

Lloyd's Register
Foundation
WG3 - 0076

R. F. A. Oleander

Modification of connection
of trunk side plating to
2nd Deck

Cardiff Report
no 43660.

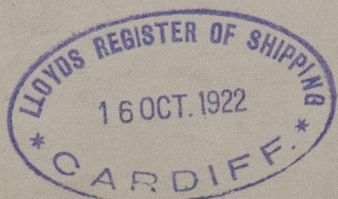

© 2020

Lloyd's Register
Foundation