

For the information of Surveyors and the Committee only.

Received at

office

18

(Report on Vessel No. _____ Port _____)


e to report that the undermentioned Iron or Steel Forgings ~~or~~
manufactured by Robert Kerr & Co
Amie for the Vessel No. 256, being built
Barage Ferguson & of Leith
inspected by me as set forth below and found to be, so far as can
be

Alexander Fletcher

Glasgow. 27/12/1919.

STERN FRAME.	RUDDER FRAME.	STEM.
<p>Scrap Iron</p> <p>Engel</p> <p>9" x 7" x 10" x 5"</p> <p>Engel's Machine</p> <p>8/8/19 526/12/1919</p>		

OF FRAMES SHOWING POSITION AND DESCRIPTION OF WELDS OF FORGINGS.

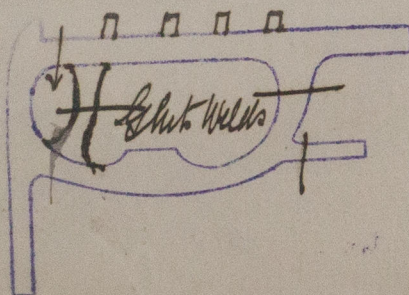

argeable) £NIL (Vessel Classed) weight 7-5 ^{TC} ²⁰²¹
at

Iron, state whether scrap or puddled Iron. If of Steel, state whether made on the Open Hearth process.