
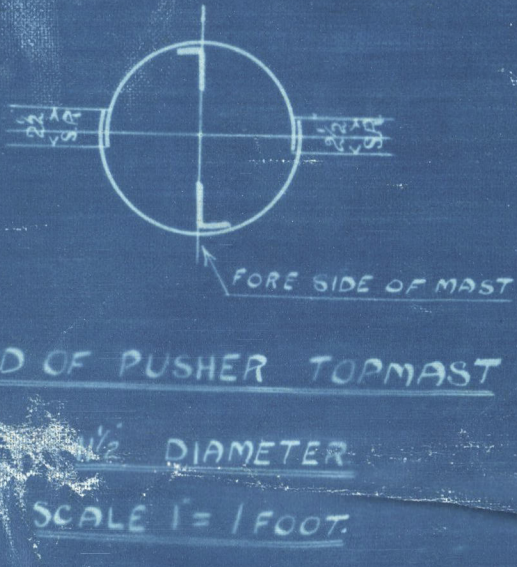
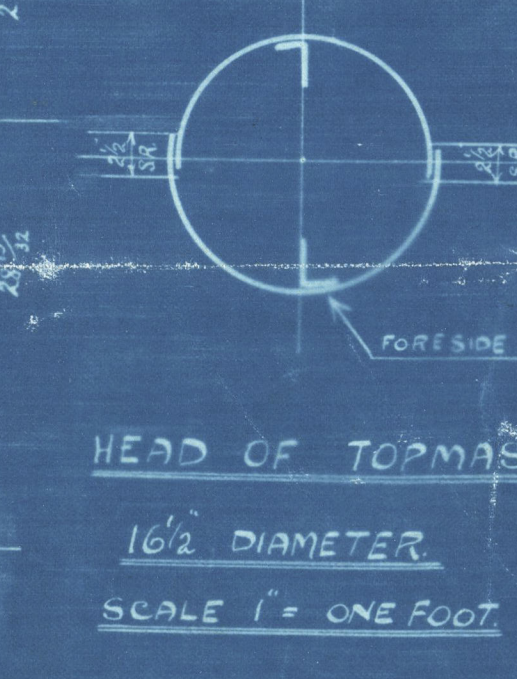
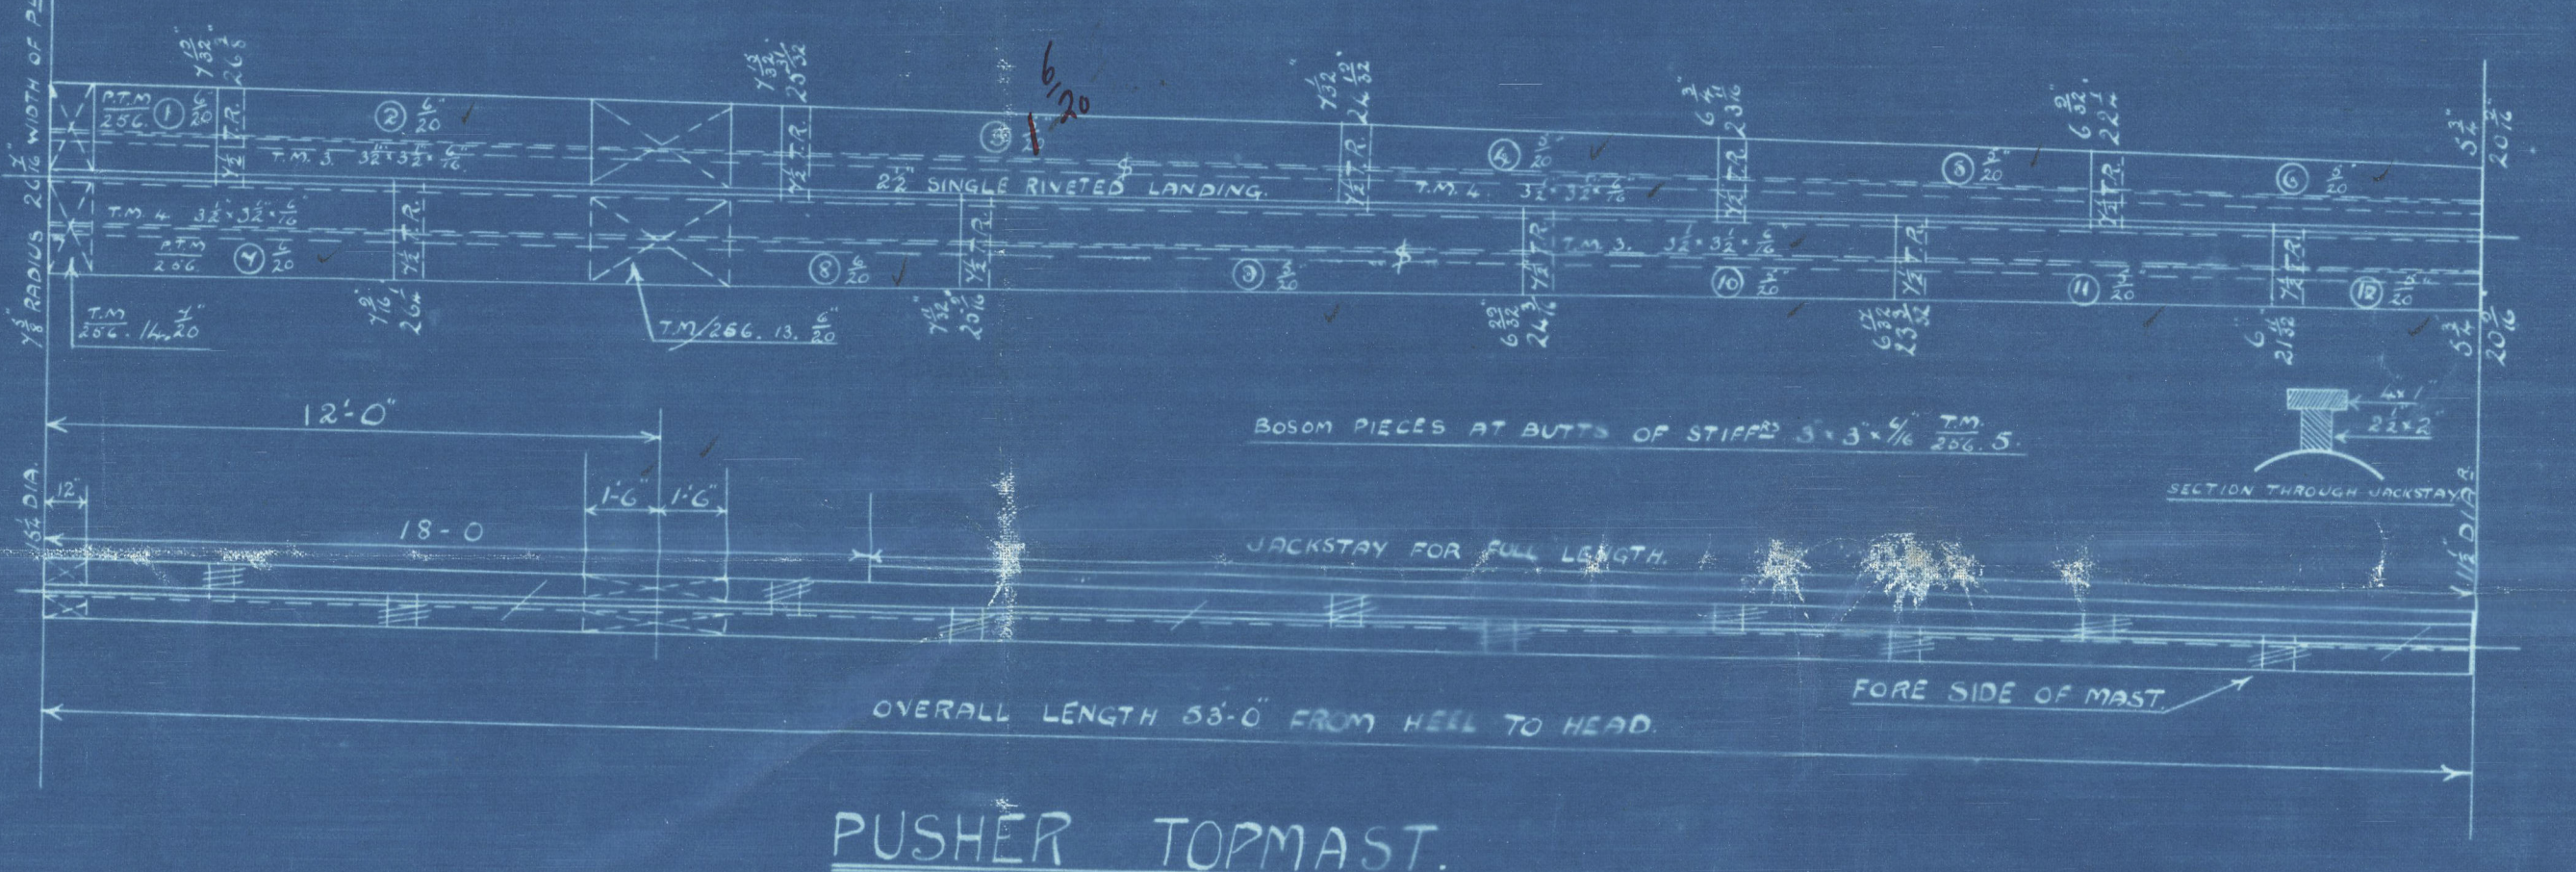
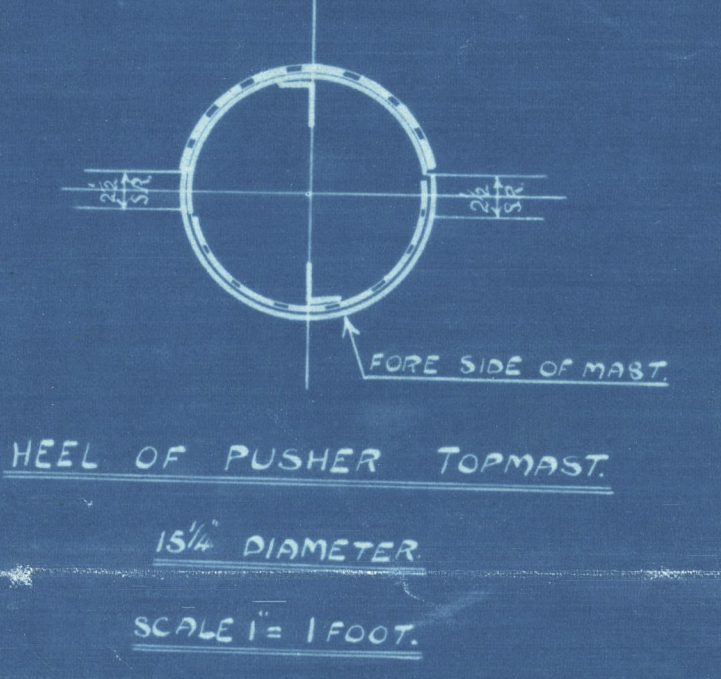
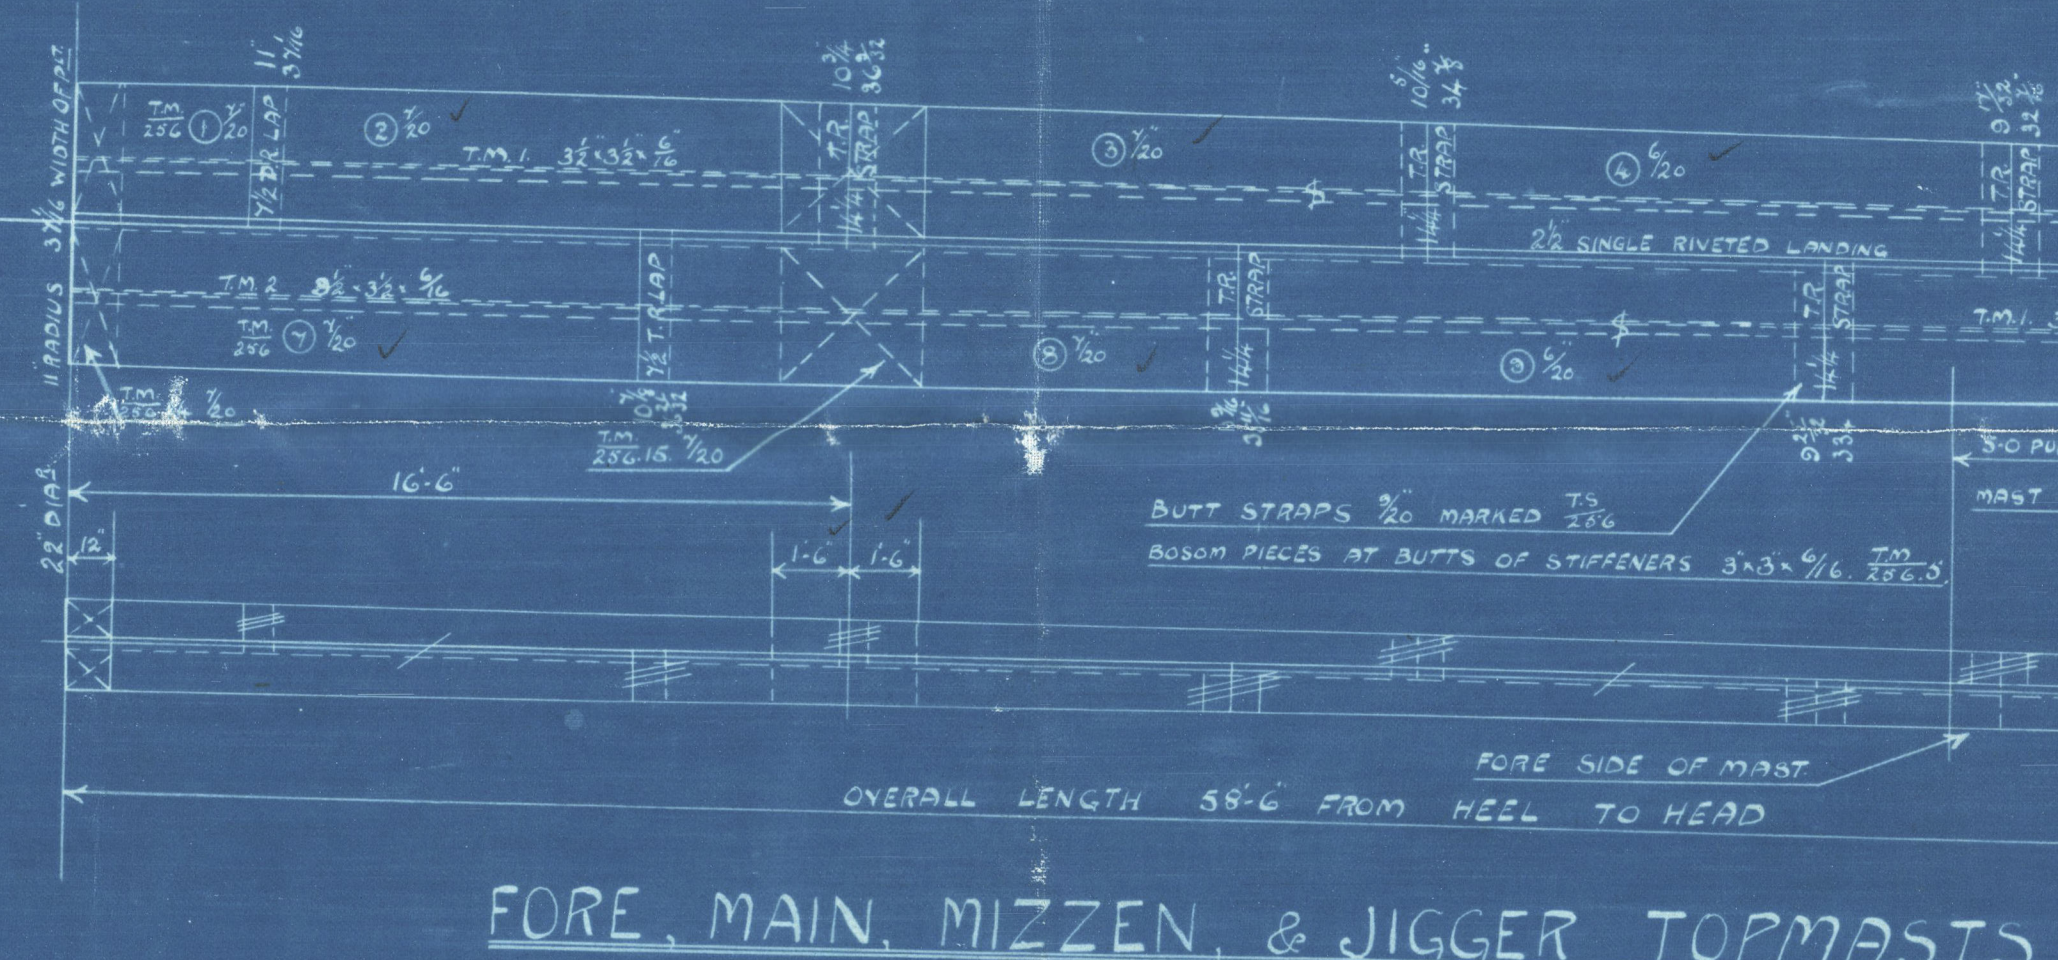
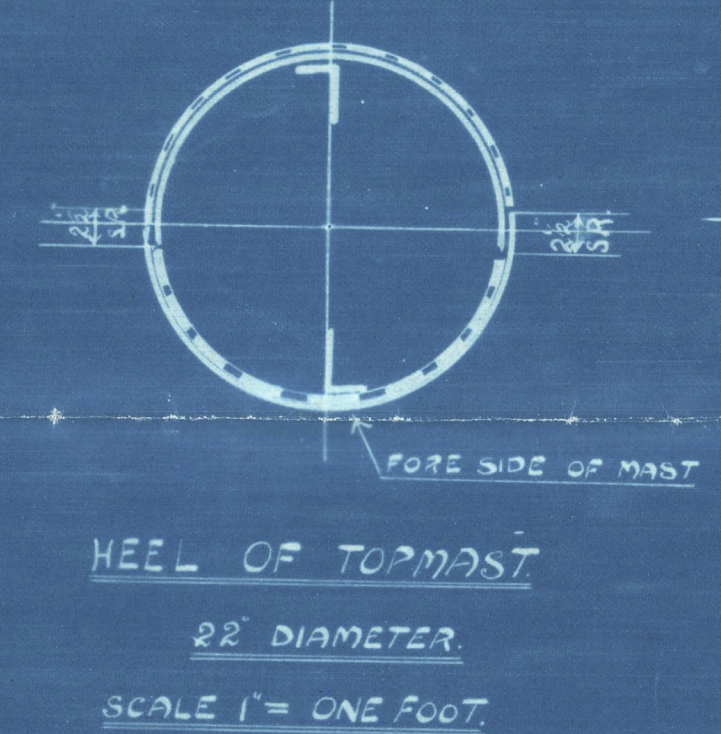
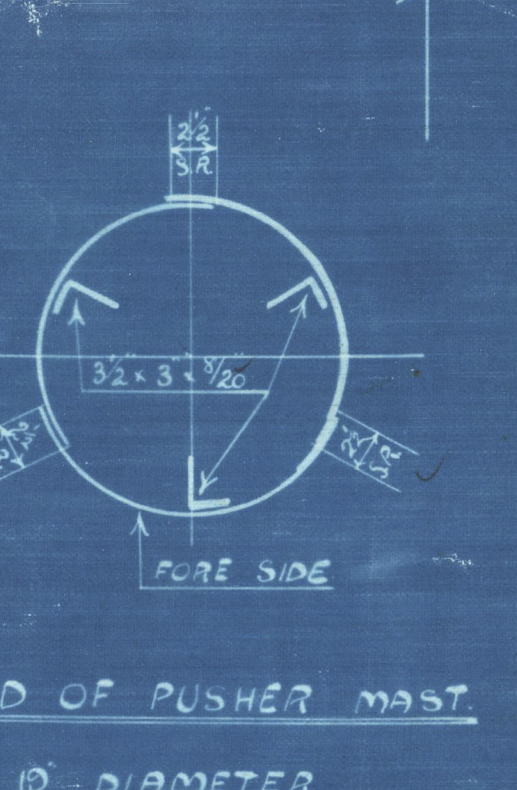
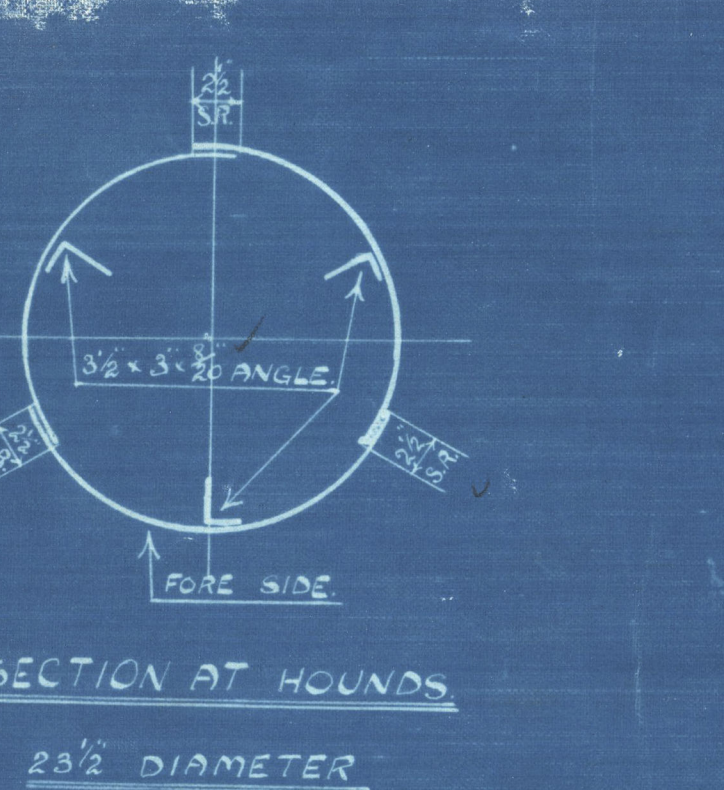
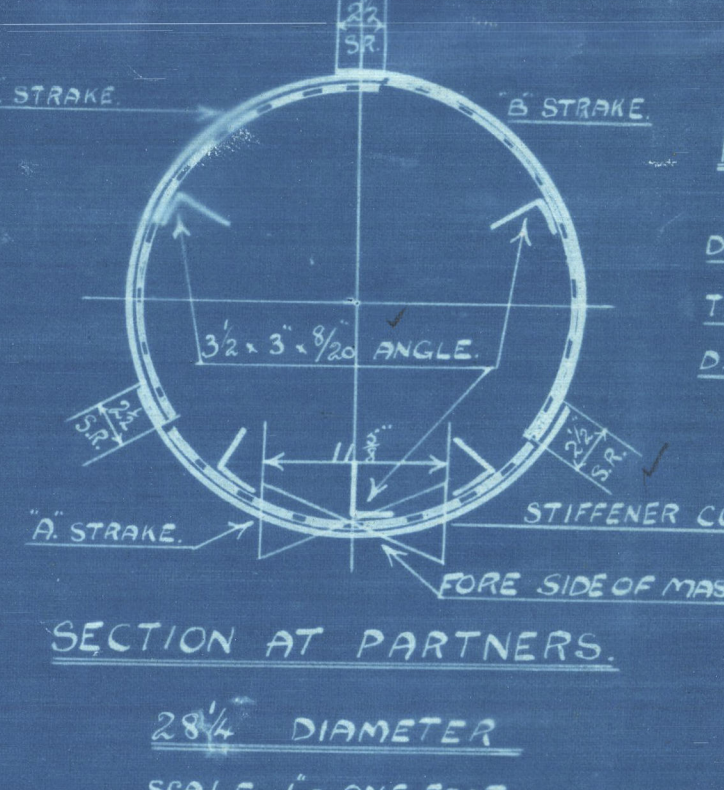
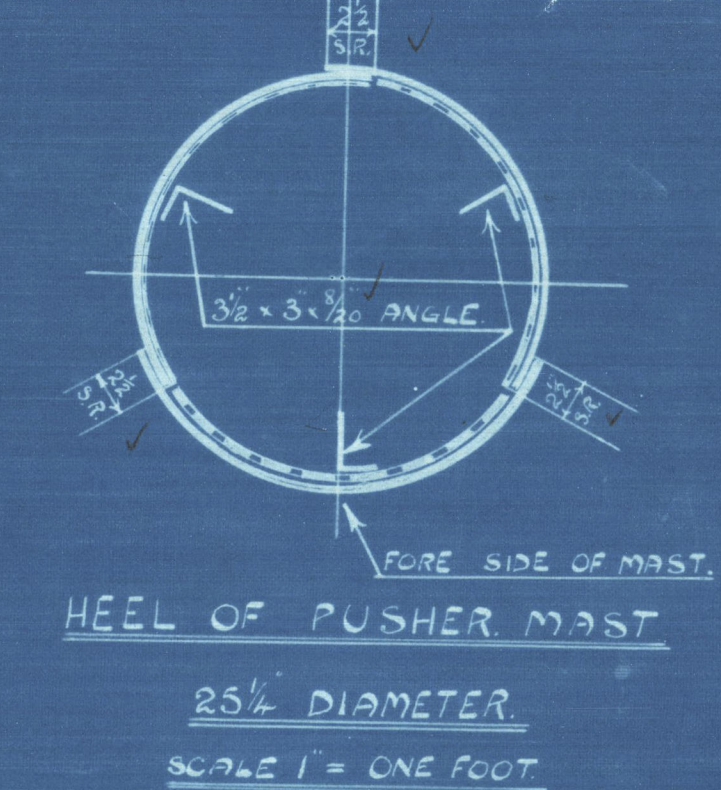


NOTE! FORE, MAIN, MIZZEN, & JIGGER LOWER MASTS
DIAMETERS ARE INCREASED 5/16" 1/8" ANYTING.
TR BUTT STRAPS 3/16" THICKER THAN PLATES THEY CONNECT.
DR

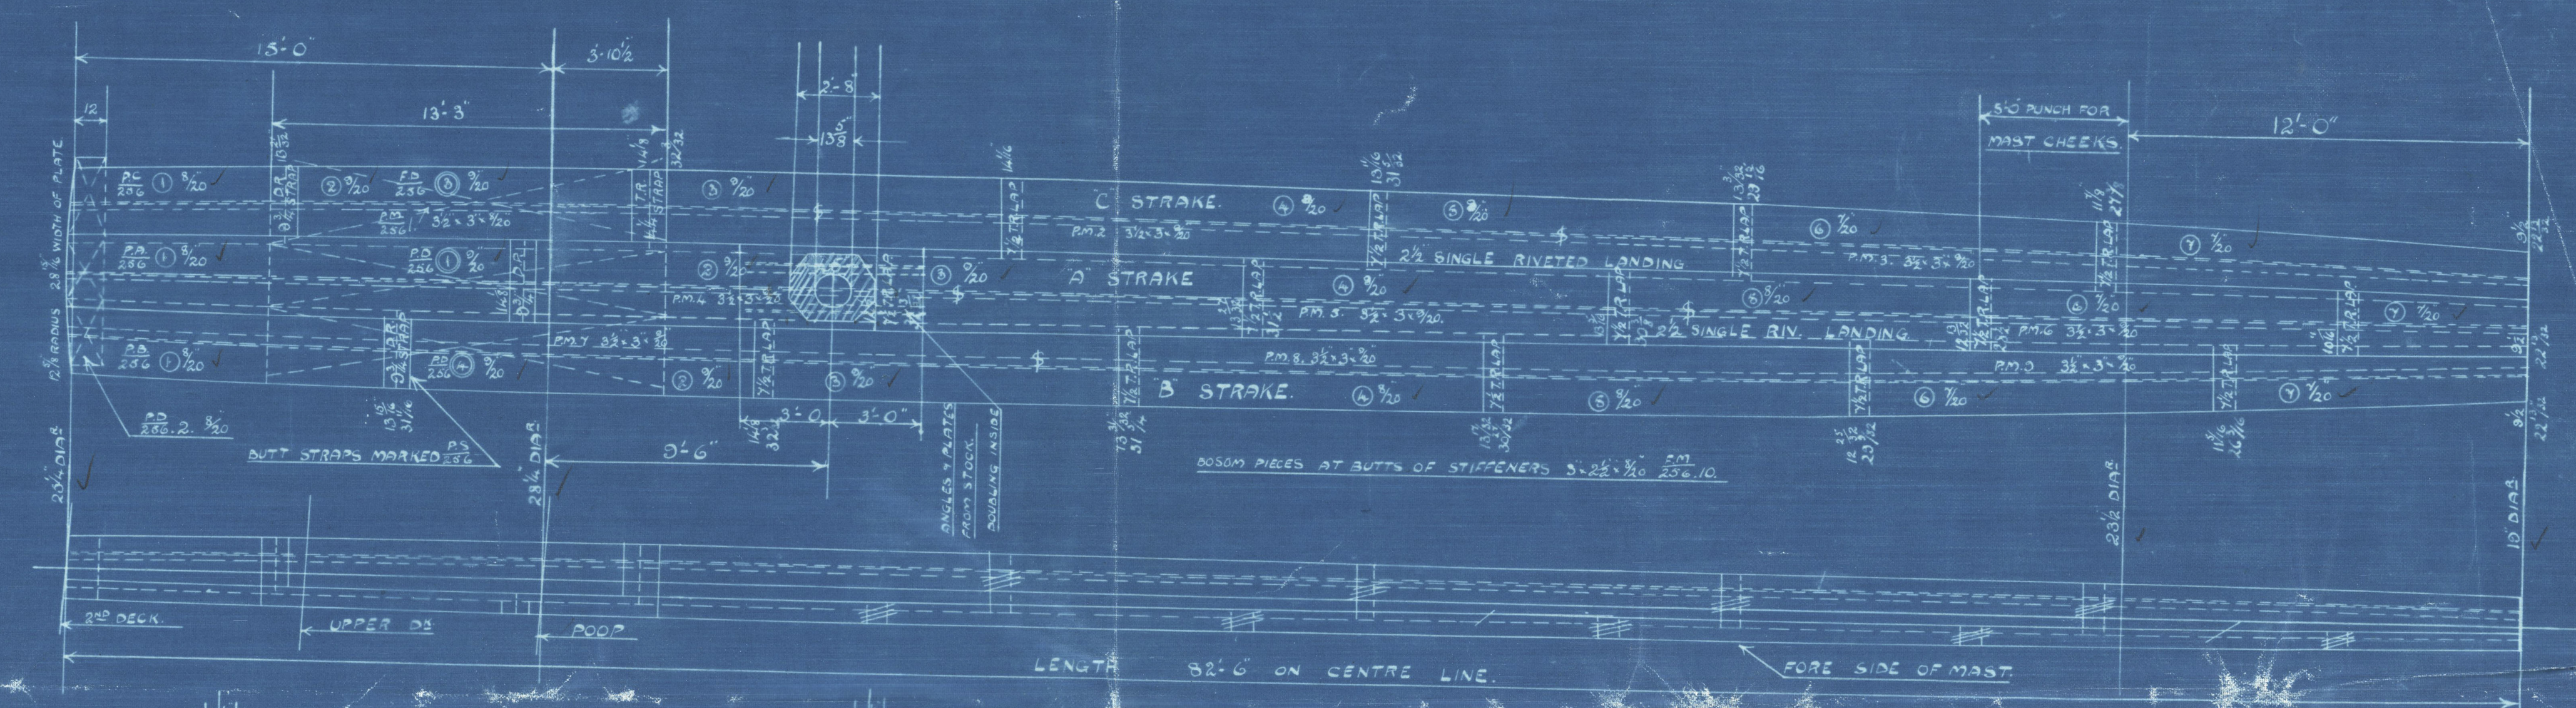

MAST PLAN
Nº256.
SCALE 1/4" = 1 FOOT.

APPROVED
LLOYDS REGISTER OF SHIPPING
8.12.19

No. 256

Mast Plan.

Messrs Ramage & Ferguson Ltd.,
Leith.

RETAIN

W631 - 0140



© 2021

Lloyd's Register
Foundation