
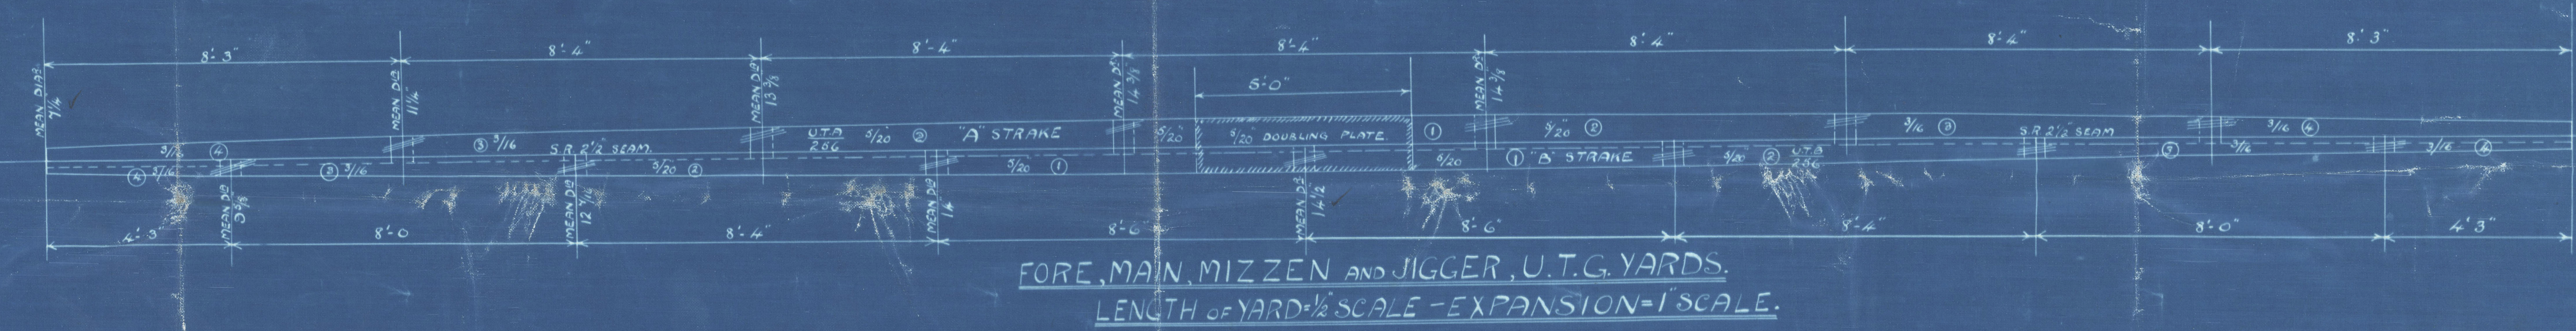
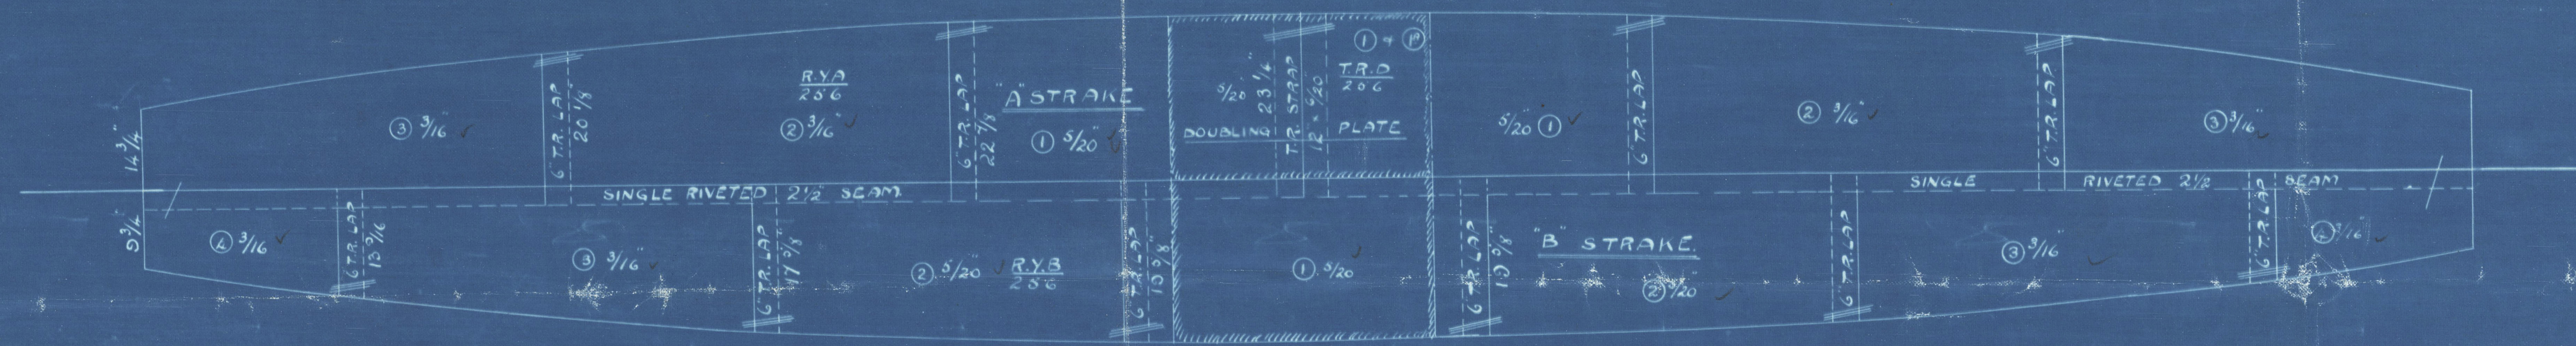
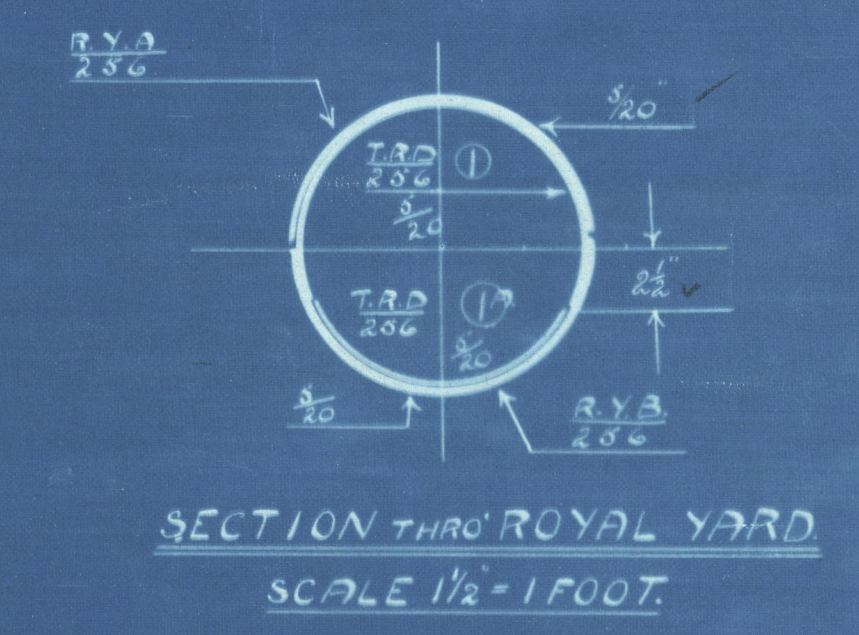
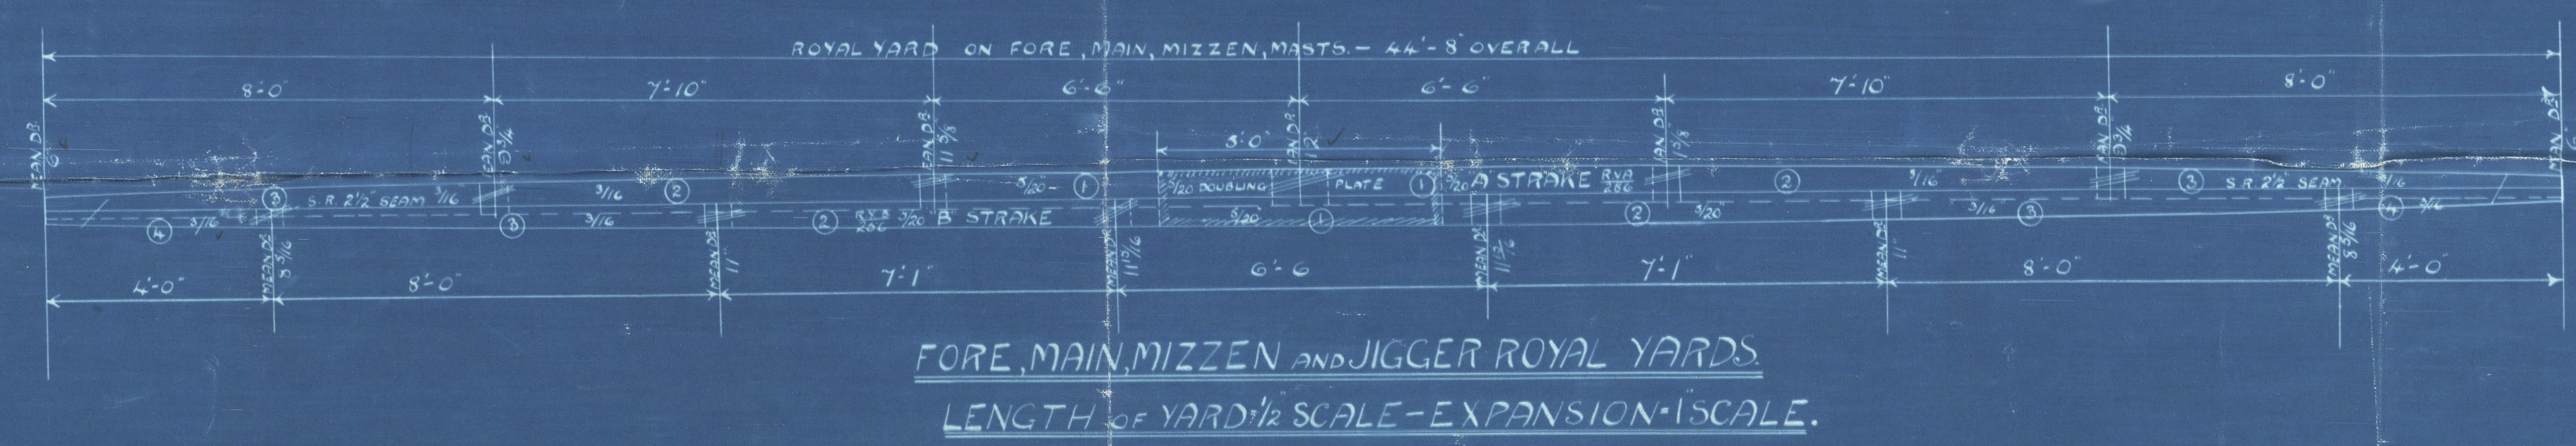




No 256.

PLAN OF T.C. MAST AND U.T.C.  
 AND ROYAL YARDS.

SCALES 1/2", 1" AND 1 1/2" = 1 FOOT.

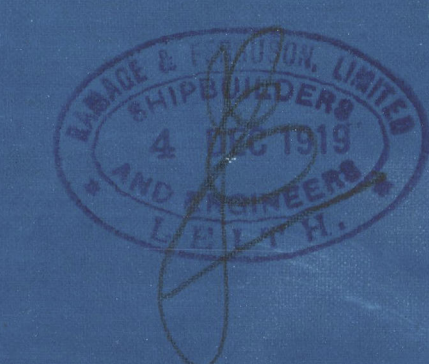

APPROVED  
 LLOYD'S REGISTER OF SHIPPING  
 7-12-19

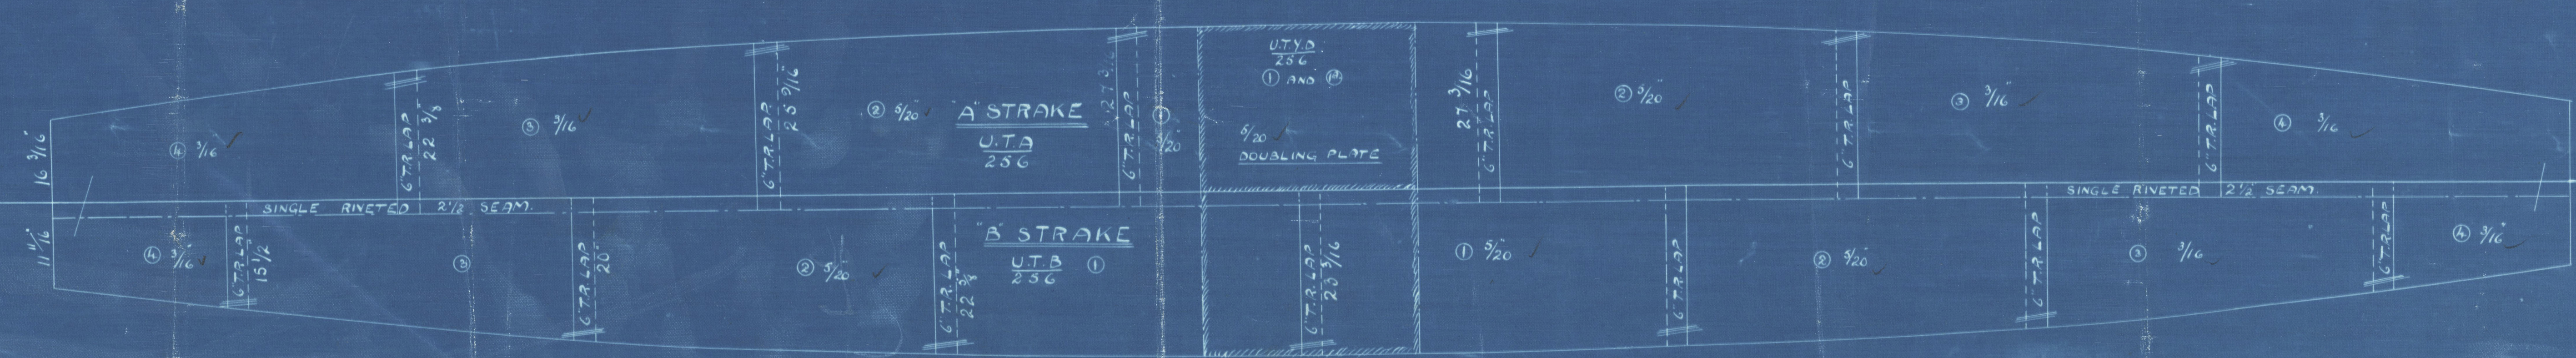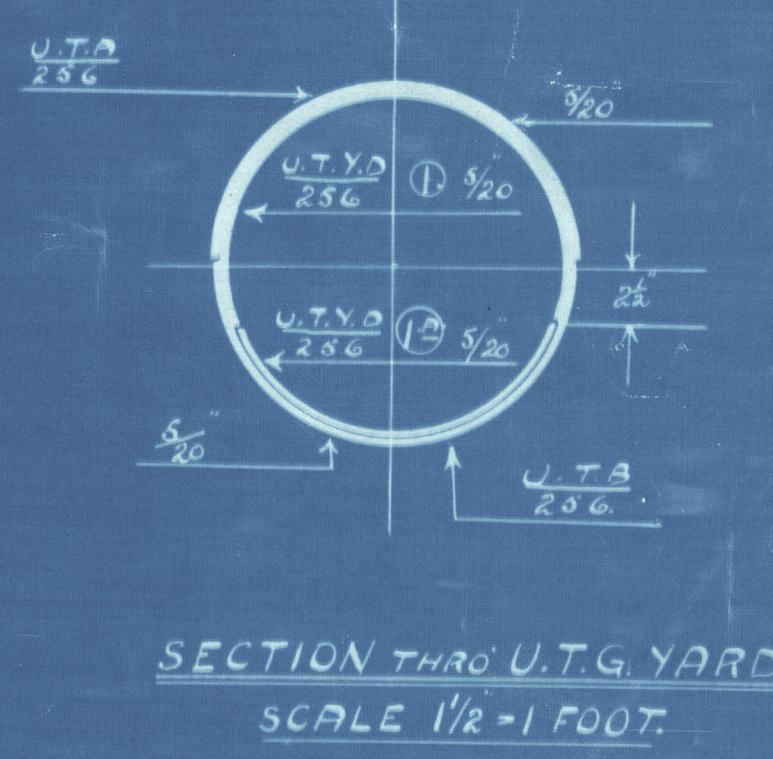



No 256

Topgallant Masts  
Upper Topgallant and  
Royal Yards

Mm. Ramage & Ferguson &  
Luth

RETAIN



© 2021

Lloyd's Register  
Foundation

W631-0142