


28.3.01  
 1.4.01 (N. 261)  
 17.5.01  
 8.7.01  
 16.8.01

# PROFILE

SCALE 1/8" = 1 FOOT

DIMENSIONS 400' x 52' x 32-1 1/2' D.M.

28.3.01  
 1.4.01 (N. 261)  
 17.5.01  
 8.7.01  
 16.8.01

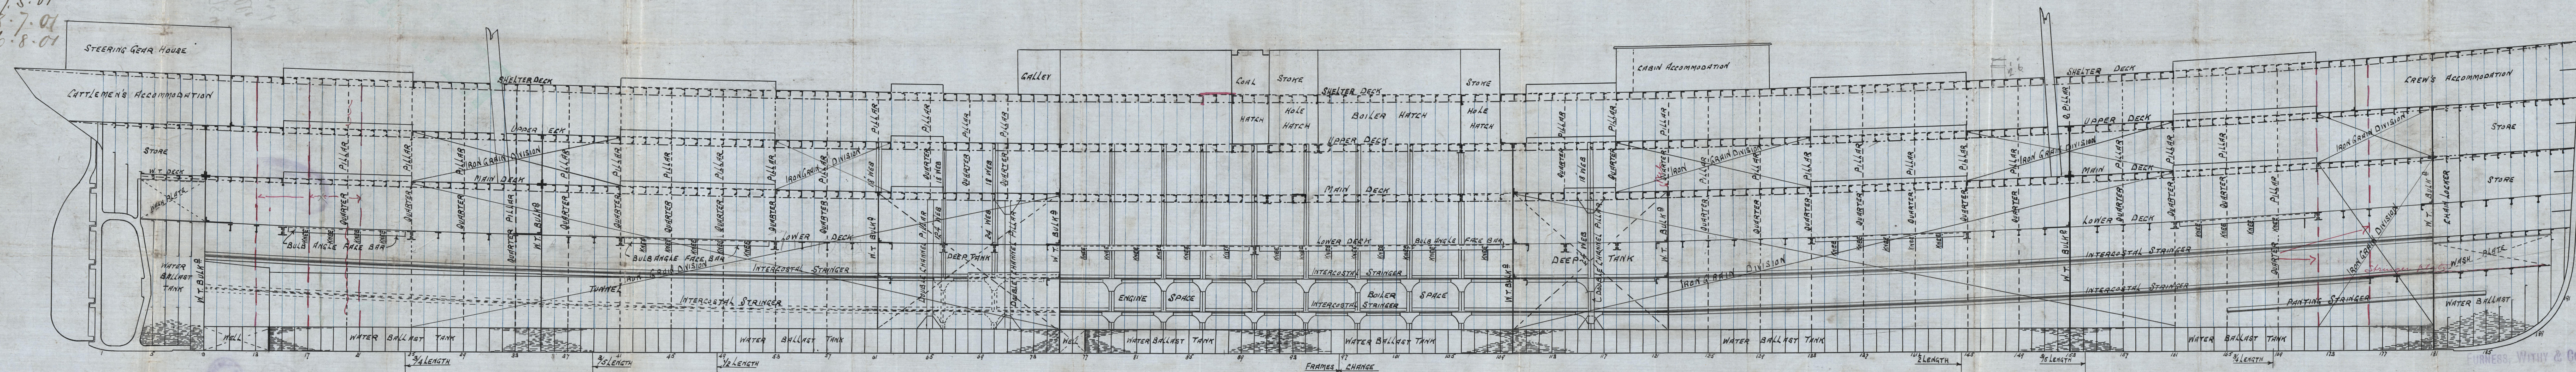

N<sup>o</sup> 260  
 Also N<sup>o</sup> 261  
 appd. 1/4/01.


Bottom forward to be strengthened in accordance with the amended  
 N<sup>o</sup> 260.  
 28/3/01



Furness with H<sup>2</sup>  
No. 260 + 261

Profile  
No. 11828  
No. 11784  
No. 11828

No. 110 "Stobley R"

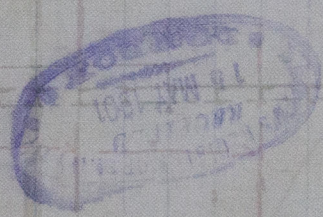

Lloyd's Register  
Foundation  
N631-0155