


— Scale. $\frac{1}{2}$ inch = one foot. —


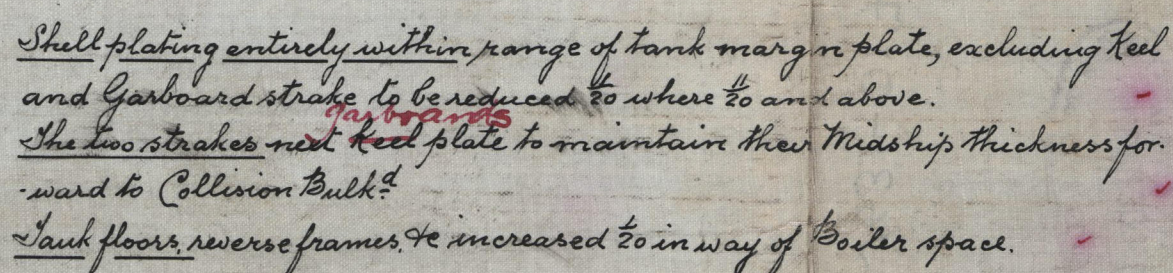

James Workman Clark & Co

SS No 191

Midship Section

Amended plan

Keemun

Bel. 5498

LONDON

LOYD'S REGISTER OF SHIPPING
RECEIVED
22 AUG. 1901
LONDON


ROYAL
NAVY
OFFICE
ADMIRALTY



LONDON

LOYD'S REGISTER OF SHIPPING
RECEIVED
21 FEB. 1902
LONDON

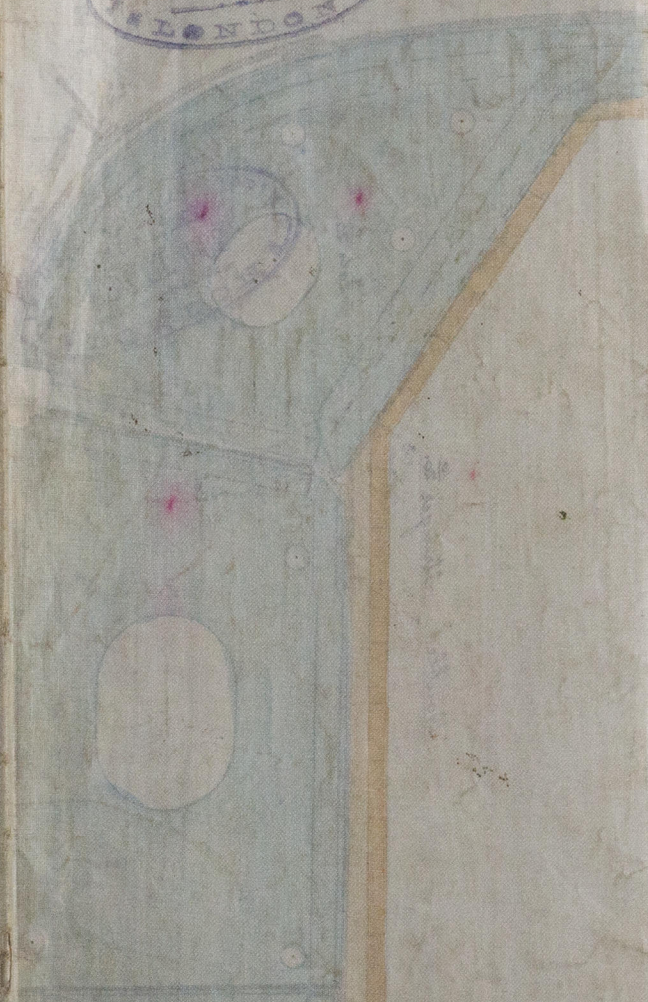

© 2021

Lloyd's Register
Foundation

W631-0176