


Handwritten notes in the top right corner, including "191 22" and "191 23".


Midship Deck Plating Plans No 191 I.S.S.
Scale 1/4" = one foot.

RETAIN

31. 11. 01
29. 11. 01

 

24/11/01
25/11/01

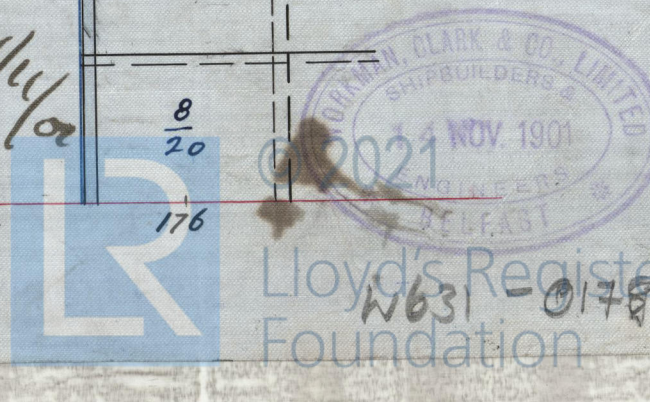

Messrs Workman Clark & Co

SS 191.

Plan of deck plating



Keelmen

Bel 5498

RETAIN



© 2021

Lloyd's Register

W631-0178 Foundation